THIS MAP WAS PREPARED FOR ASSESSMENT PURPOSE ONLY.

SW1/4 SE1/4 SEC.17 T.27S. R.5W. W.M. DOUGLAS COUNTY

1" = 100'

REVISED ON 4-2-14
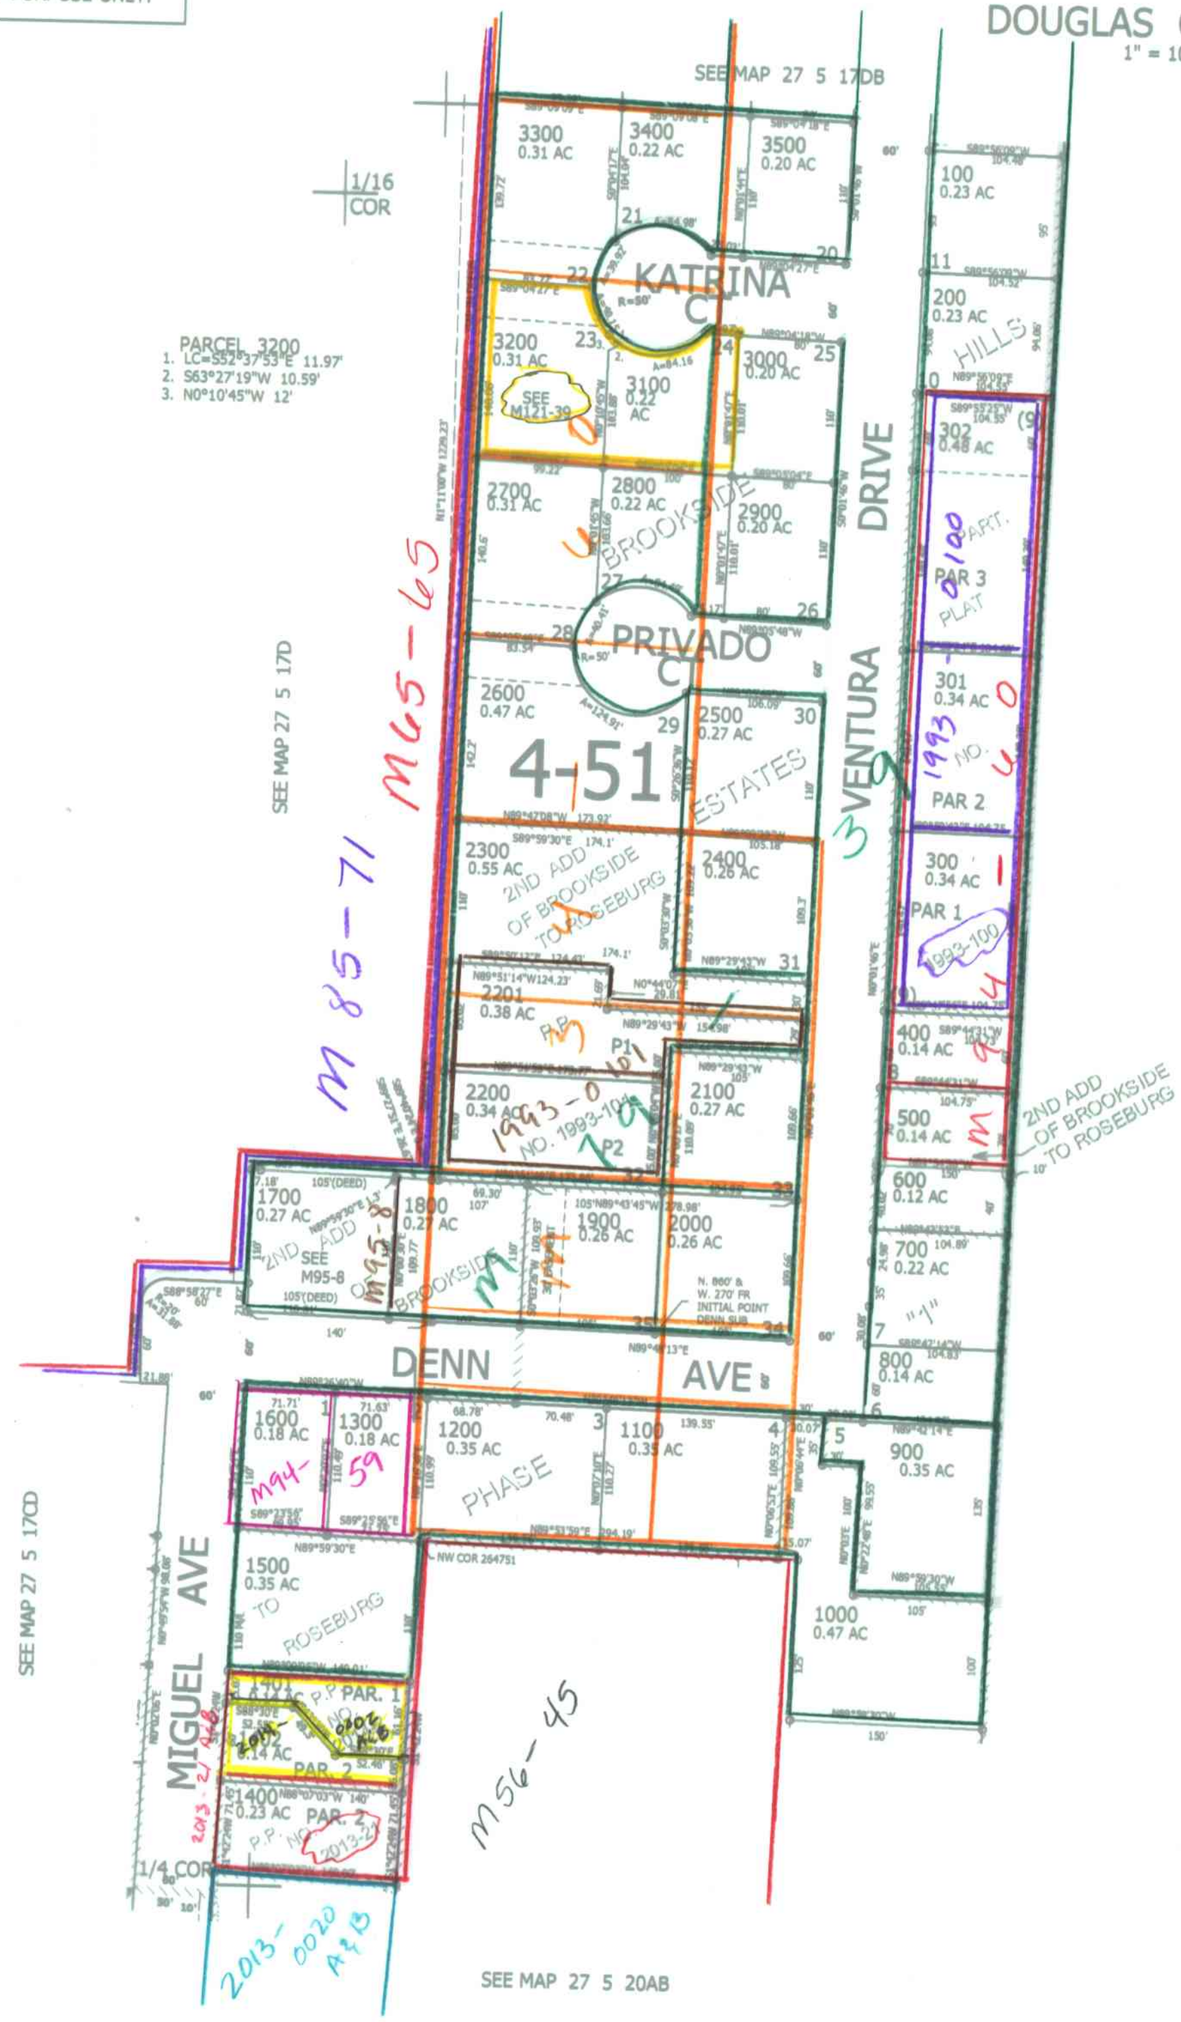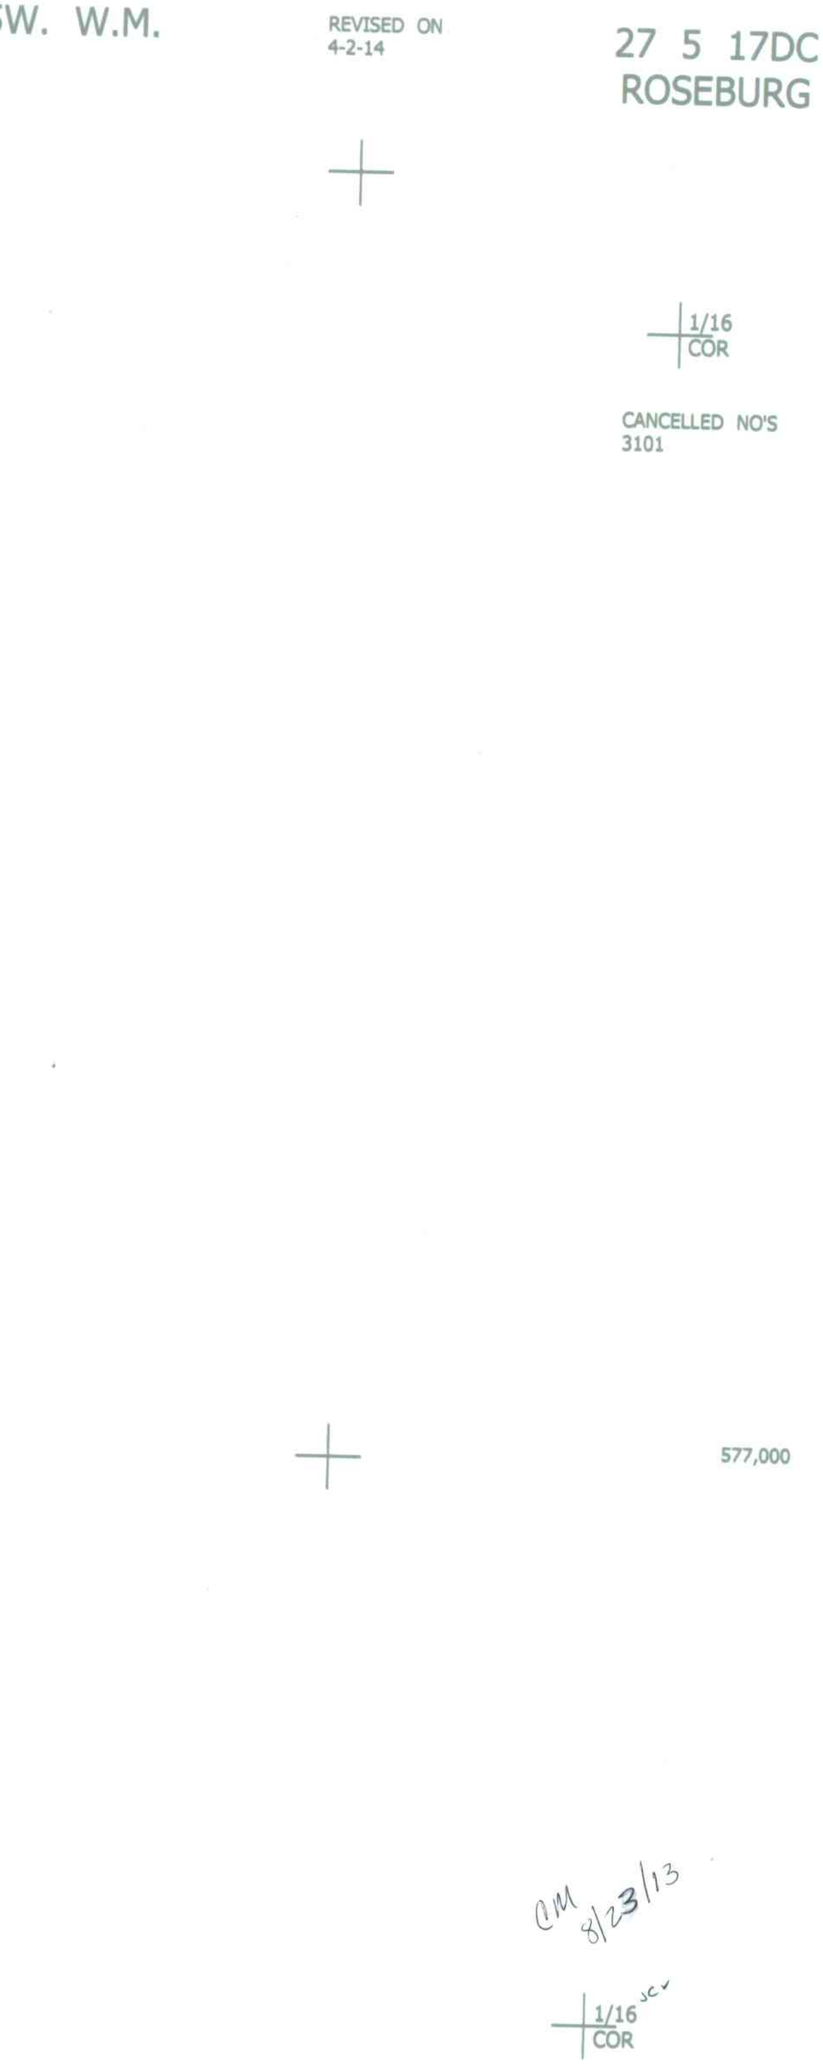
27 5 17DC ROSEBURG