THIS MAP WAS PREPARED FOR ASSESSMENT PURPOSE ONLY.

SW1/4 NE1/4 SEC.18 T.27S. R.5W. W.M.
DOUGLAS COUNTY
1" = 100'

REVISED ON 7-18-05

27 5 18AC
ROSEBURG

CANCELLED NO'S
5801
5401 4100
4101 4102
4103

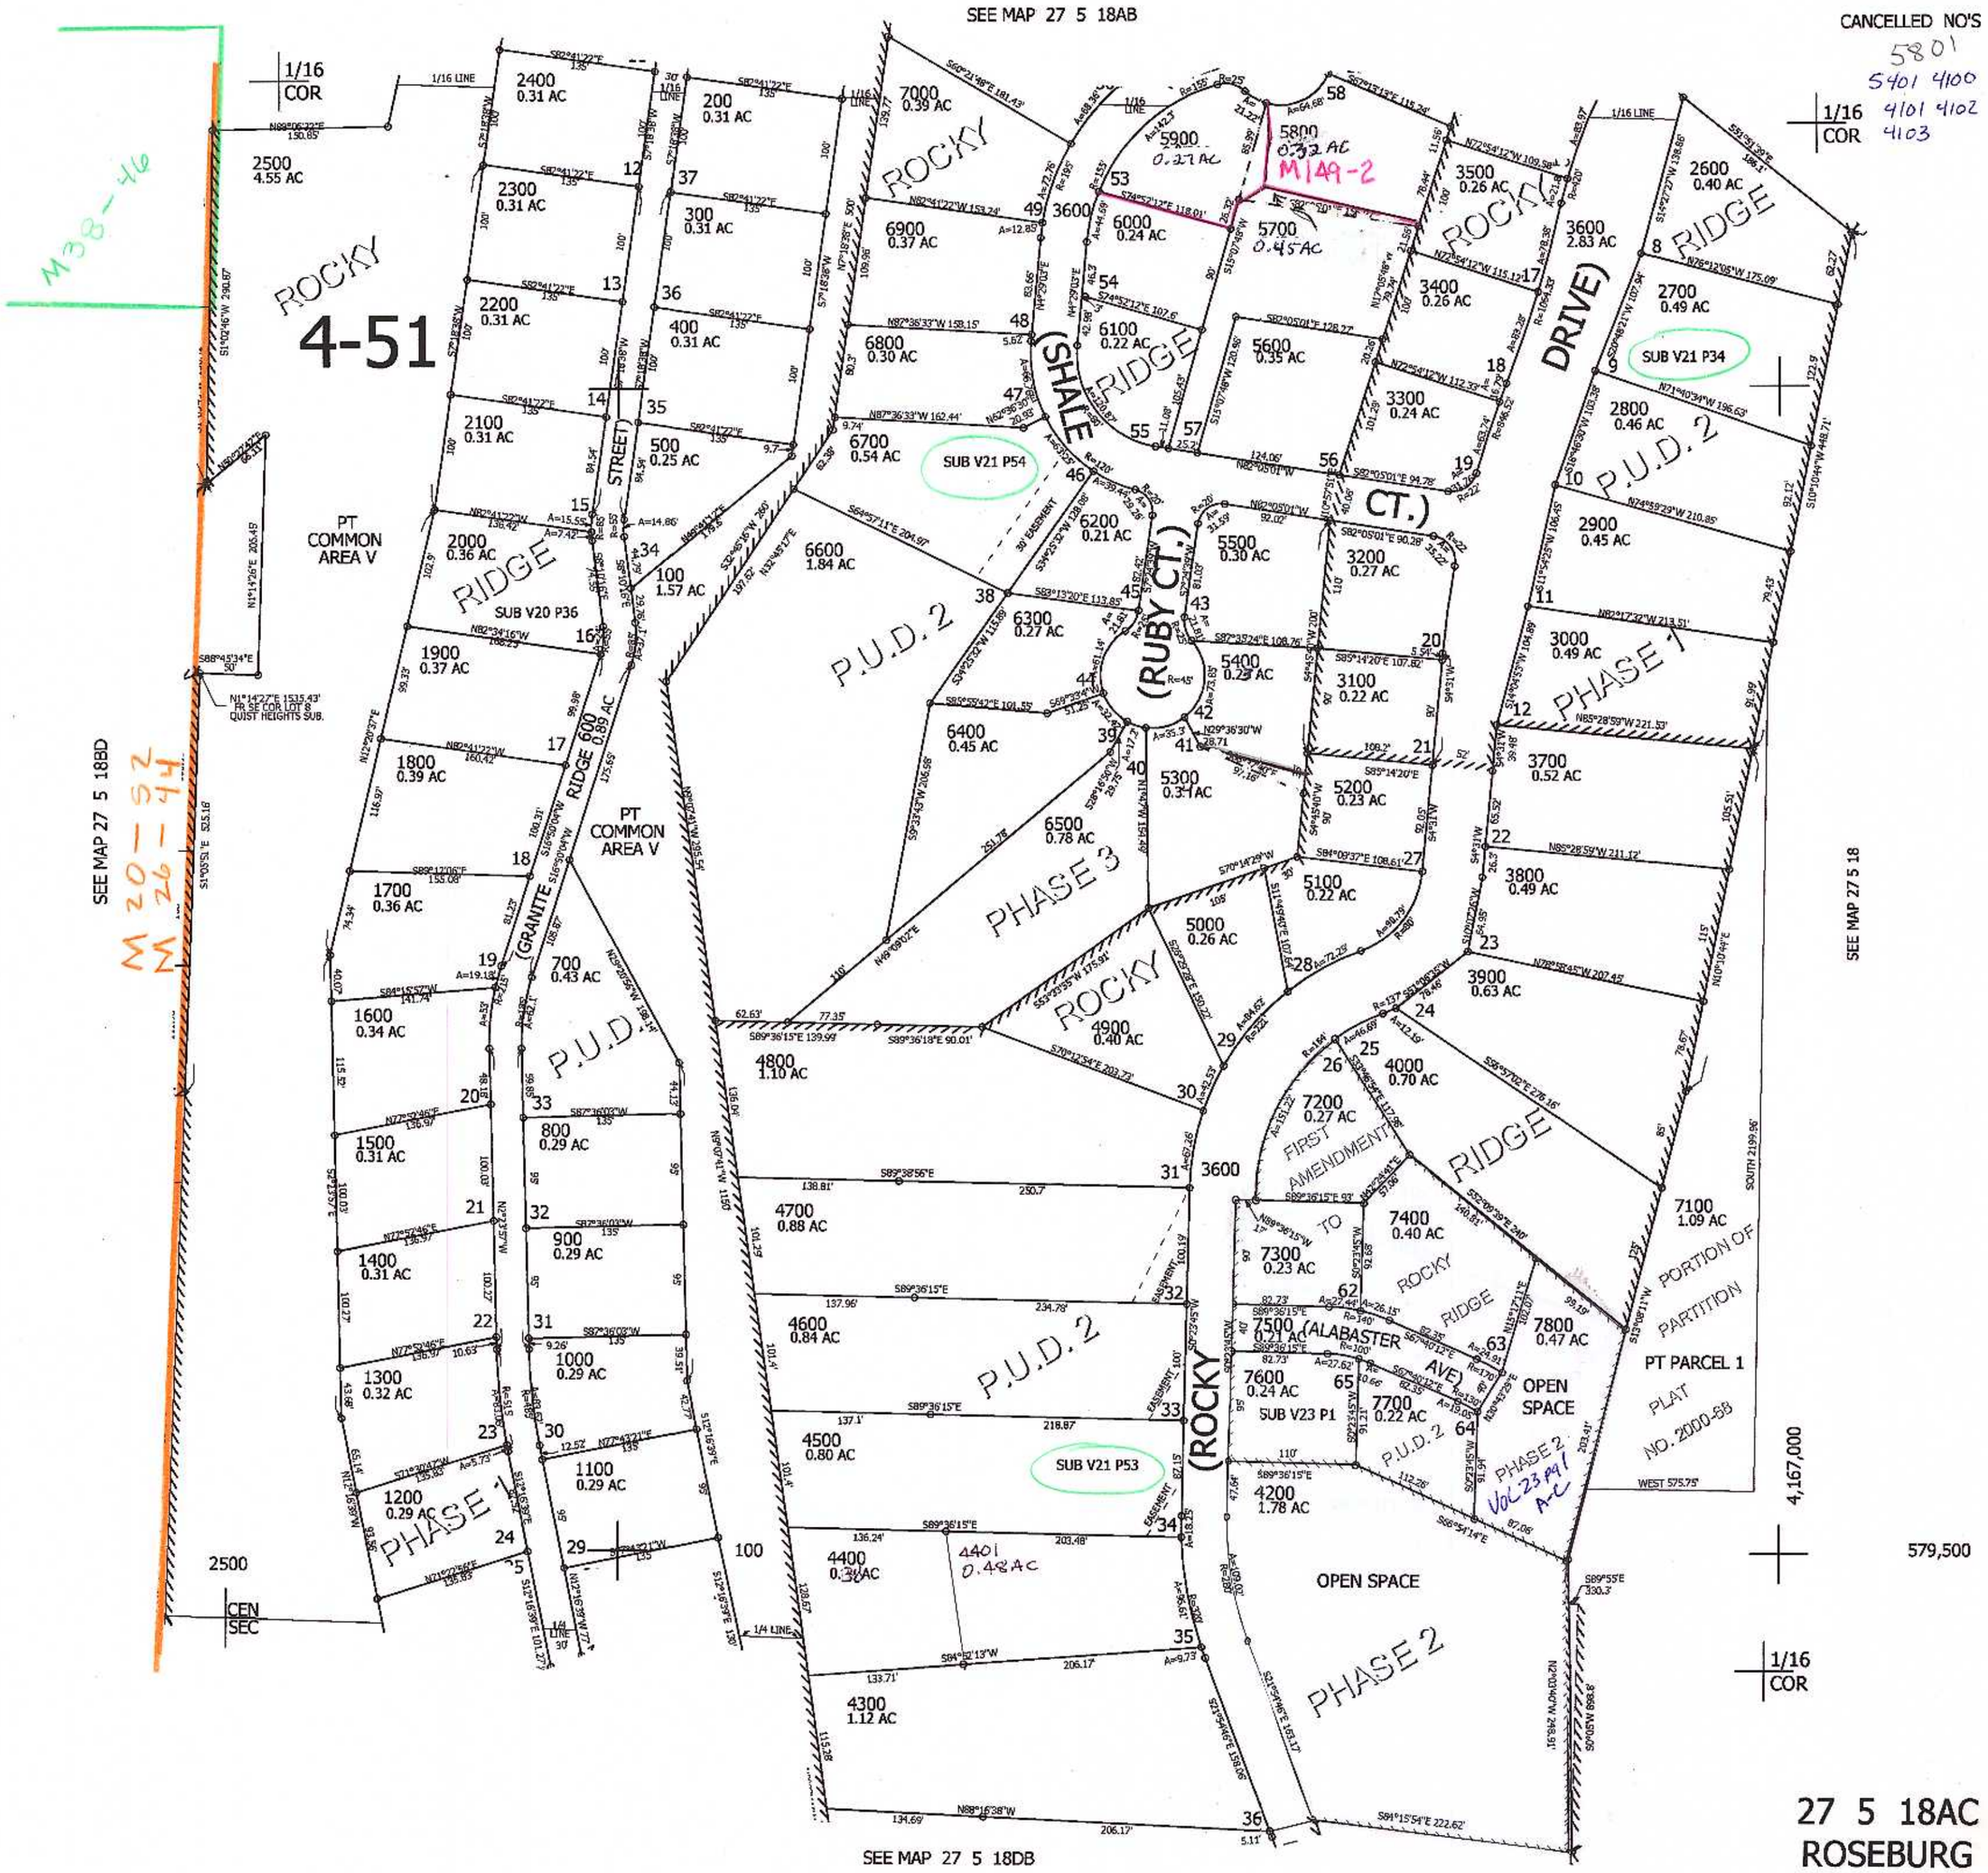

27 5 18AC
ROSEBURG