THIS MAP WAS PREPARED FOR ASSESSMENT PURPOSE ONLY.

NW1/4 SEC.18 T.27S. R.5W. W.M.
DOUGLAS COUNTY

1" = 200'

REVISED ON 12-17-13

27 5 18B & INDEX ROSEBURG

CANCELLED NO'S 101

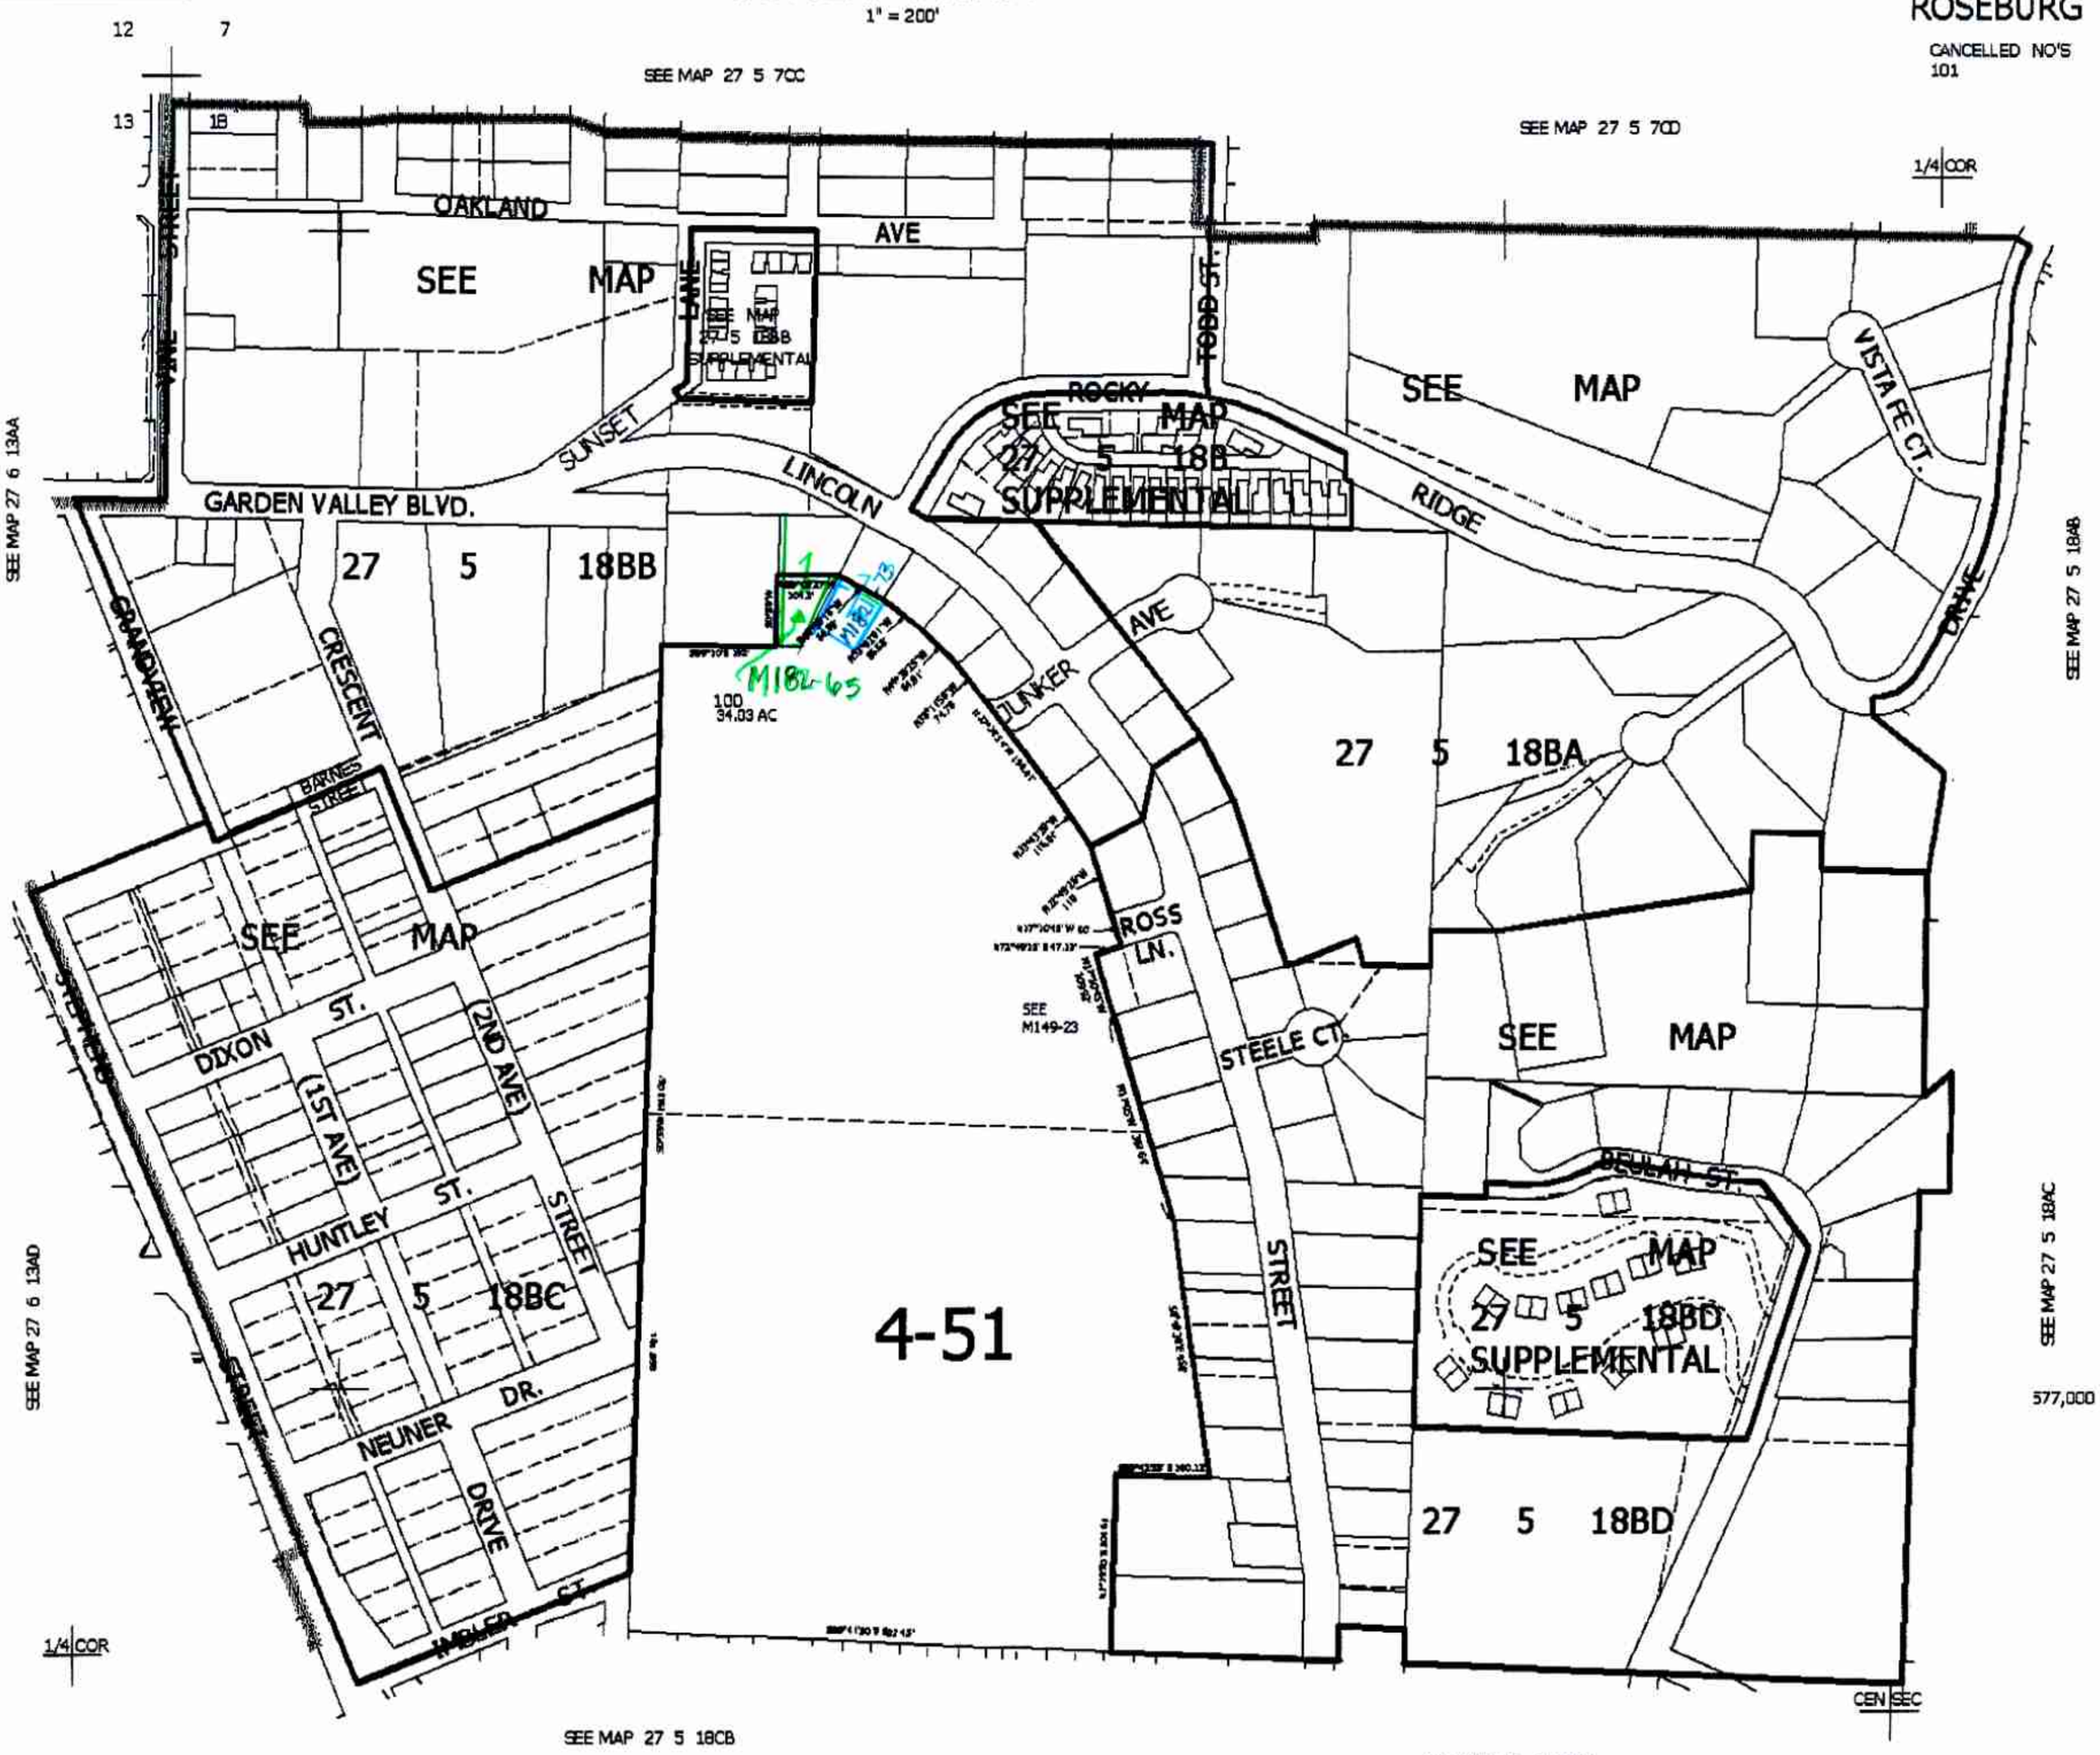

27 5 18B & INDEX ROSEBURG