


THIS MAP WAS PREPARED FOR  
ASSESSMENT PURPOSE ONLY.

NE1/4 NW1/4 SEC. 19 T.27S. R.5W. W.M.  
DOUGLAS COUNTY

1"=50'

27 5 19BA  
SUPPLEMENTAL MAP  
ROSEBURG

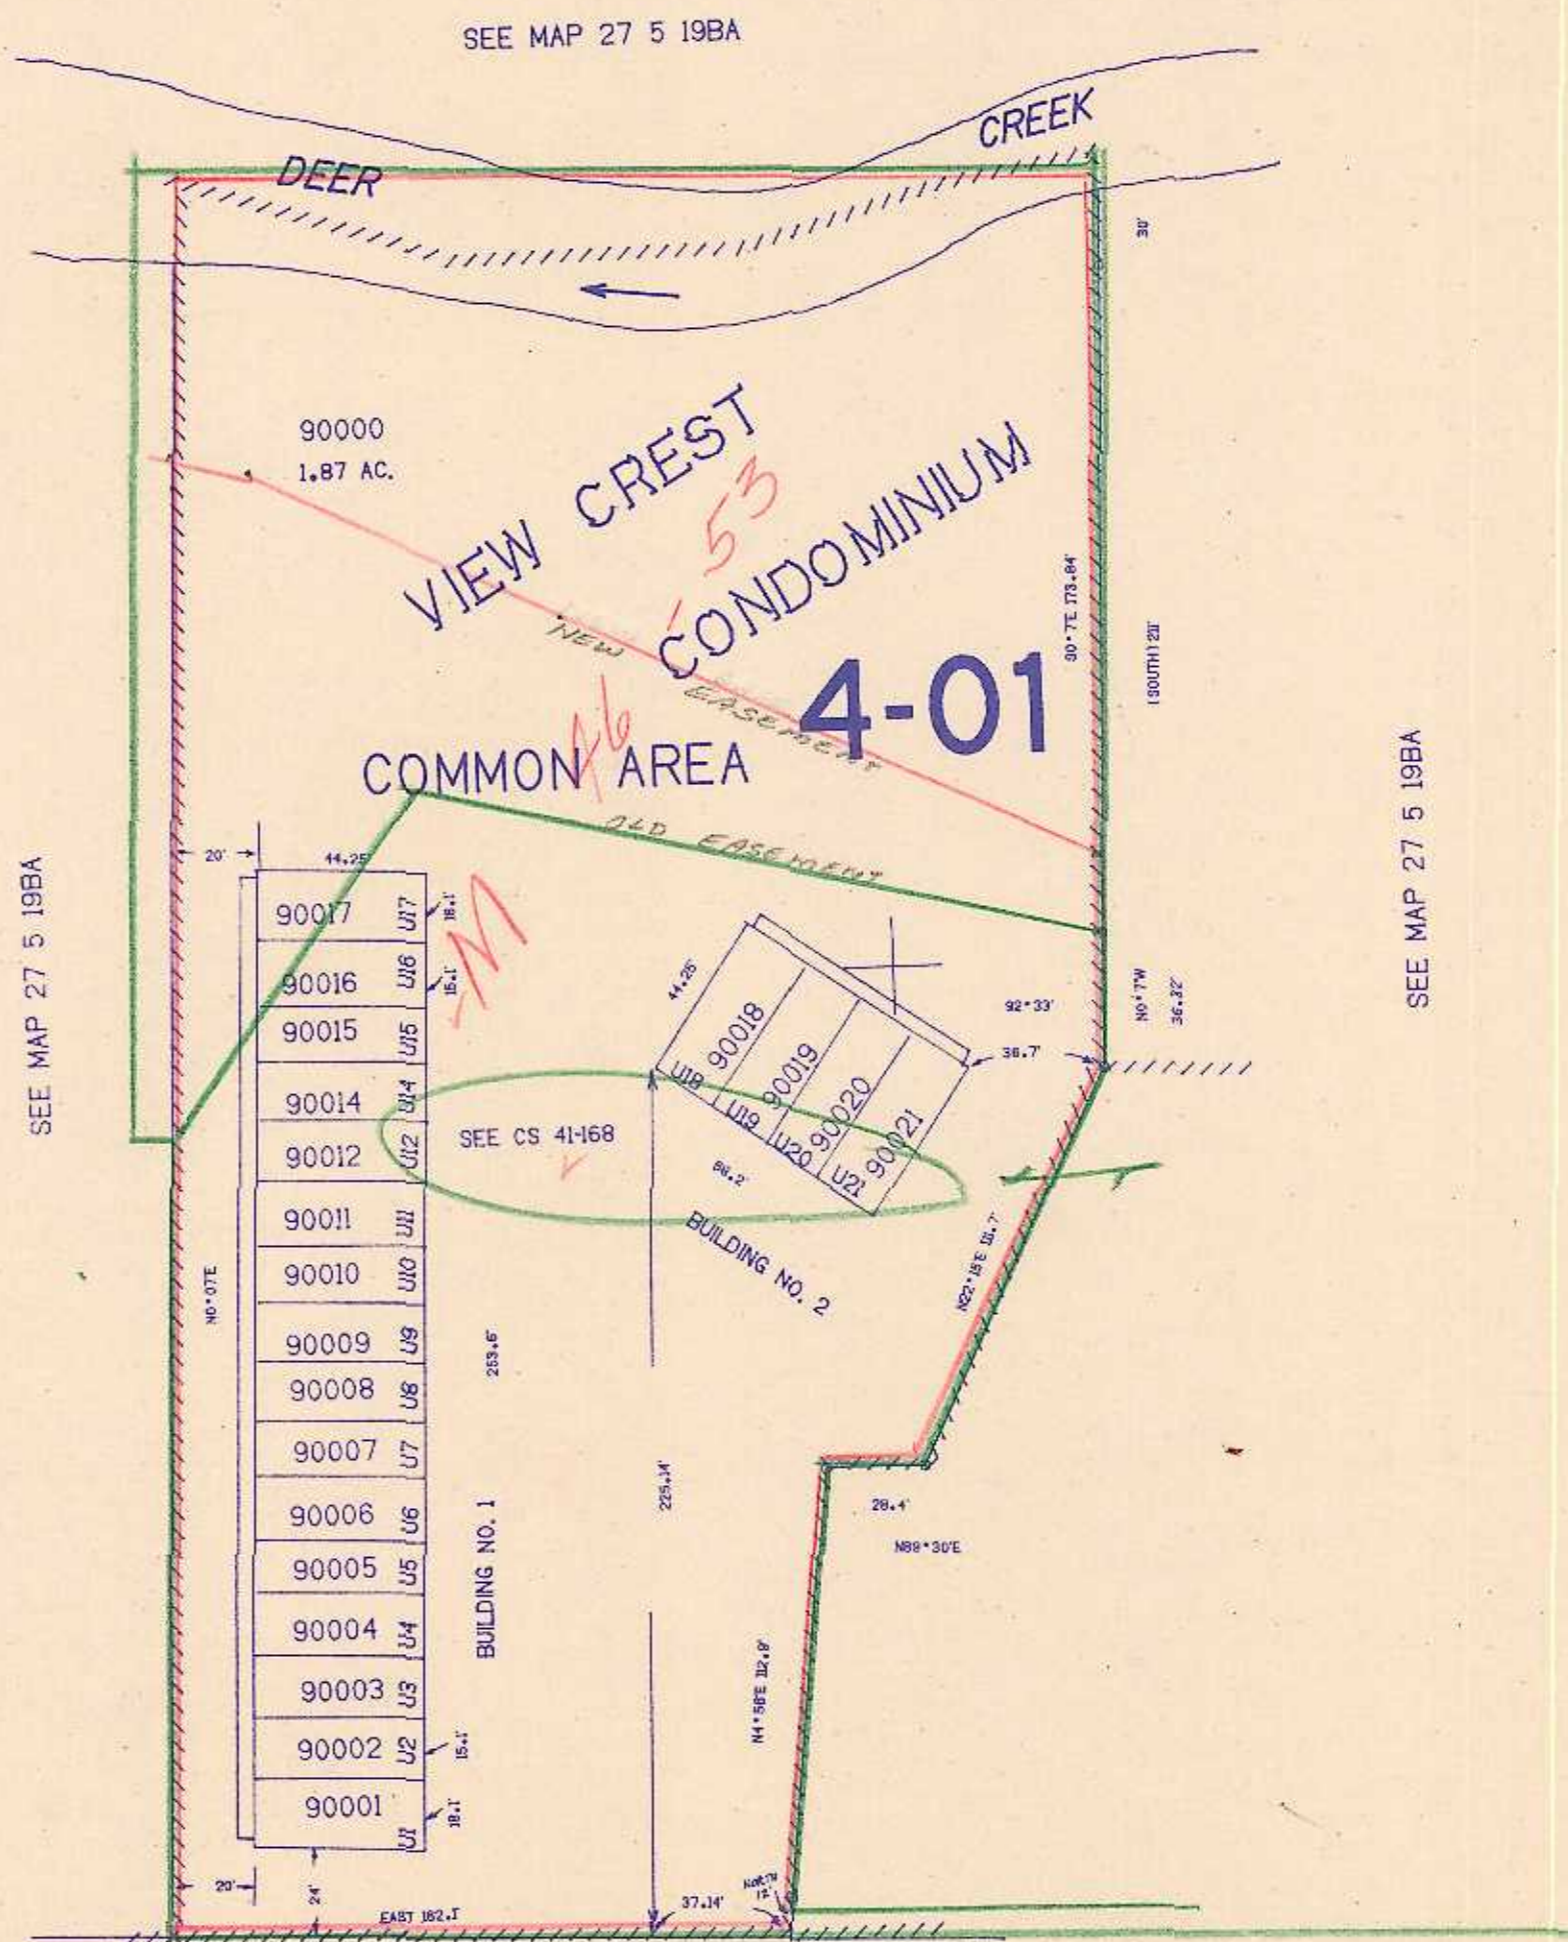

576.000

COURT

SEE MAP 27 5 19BA

ELLA

ST.

1.244,000

27 5 19BA  
SUPPLEMENTAL MAP  
ROSEBURG

CONTROL LAYOUT TRACED CHECKED