

THIS MAP WAS PREPARED FOR ASSESSMENT PURPOSE ONLY

Upper Left:  
123°19'52"W 43°17'59"N  
4166788E 577524N FT


SEC.20 T.27S. R.05W. W.M.  
DOUGLAS COUNTY  
1" = 400'

Date Exported 2025-01-07



270520  
& INDEX  
Roseburg

CANCELLED NOS:  
100A1 202 999

- PARCEL 103
- 1. 080°57'50"E 13.35'
- 2. LC=886°24'13"E 42.4'
- 3. N01°41'17"E 13.50'
- 4. N08°40'55"E 86.03'
- 5. S84°07'27"W 10.00'
- 6. S71°43'57"W 66.00'
- 7. N04°07'27"W 105.37'
- 8. S1°52'17"W 206.39'
- 9. N02°54'02"W 127.30'
- 10. N07°52'30"E 210.37'
- 11. N08°52'30"E 152.87'
- 12. N2°04'27"E 15.45'

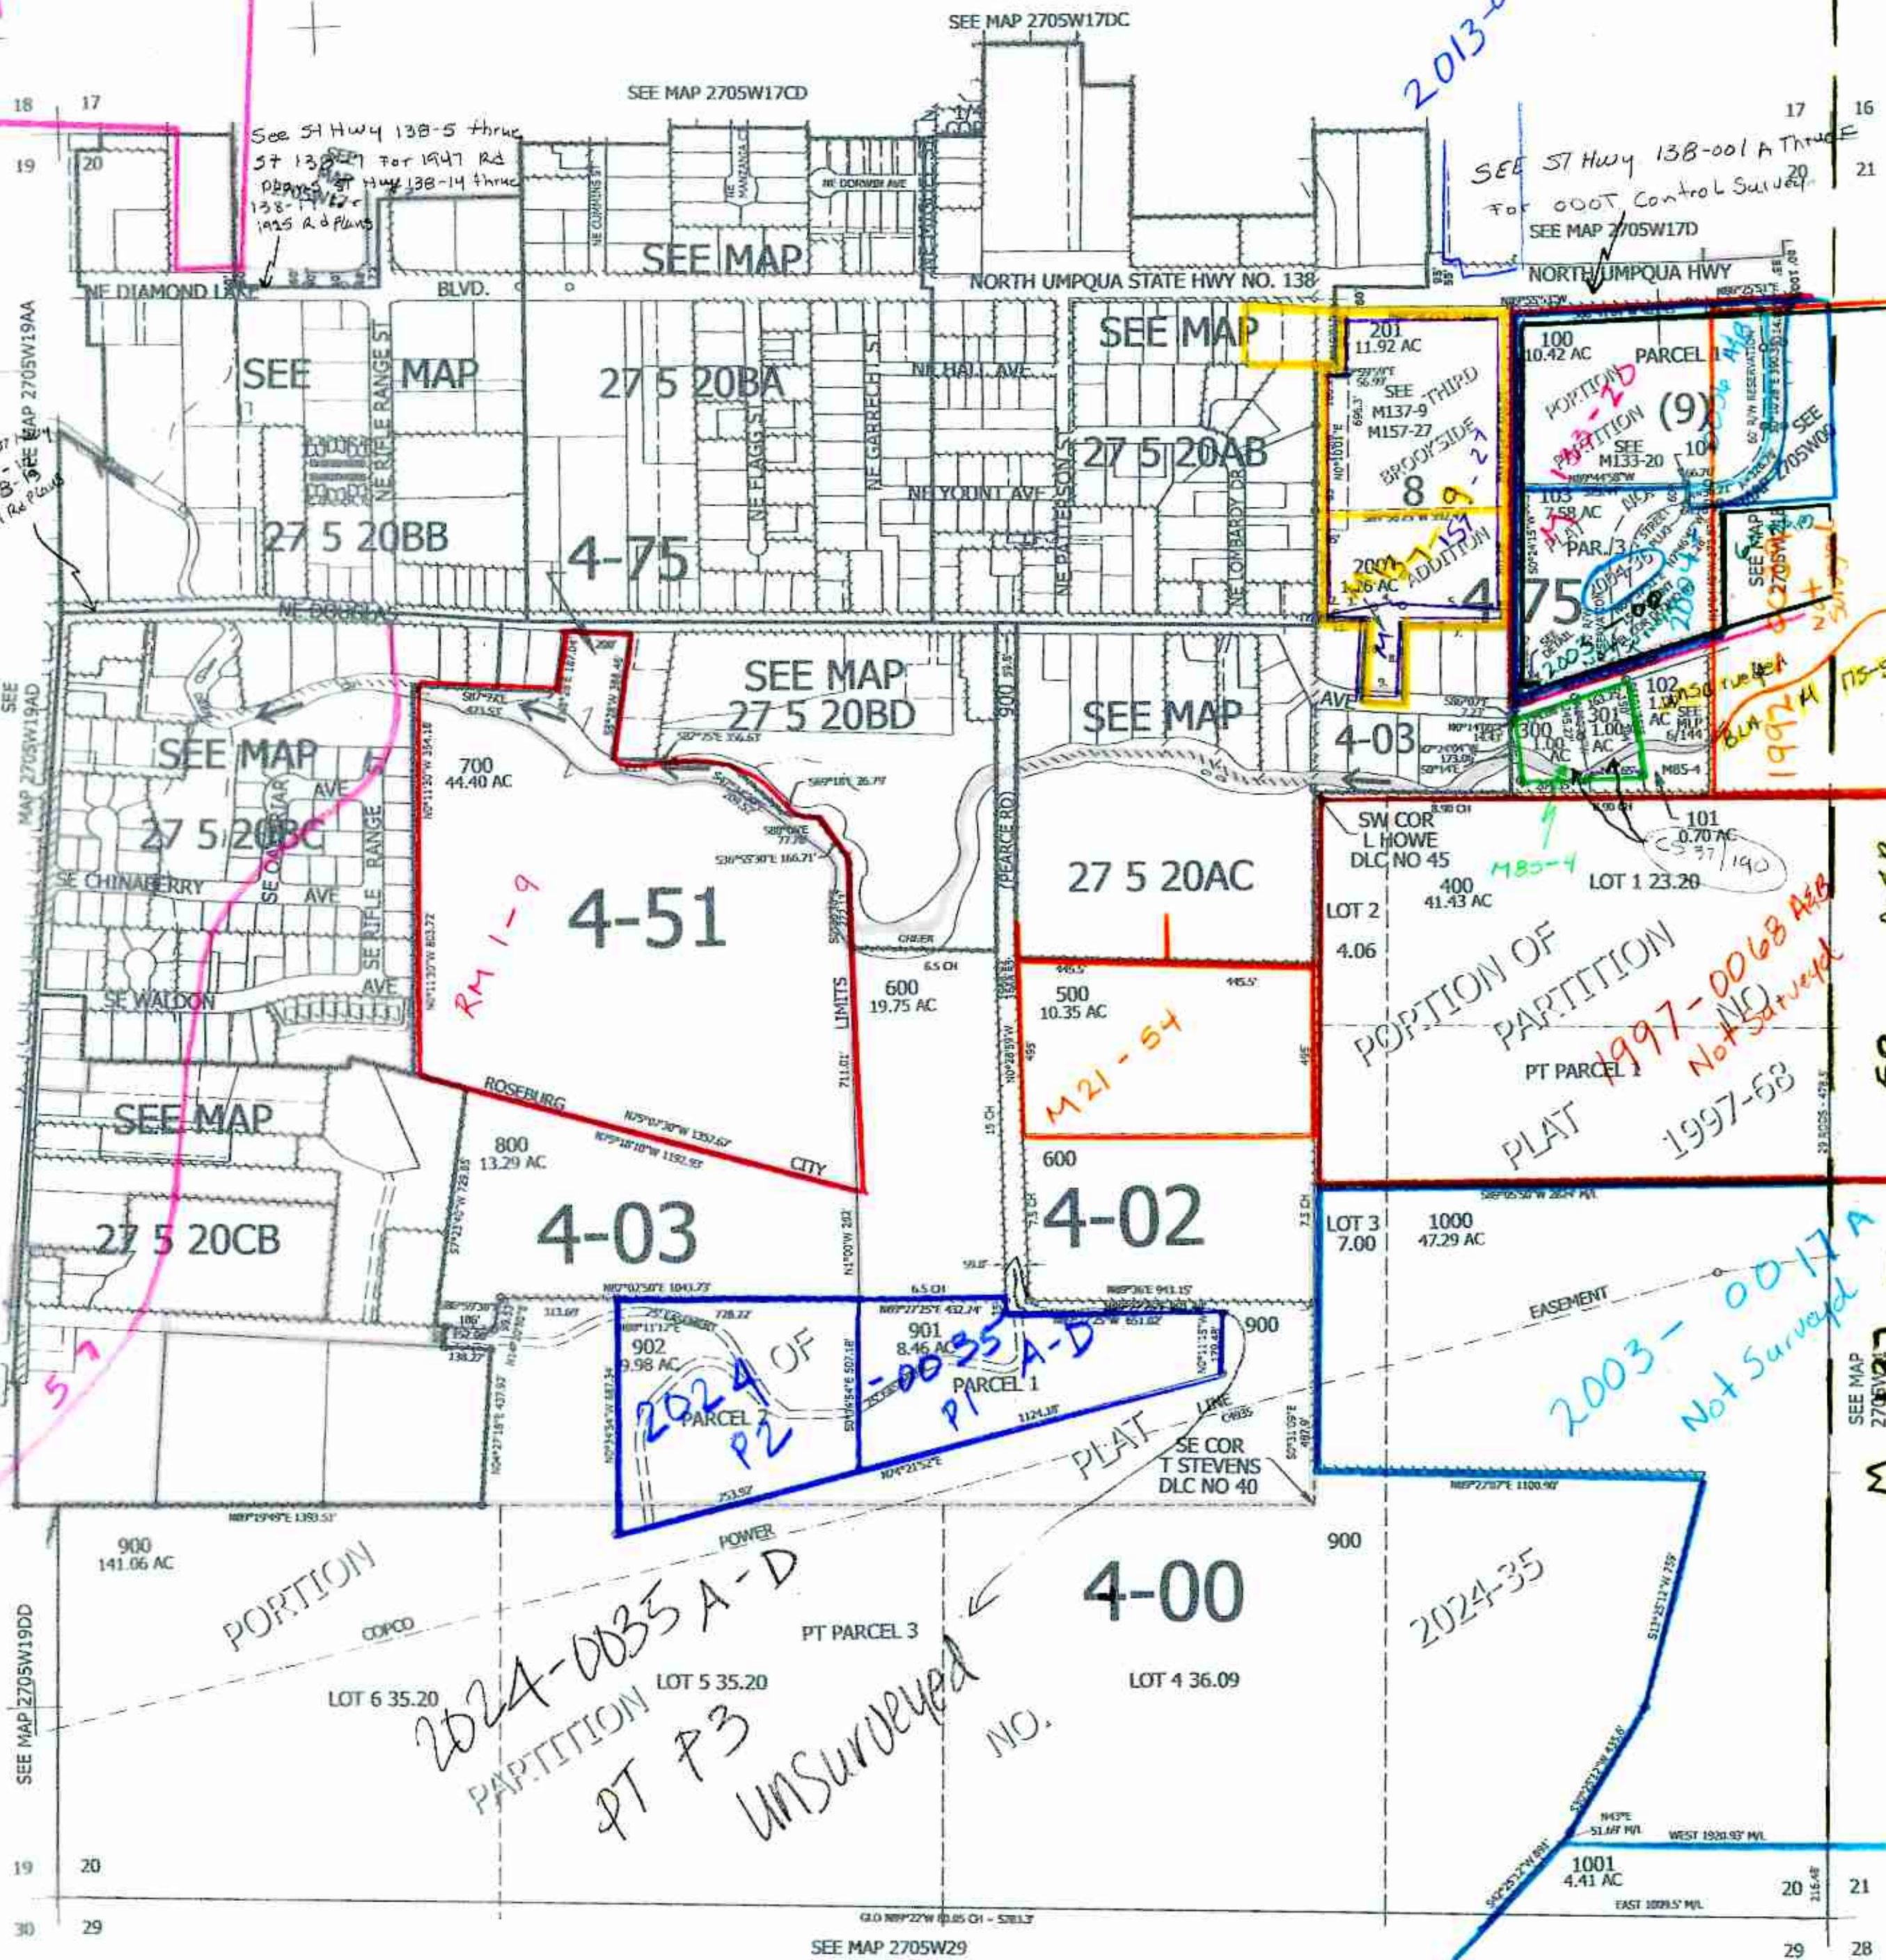

DETAIL PARCEL 103  
NOT TO SCALE

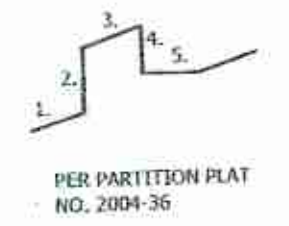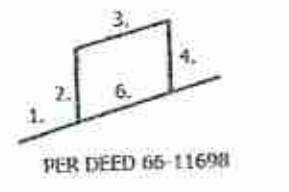

PER DEED 66-1169H  
PER PARTITION PLAT  
NO. 2004-36

M 270517 -  
59 A-30

2003-0017A  
Not Surveyed

2024-0035 A-D  
PART 3  
UNSURVEYED  
NO.

2024-35

RM 11-7  
RM 3-1-57  
RM 1-9  
RM 21-54

2013-0013

386 27  
138-  
138-  
1919 Rd Plans

See St Hwy 138-5 thru  
57 138-5 For 1947 Rd  
Plans St Hwy 138-14 thru  
138-14 Rd Plans  
1925 Rd Plans

SEE ST Hwy 138-001A Thru  
For 000T Control Survey  
SEE MAP 2705W17D

201  
11.92 AC  



270520  
& INDEX  
Roseburg

Lower Right:  
123°18'3"W 43°11'53"N  
4174637E 570569N FT