THIS MAP WAS PREPARED FOR ASSESSMENT PURPOSE ONLY.

SE1/4 NW1/4 SEC.20 T.27S. R.5W. W.M.
DOUGLAS COUNTY
1" = 100'

REVISED ON 6-17-19

27 5 20BD
ROSEBURG

CANCELLED NO'S
401 400A1 101
300 106 107
108 103

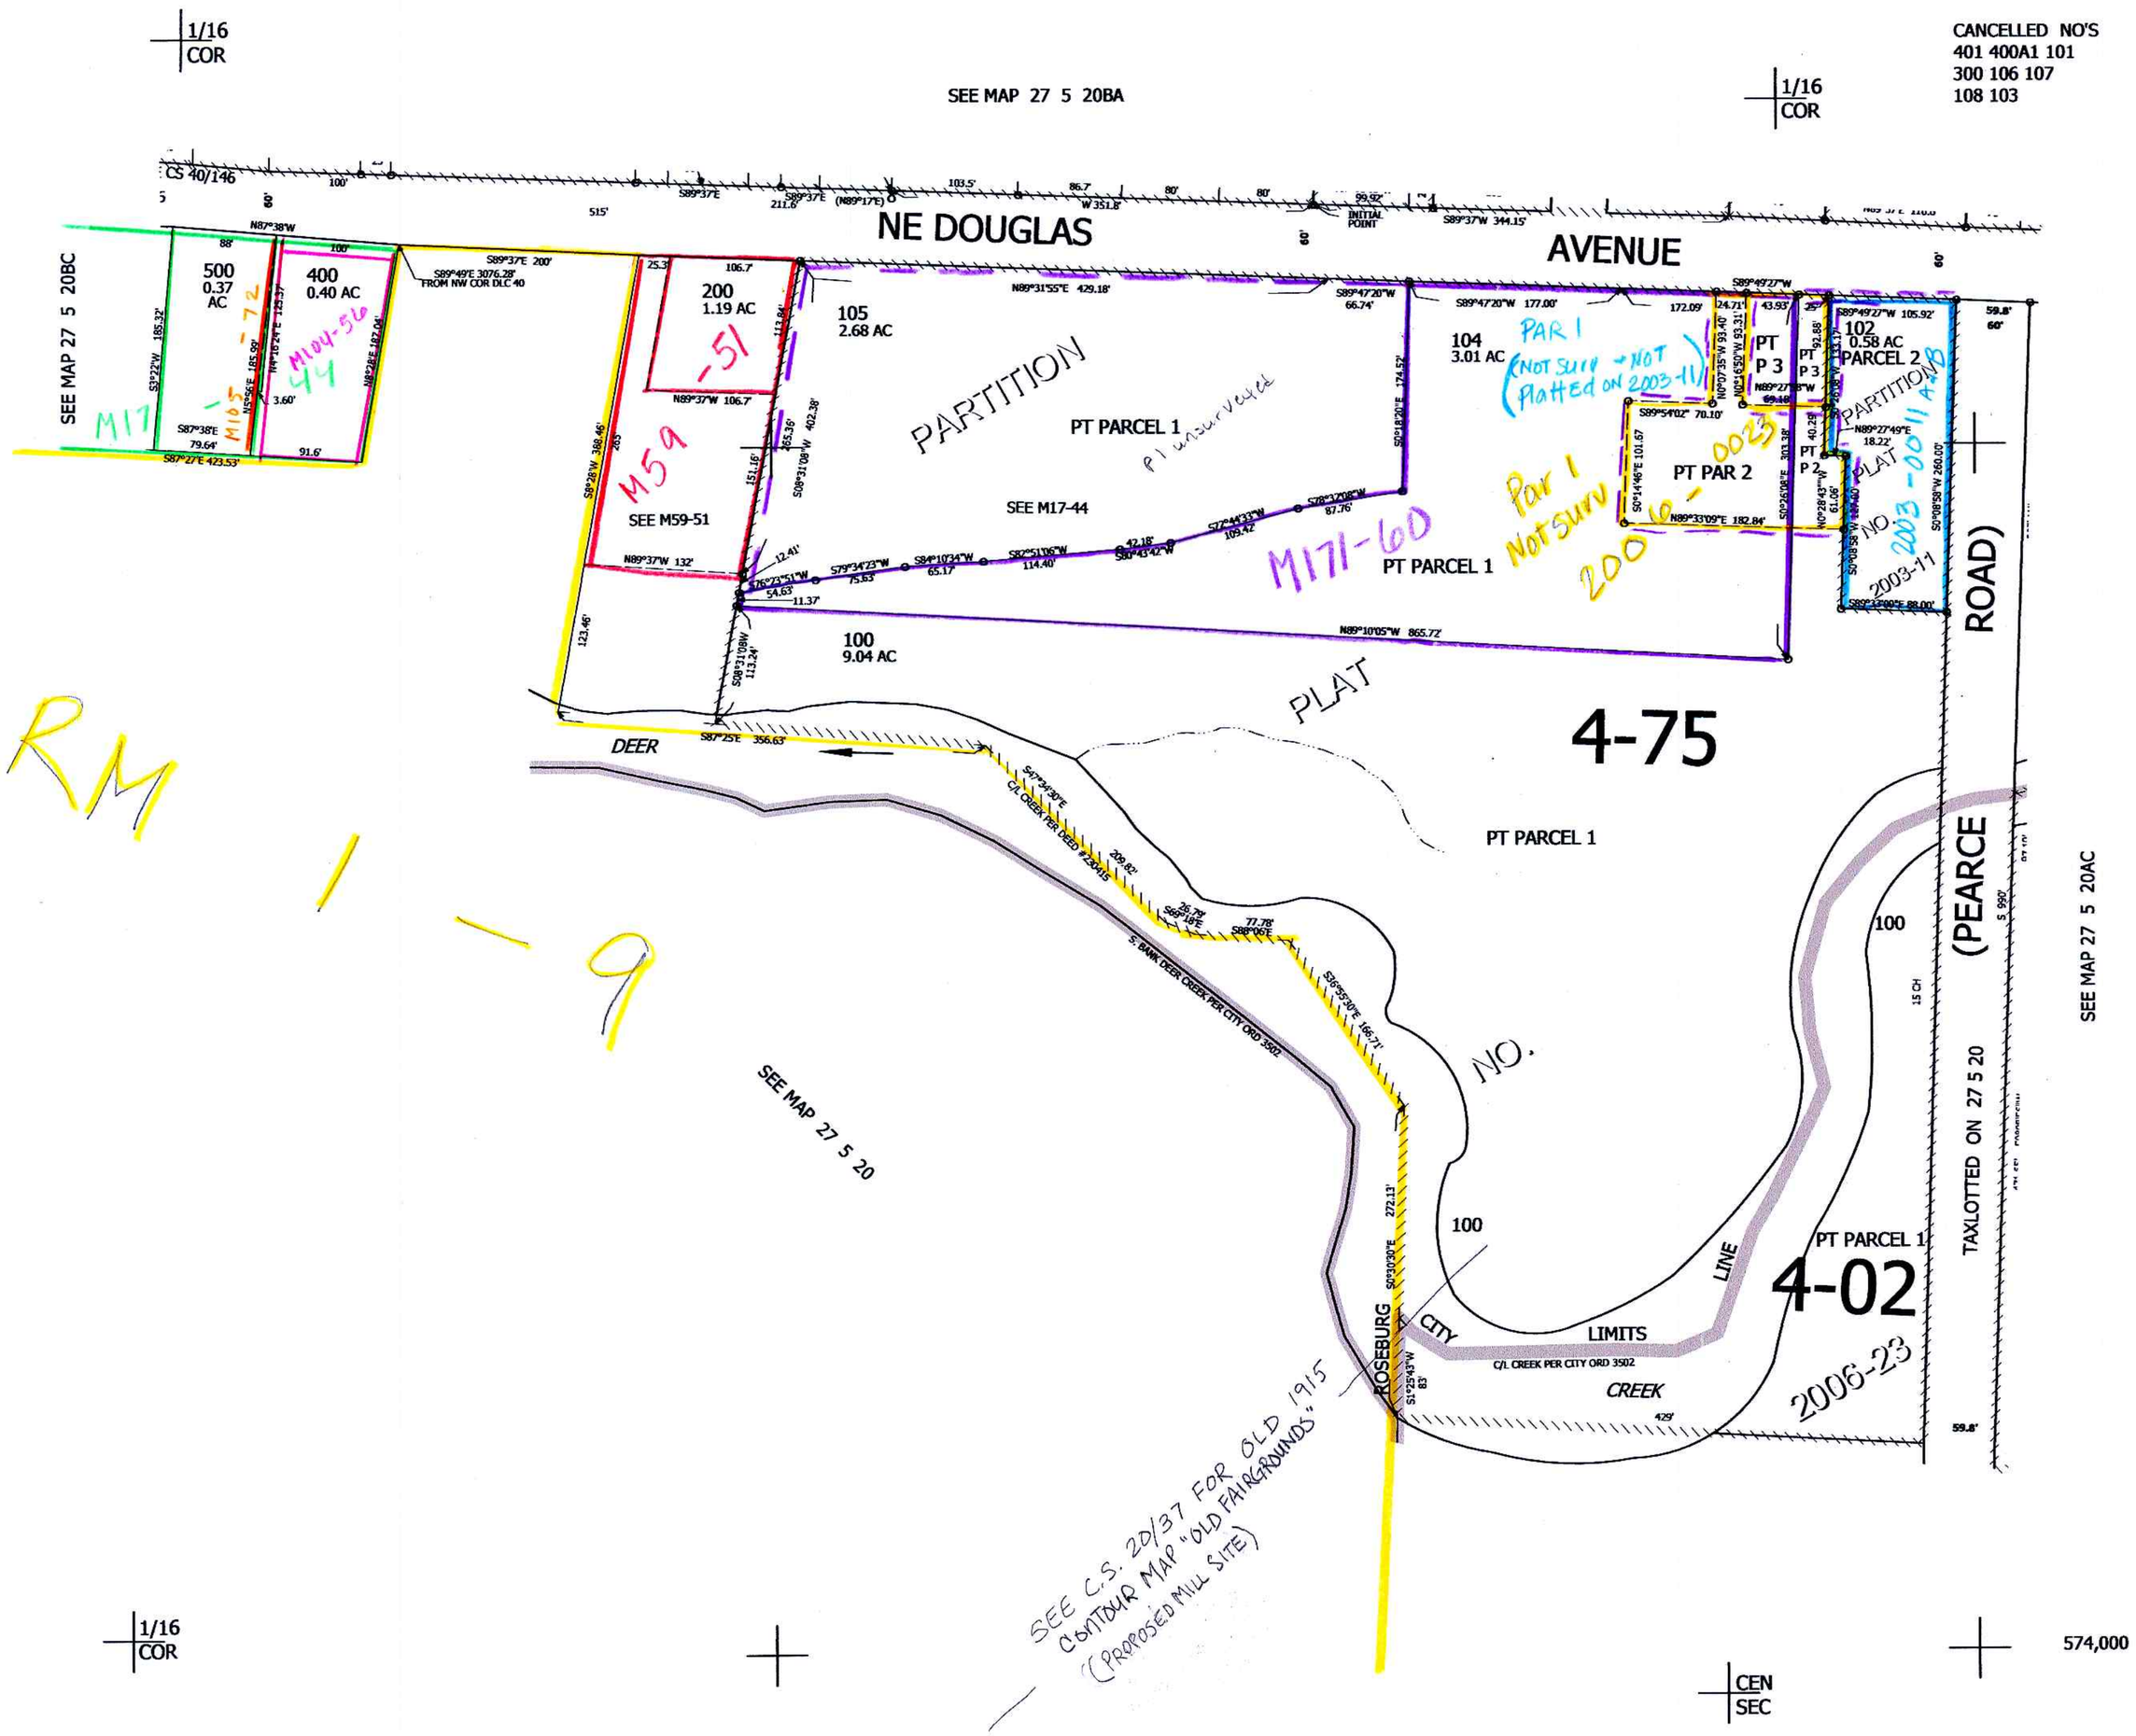

SEE C.S. 20/37 FOR OLD 1915 CONTOUR MAP "OLD FAIRGROUNDS" (PROPOSED MILL SITE)

7-2-19 8' SCV

27 5 20BD
ROSEBURG