This map was prepared for assessment purpose only

SECTION 28 T.27S. R. 5 W. W.M.
DOUGLAS COUNTY

1" = 400'

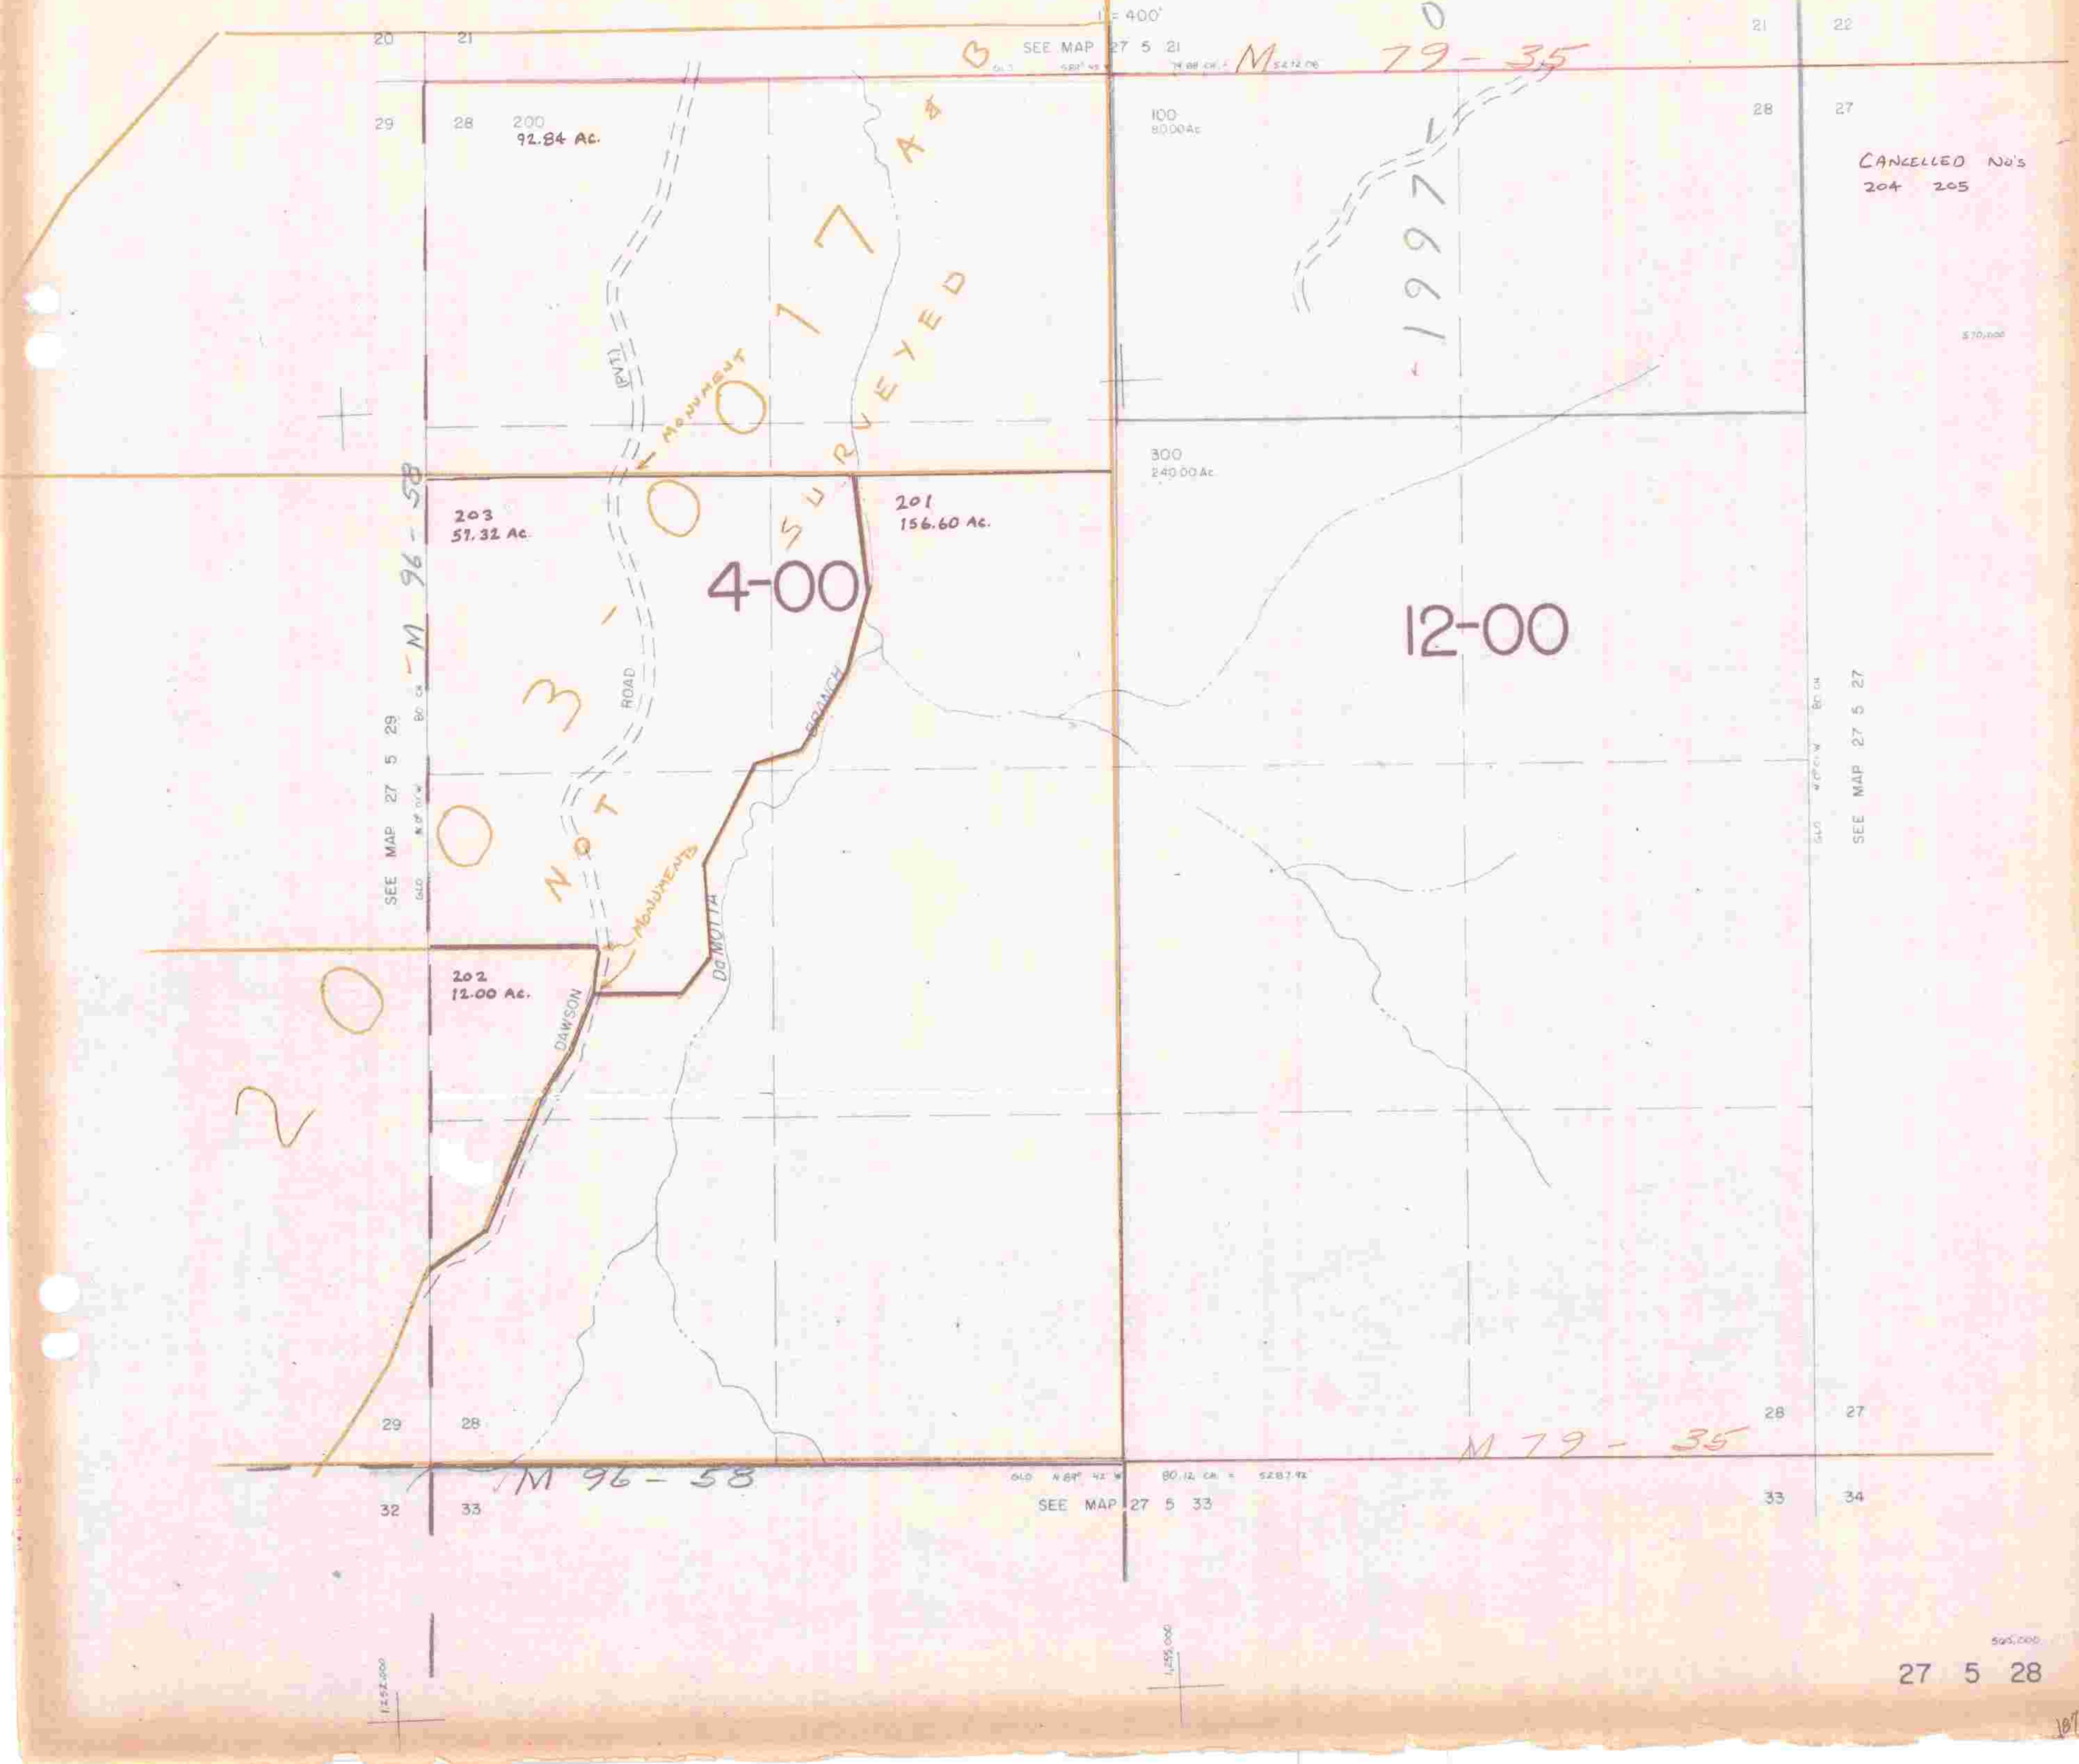
20
21
SEE MAP 27 5 21
79.88 CH. = 5272.08
M 79-35
0068 A+B
21
22
28
27
29
28
200
92.84 Ac.
100
80.00 Ac.
CANCELLED No's
204 205
-1997-
017 A&B
NOT SURVEYED
(PVT.)
MONUMENT
300
240.00 Ac.
203
57.32 Ac.
201
156.60 Ac.
4-00
12-00
M 96-58
ROAD
BRANCH
SEE MAP 27 5 29
80 CH.
GLO
SEE MAP 27 5 27
80 CH.
GLO
570,000
MONUMENTS
DaMOTTA
202
12.00 Ac.
DAWSON
2003-0
29
28
28
27
M 79-35
M 96-58
32
33
GLO N 89° 42' W
80.12 CH. = 5287.92
SEE MAP 27 5 33
33
34
1,252,000
1,255,000
565,000

187