THIS MAP WAS PROVIDED FOR ASSESSMENT PURPOSES ONLY

Upper Left:
123°21'9"W 43°11'15"N
416872BE 567230N ft

SEC.31 T.27S. R.05W. W.M.
DOUGLAS COUNTY
1" =400'

Date Exported 2023-05-30

270531

CANCELLED NOS:
701 702 703
704 705 2801
2501 1901 2001
2401 2402 100M1
200M1 1401 2701
200 1201 2202

1. N2°15'00"E 161.07'
2. S73°36'32"E 75.49'
3. LC=S80°35'09"E 189.8'
4. S27°33'45"E 64.22'
5. LC=S46°41'15"E 134.6'
6. N80°49'32"W 113.48'
7. S38°50'00"E 136.09'
8. S66°44'18"E 46.30'
9. S29°36'48"W 22.31'
10. S79°38'36"E 120.35'
11. S42°35'58"E 80.85'
12. S27°18'59"E 130.25'
13. S84°12'46"E 71.13'
14. S17°50'44"E 33.52'
15. S29°47'07"E 38.71'
16. N80°23'52"E 30.02'
17. S53°05'27"E 44.68'
18. S73°19'22"E 42.06'
19. N48°16'24"E 22.37'
20. S70°34'44"E 117.64'
21. S64°38'39"E 77.41'
22. LC=S13°55'26"E 64.06'
23. S41°24'29"E 70'
24. S35°41'51"E 50.25'
25. S44°56'38"E 81.07'
26. S62°46'49"E 21.09'
27. N89°59'19"W 30'
28. S8°50'48"E 43.3'
29. LC=S1°06'47"W 61.94'
30. S11°04'23"W 120.73'
31. LC=S8°49'42"E 118.2'
32. S28°43'48"E 77.95'
33. LC=S4°09'06"E 67.13'
34. S20°25'36"W 72.6'
35. LC=S16°02'29"W 109.57'
36. S11°39'18"W 19.82'
37. LC=S14°28'15"W 140.67'
38. S17°17'07"W 175.68'
39. LC=S43°38'00"E 156.48'
40. N75°26'54"E 66.43'
41. LC=S80°58'46"E 86.13'
42. S57°24'26"E 50.57'
43. LC=S28°09'45"E 79.97'
44. S1°04'53"W 47.48'
45. LC=S35°32'49"E 89.96'
46. S72°10'33"E 47.41'
47. LC=S34°16'23"E 73.33'
48. S3°37'48"W 93.21'
49. LC=S56°32'04"E 89.93'
50. S16°41'57"E 75.41'
51. LC=S9°19'37"W 93.11'
52. S38°21'12"W 14.7'
53. LC=N21°02'28"W 159.07'
54. S77°26'08"E 26.08'
55. LC=S64°31'17"E 80.63'
56. S51°36'26"E 43.83'
57. LC=S36°56'25"E 82.9'
58. LC=S1°26'54"E 97'
59. S10°27'38"W 73.06'
60. LC=S5°07'52"E 99.03'
61. S29°38'22"E 169.31'
62. LC=S44°54'51"E 86.25'
63. S60°11'19"E 81.67'
64. LC=S53°52'11"E 54.77'
65. LC=S37°54'54"E 137.2'
66. LC=S41°42'04"E 89.61'
67. LC=S67°58'55"E 101.91'
68. S80°49'39"E 161.36'
69. LC=S86°08'32"E 66.34'
70. N88°32'35"E 96.40'
71. LC=N81°16'16"E 65.93'
72. N73°59'56"E 42.24'
73. N88°54'02"W 113.48'
74. S15°41'22"W 186.65'
75. LC=S6°17'43"W 84.41'
76. S1°45'02"E 67.88'
77. LC=S9°20'34"E 151.4'
78. S16°56'06"E 57.87'
79. LC=S41°30'05"W 97.64'

80. N80°03'45"W 110.7'
81. LC=S78°28'16"W 98.1'
82. N89°55'45"W 11'
83. N48°43'39"E 88.7'
84. N7°00'00"W 60'
85. N11°03'04"W 65.33'
86. N2°29'59"W 46.31'
87. N3°00'00"E 30'
88. N5°03'13"W 95'
89. N5°03'13"W 23'
90. N23°00'00"E 35'
91. N26°29'12"E 133.48'
92. N36°18'28"E 45.22'
93. N16°00'00"W 66.77'

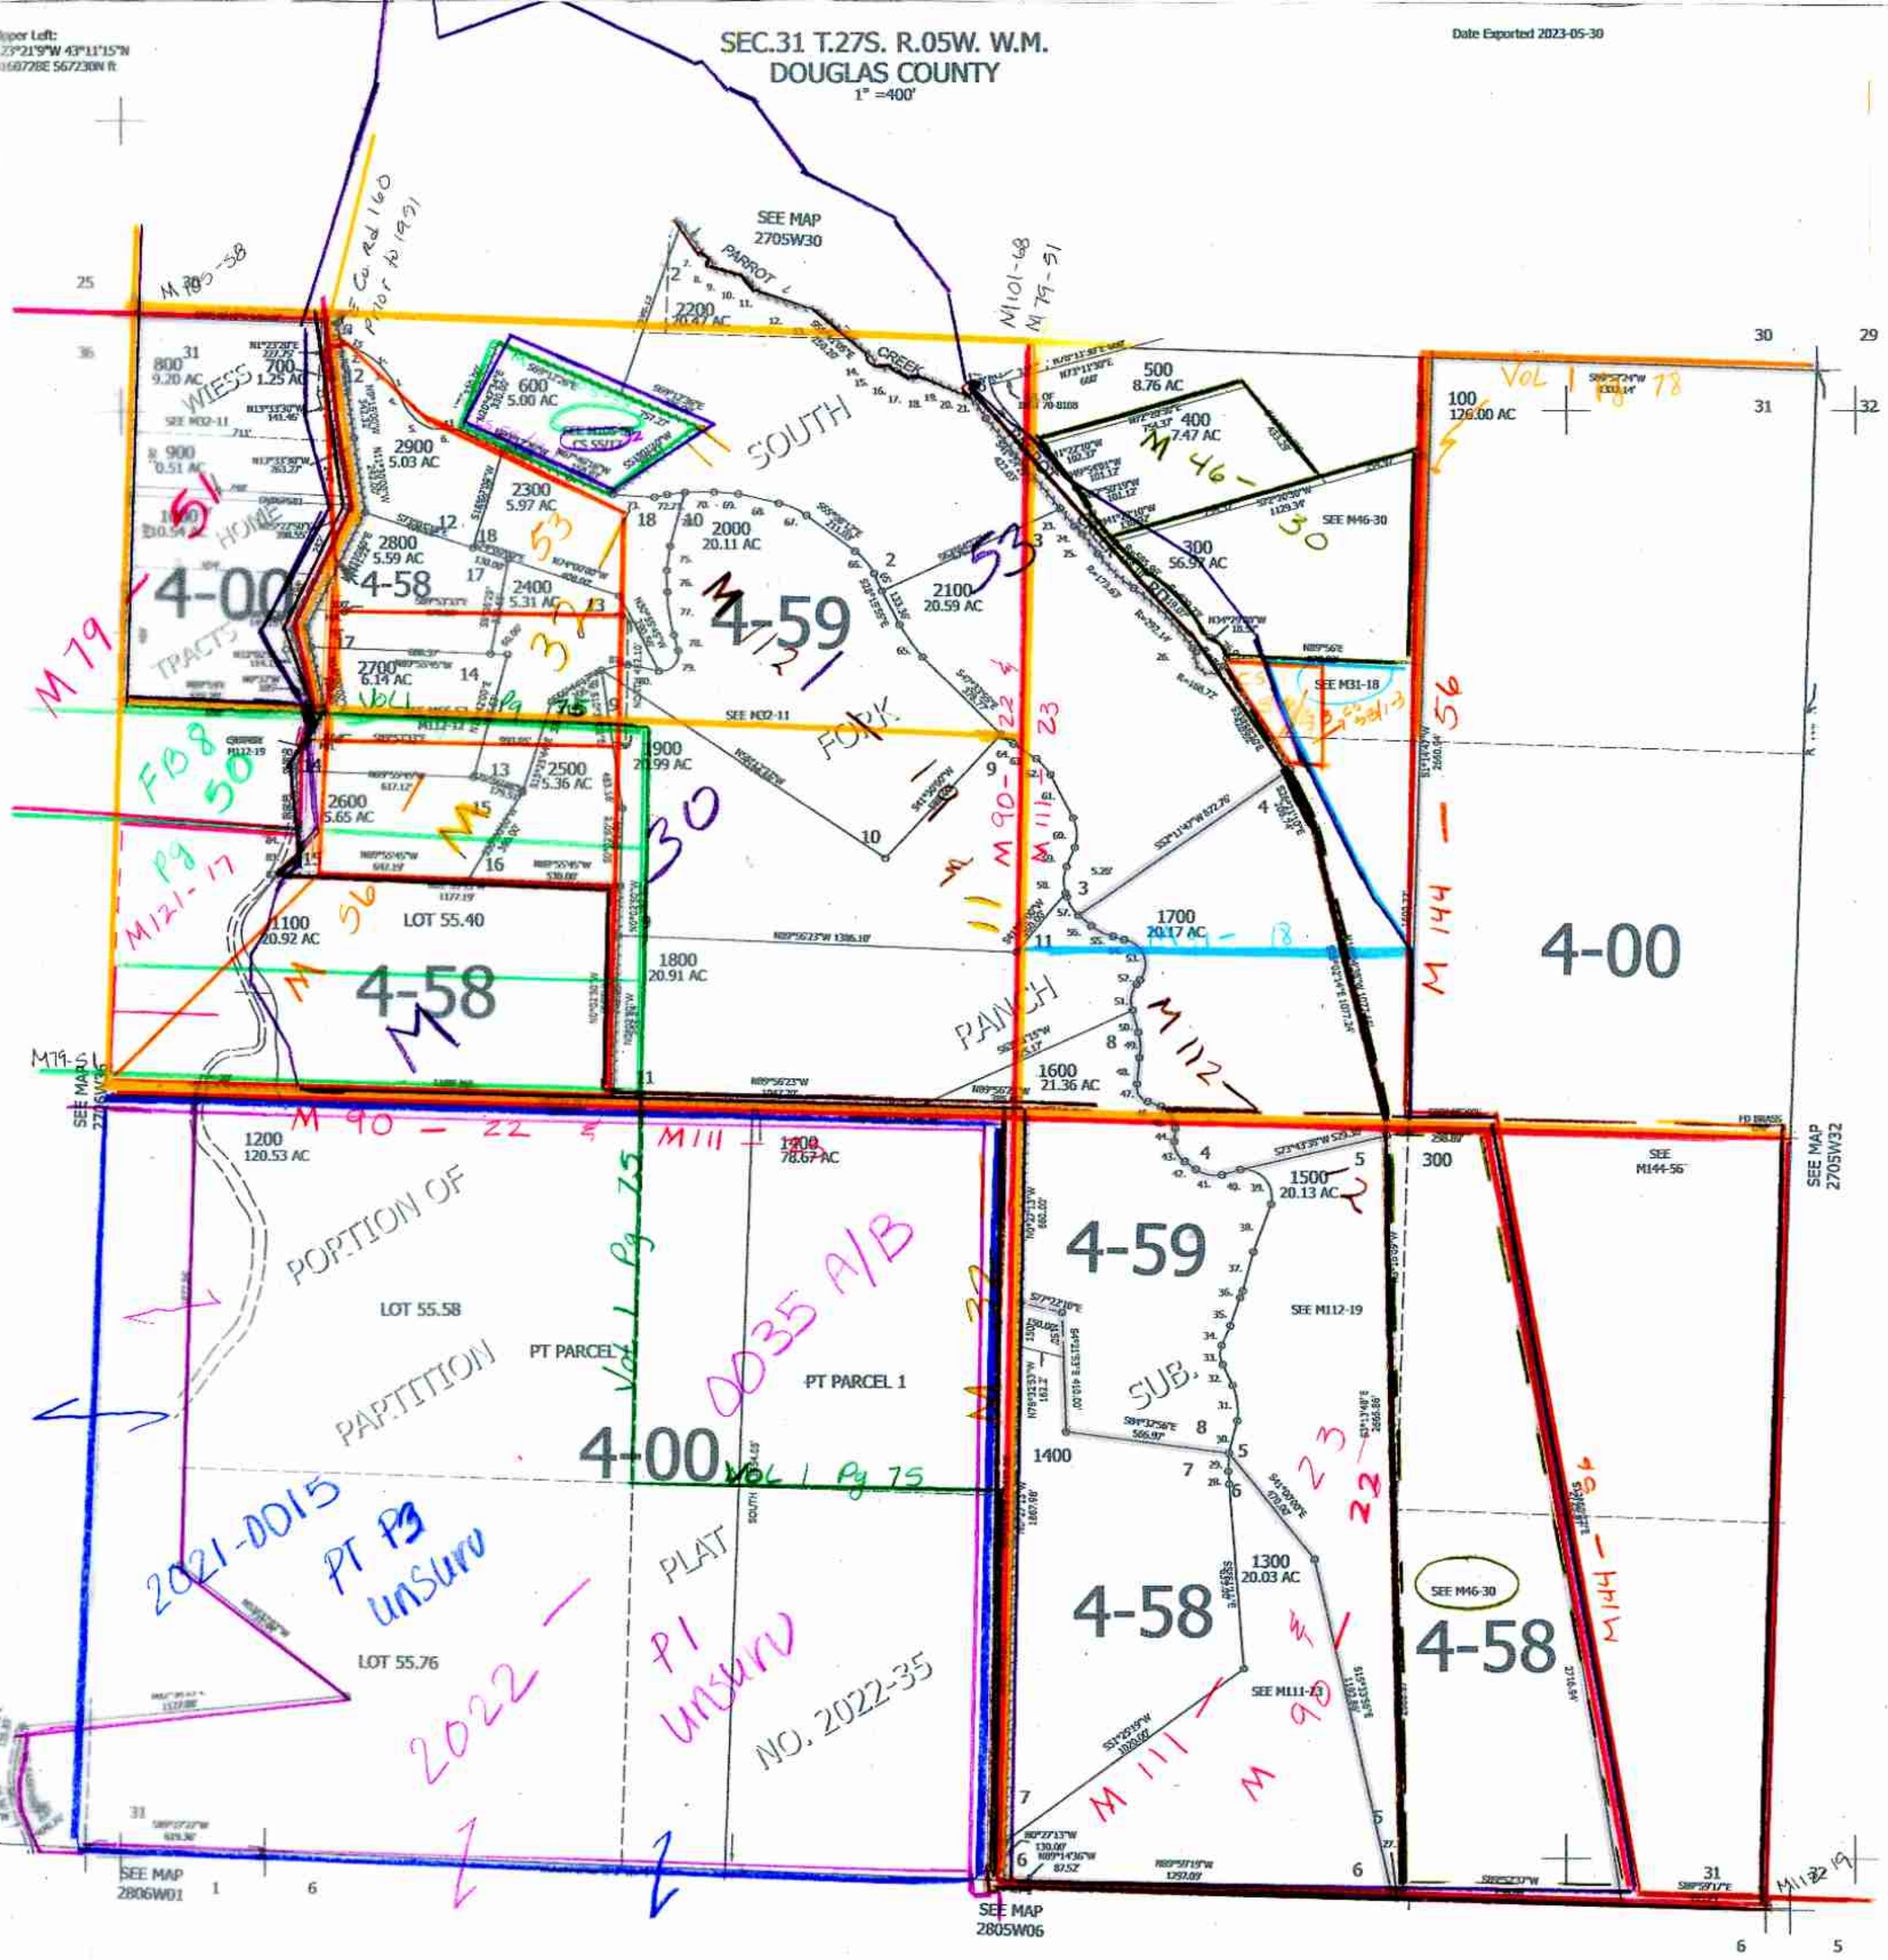

270531