THIS MAP WAS PREPARED FOR ASSESSMENT PURPOSE ONLY.

T.27S. R.6E. W.M.
DOUGLAS COUNTY

27 6E

1"=2000'

SEE MAP 26 6E

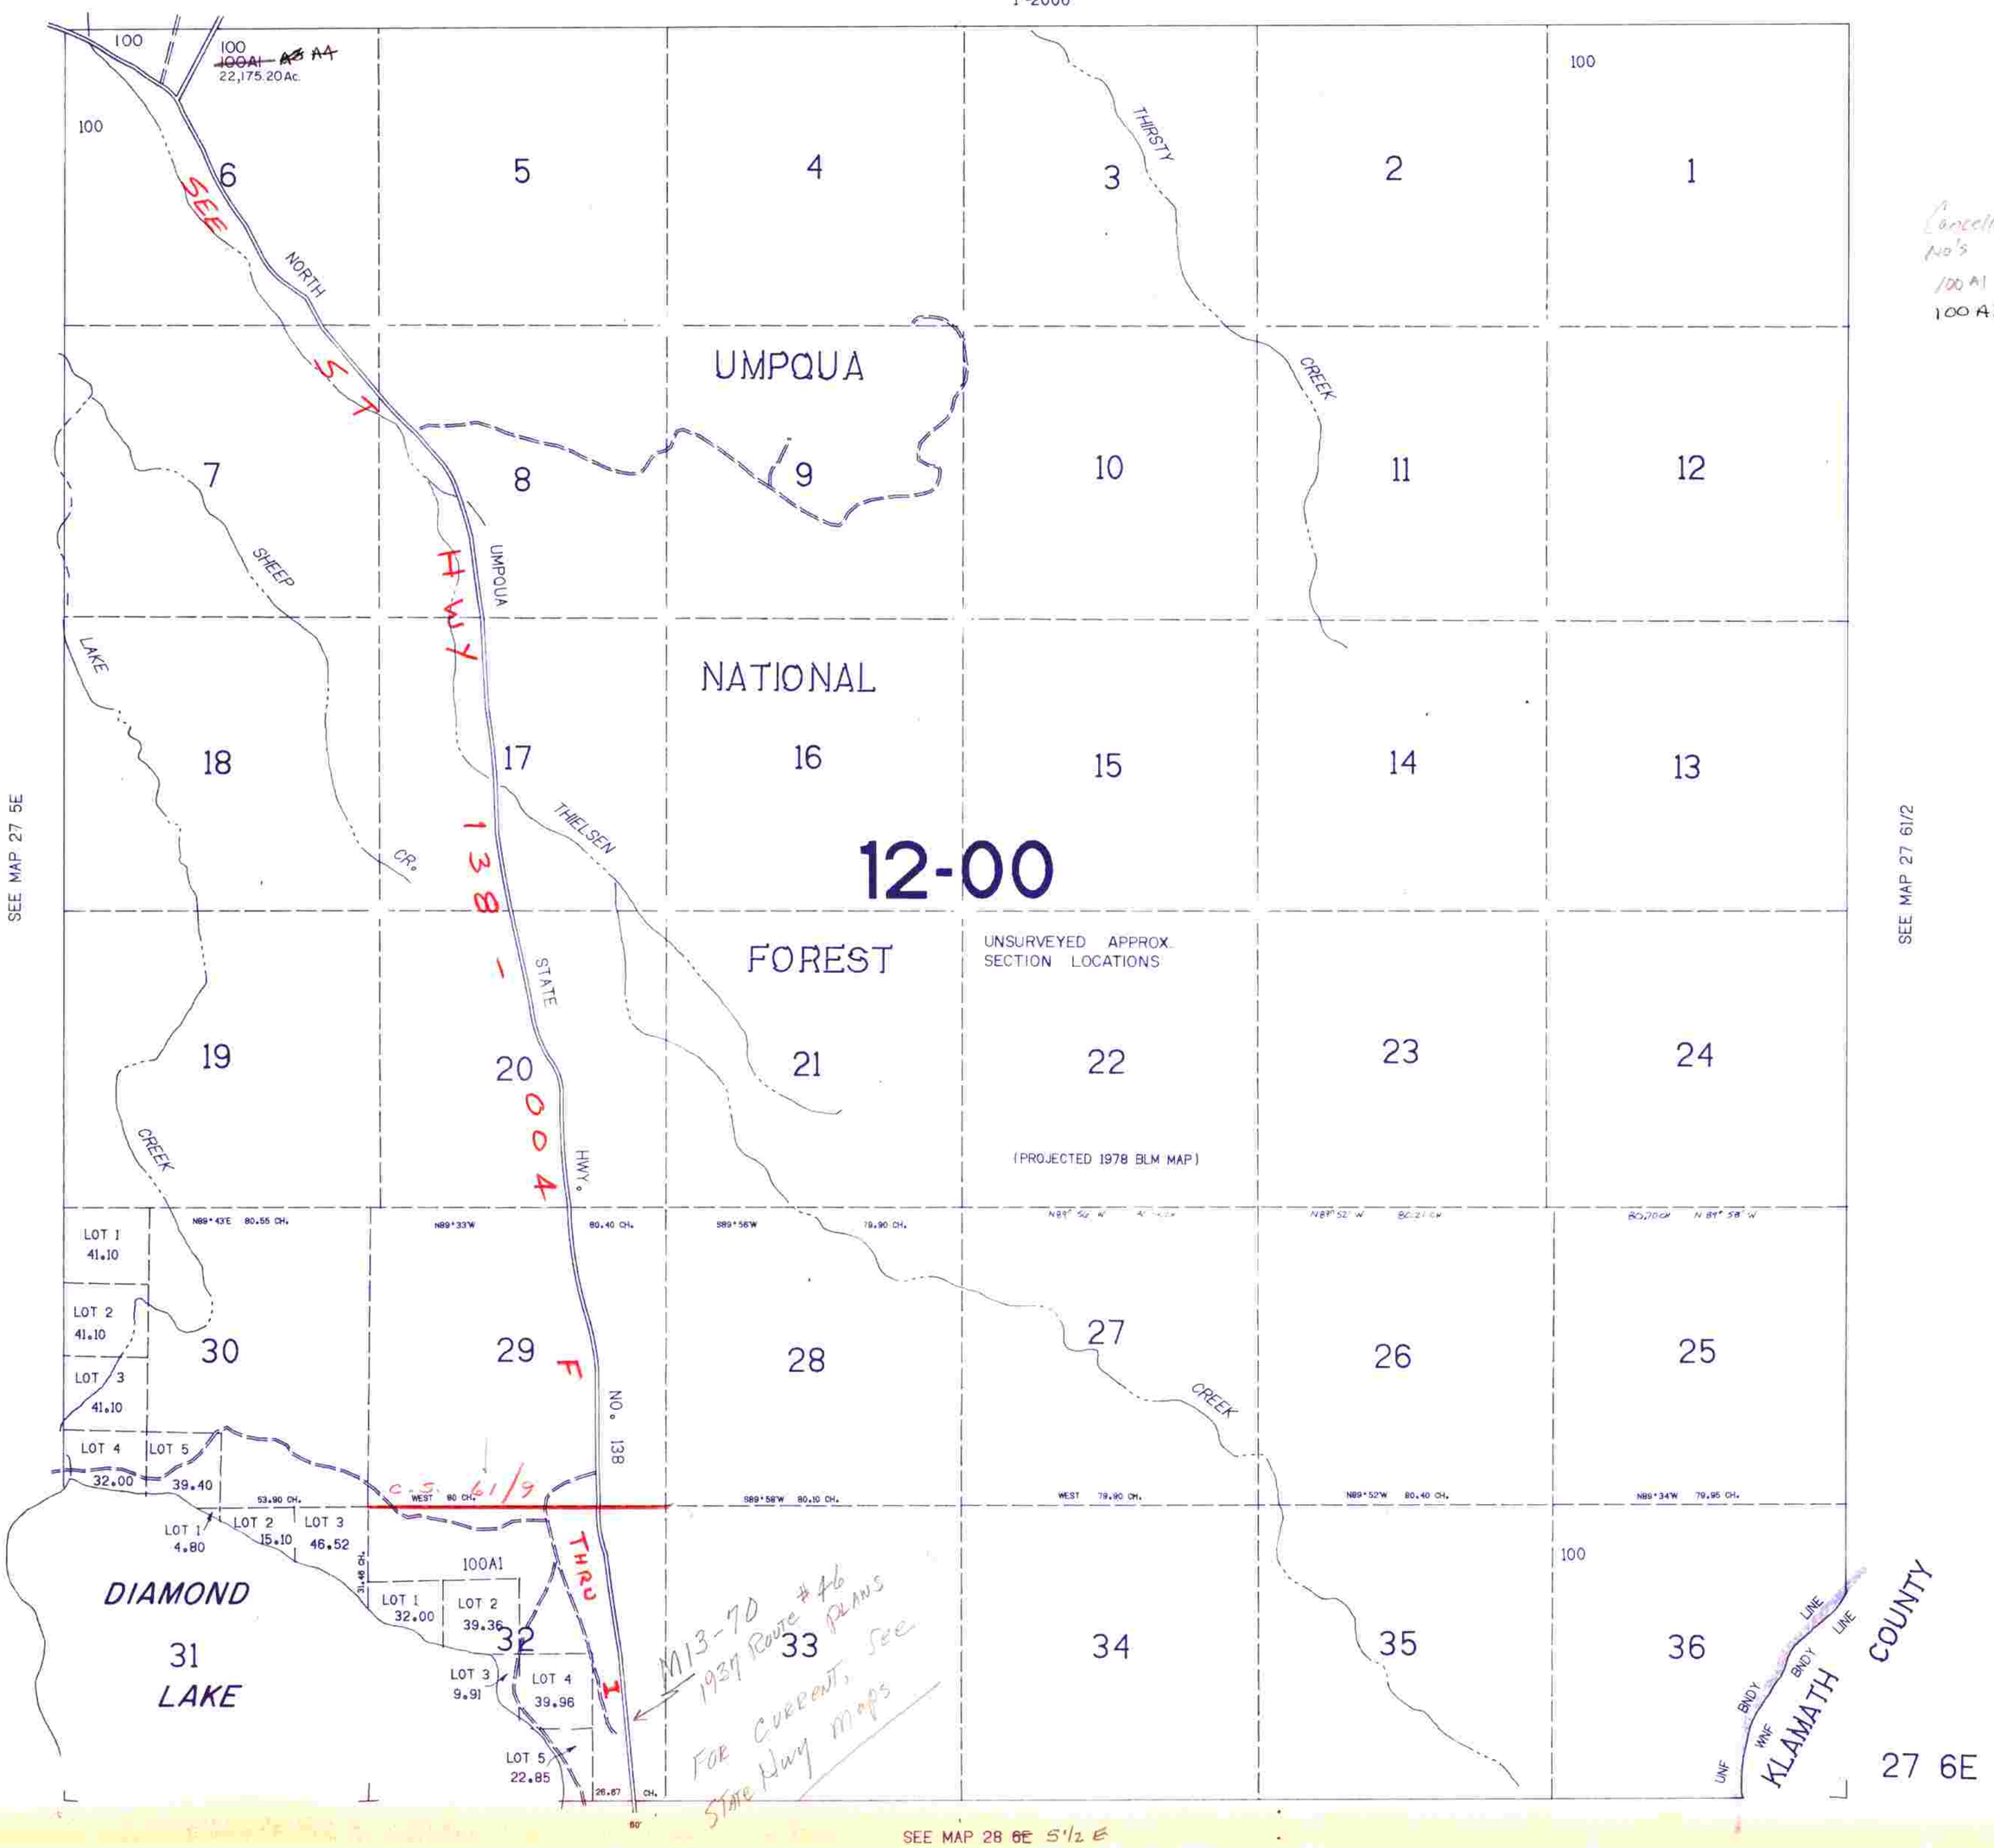

Cancelled No's
100 A1
100 A3

SEE MAP 28 6E 5½ E