THIS MAP WAS PREPARED FOR ASSESSMENT PURPOSE ONLY.

SEC.1 T.27S. R.6W. W.M.
DOUGLAS COUNTY

1" = 400'

REVISED ON 4-12-07

27 6 1
& INDEX
ROSEBURG

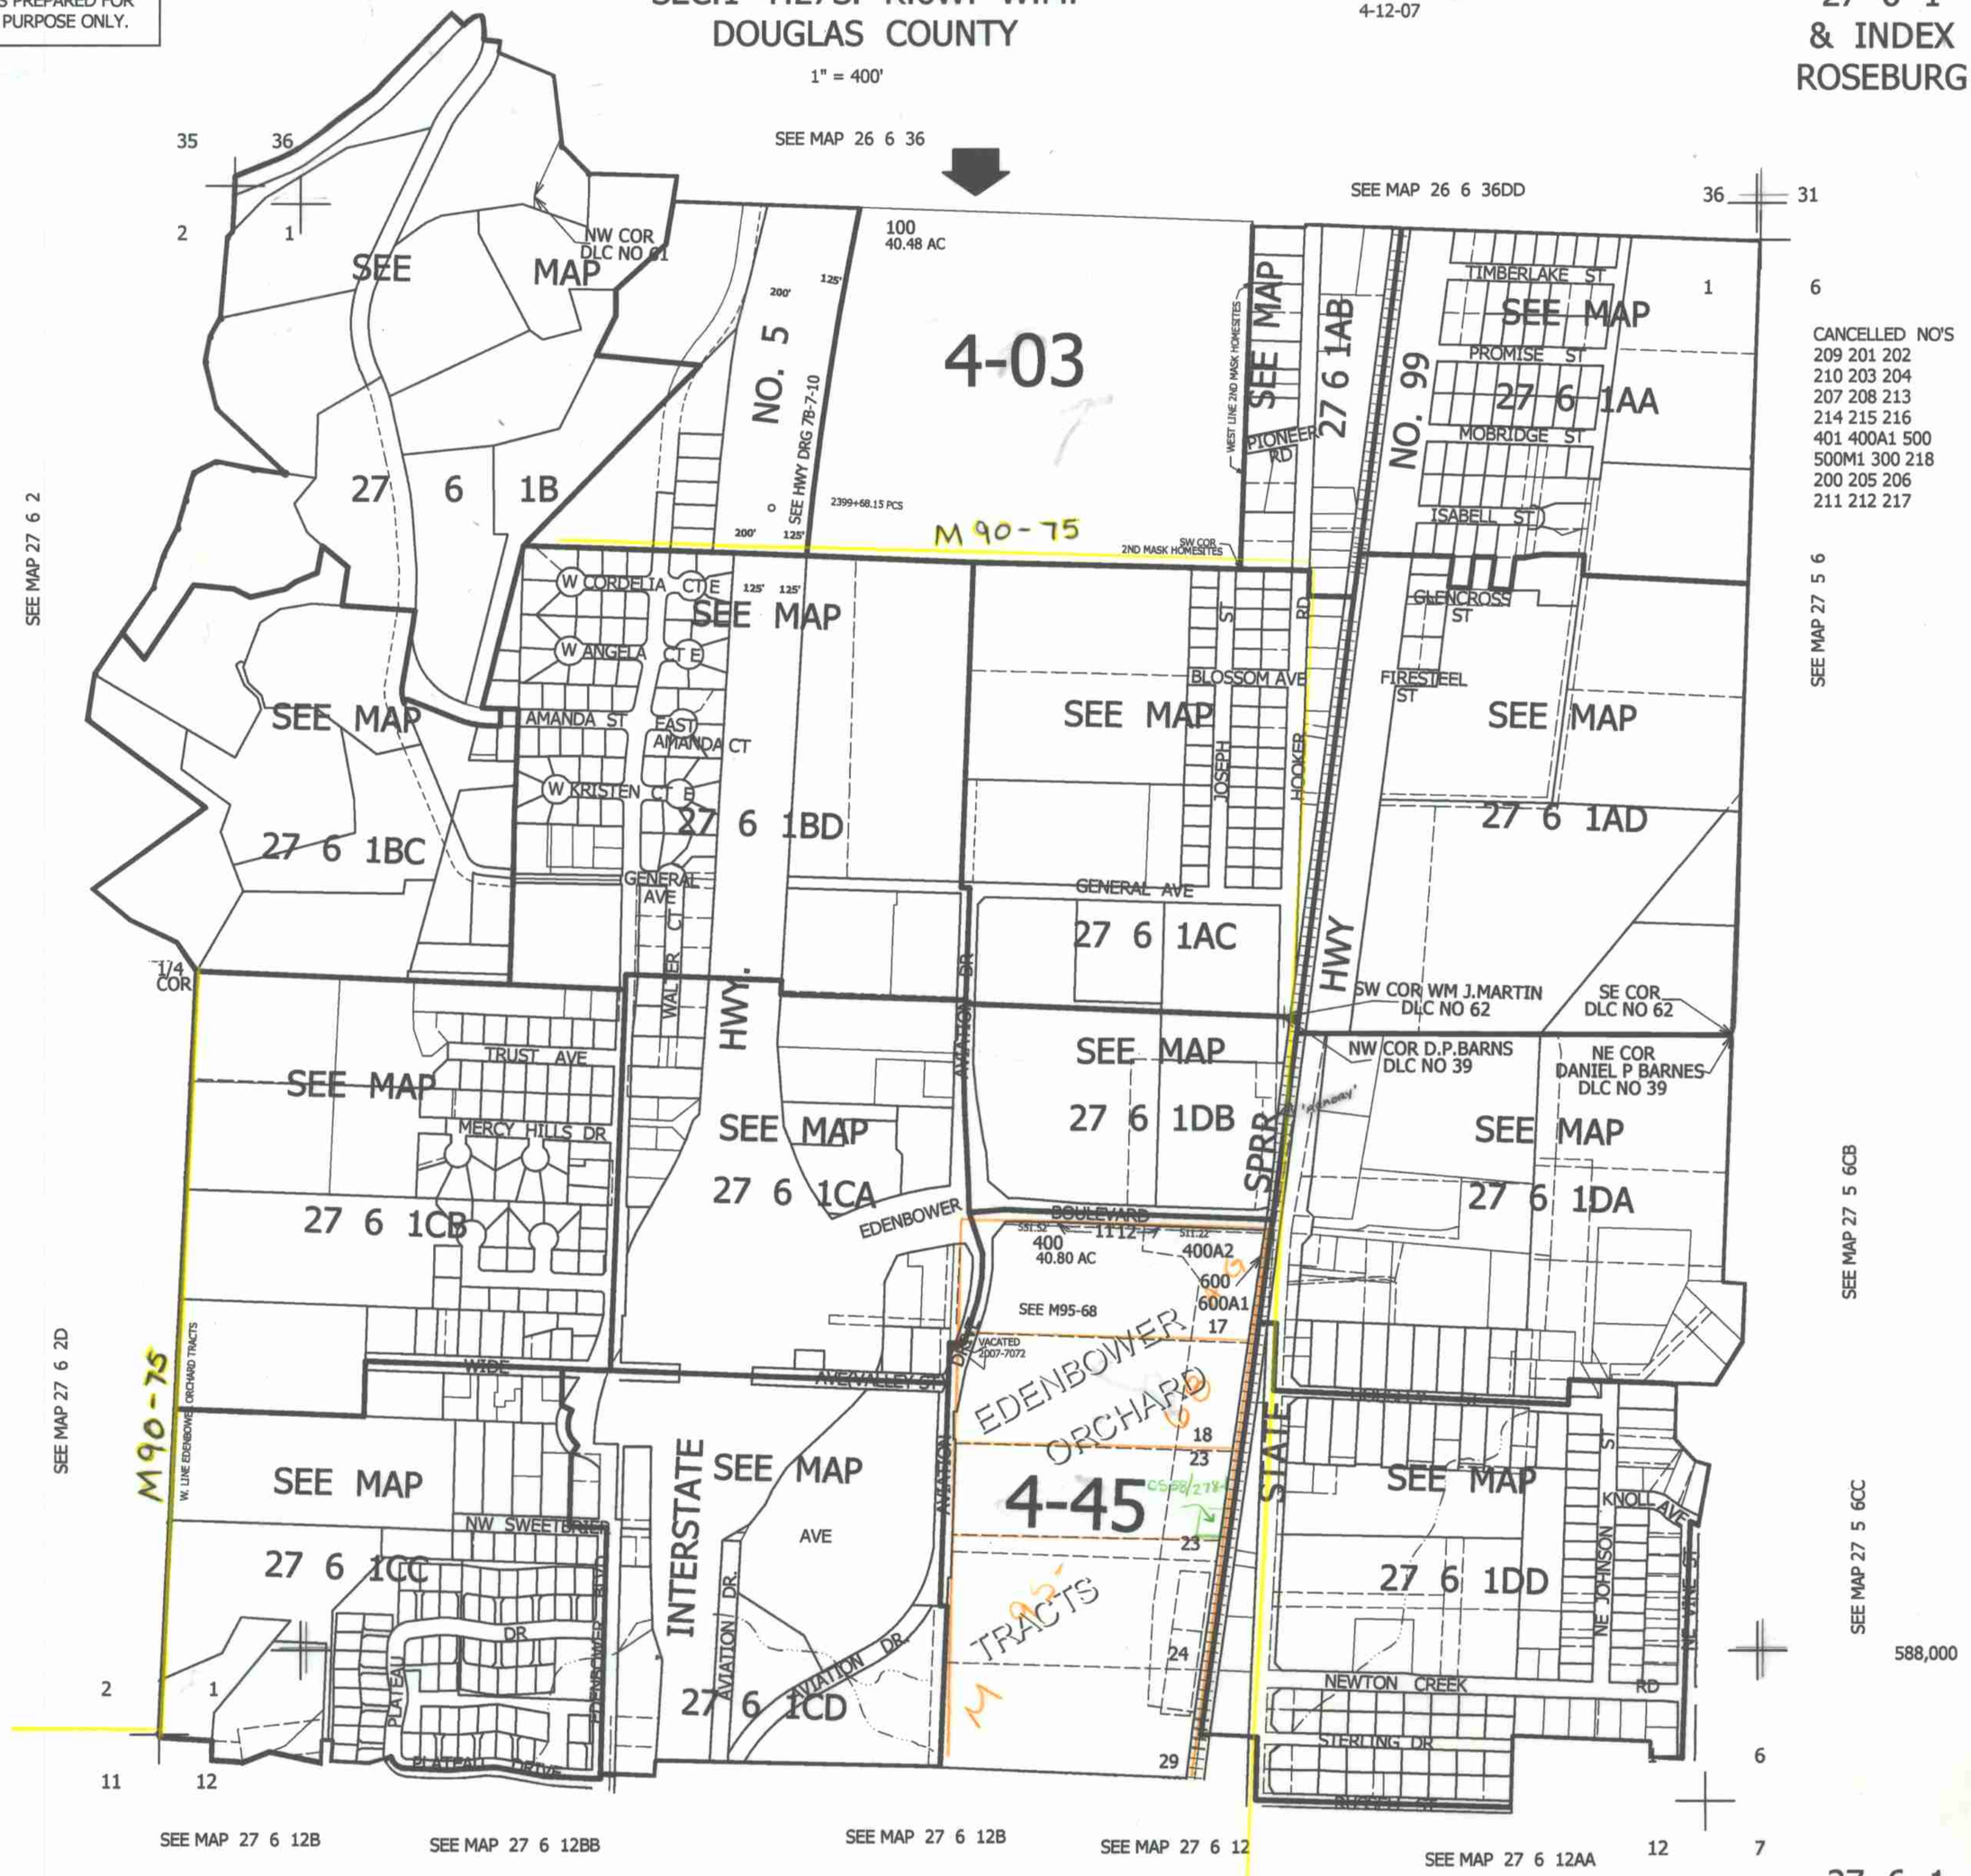

JC 11198

27 6 1
& INDEX
ROSEBURG