

SE1/4NW1/4 SEC. 1 T.27S. R.6W. W.M.
DOUGLAS COUNTY

REVISED ON
8-24-93

27 6 1BD

THIS MAP WAS PREPARED FOR
ASSESSMENT PURPOSE ONLY.

SEE MAP 27 6 1

1"=100'

M 90-75

1996-0046

CANCELLED NO'S
3400
1900
7200

APPROX.
1/16 COR.

4-03

INTERSTATE HWY. NO. 5

EDENBOWER
ORCHARDS
TRACTS
M 58-72
M 177-69A&B

SEE MAP 27 6 1AC

591,000

GENERAL AVE.


4-46

M 58-39
M 84
M 140
-75

BOWER ST Aviation Dr

27 6 1BD

9/93 JC
RP

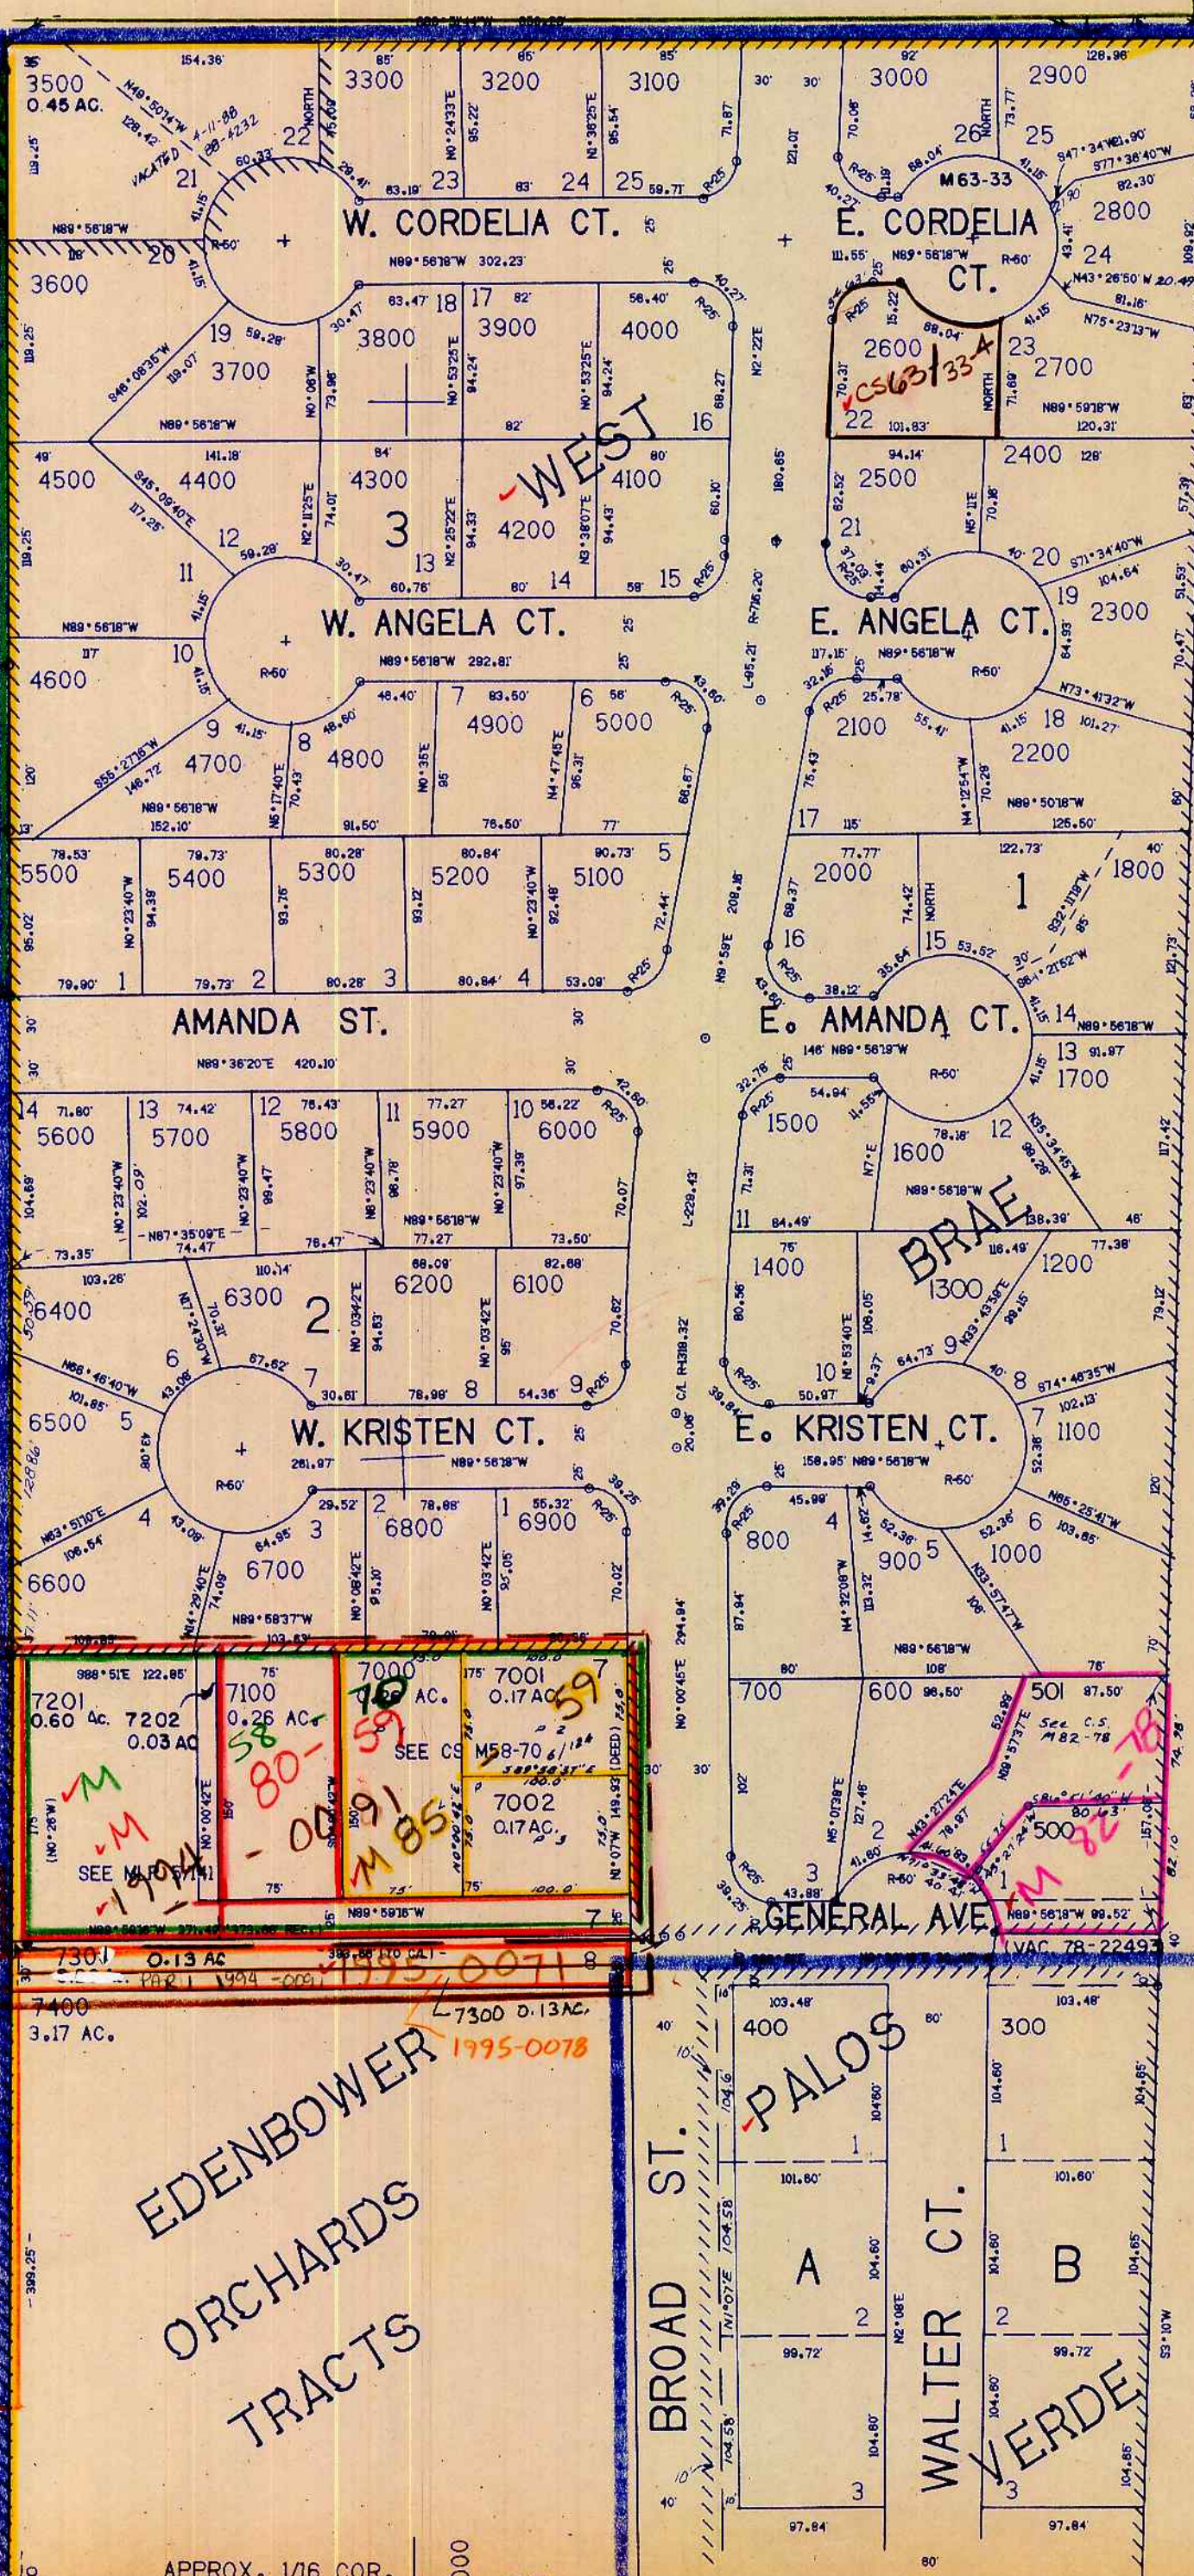

SEE MAP 27 6 1

M 90-75
1995-78
1995-0071

SEE MAP 27 6 1CB

SEE MAP 27 6 1CA

APPROX. CEN. SEC.