THIS MAP WAS PREPARED FOR ASSESSMENT PURPOSE ONLY.

SE1/4 SW1/4 SEC.1 T.27S. R.6W. W.M.
DOUGLAS COUNTY

1" = 100'

REVISED ON 4-25-11

27 6 1CD
ROSEBURG

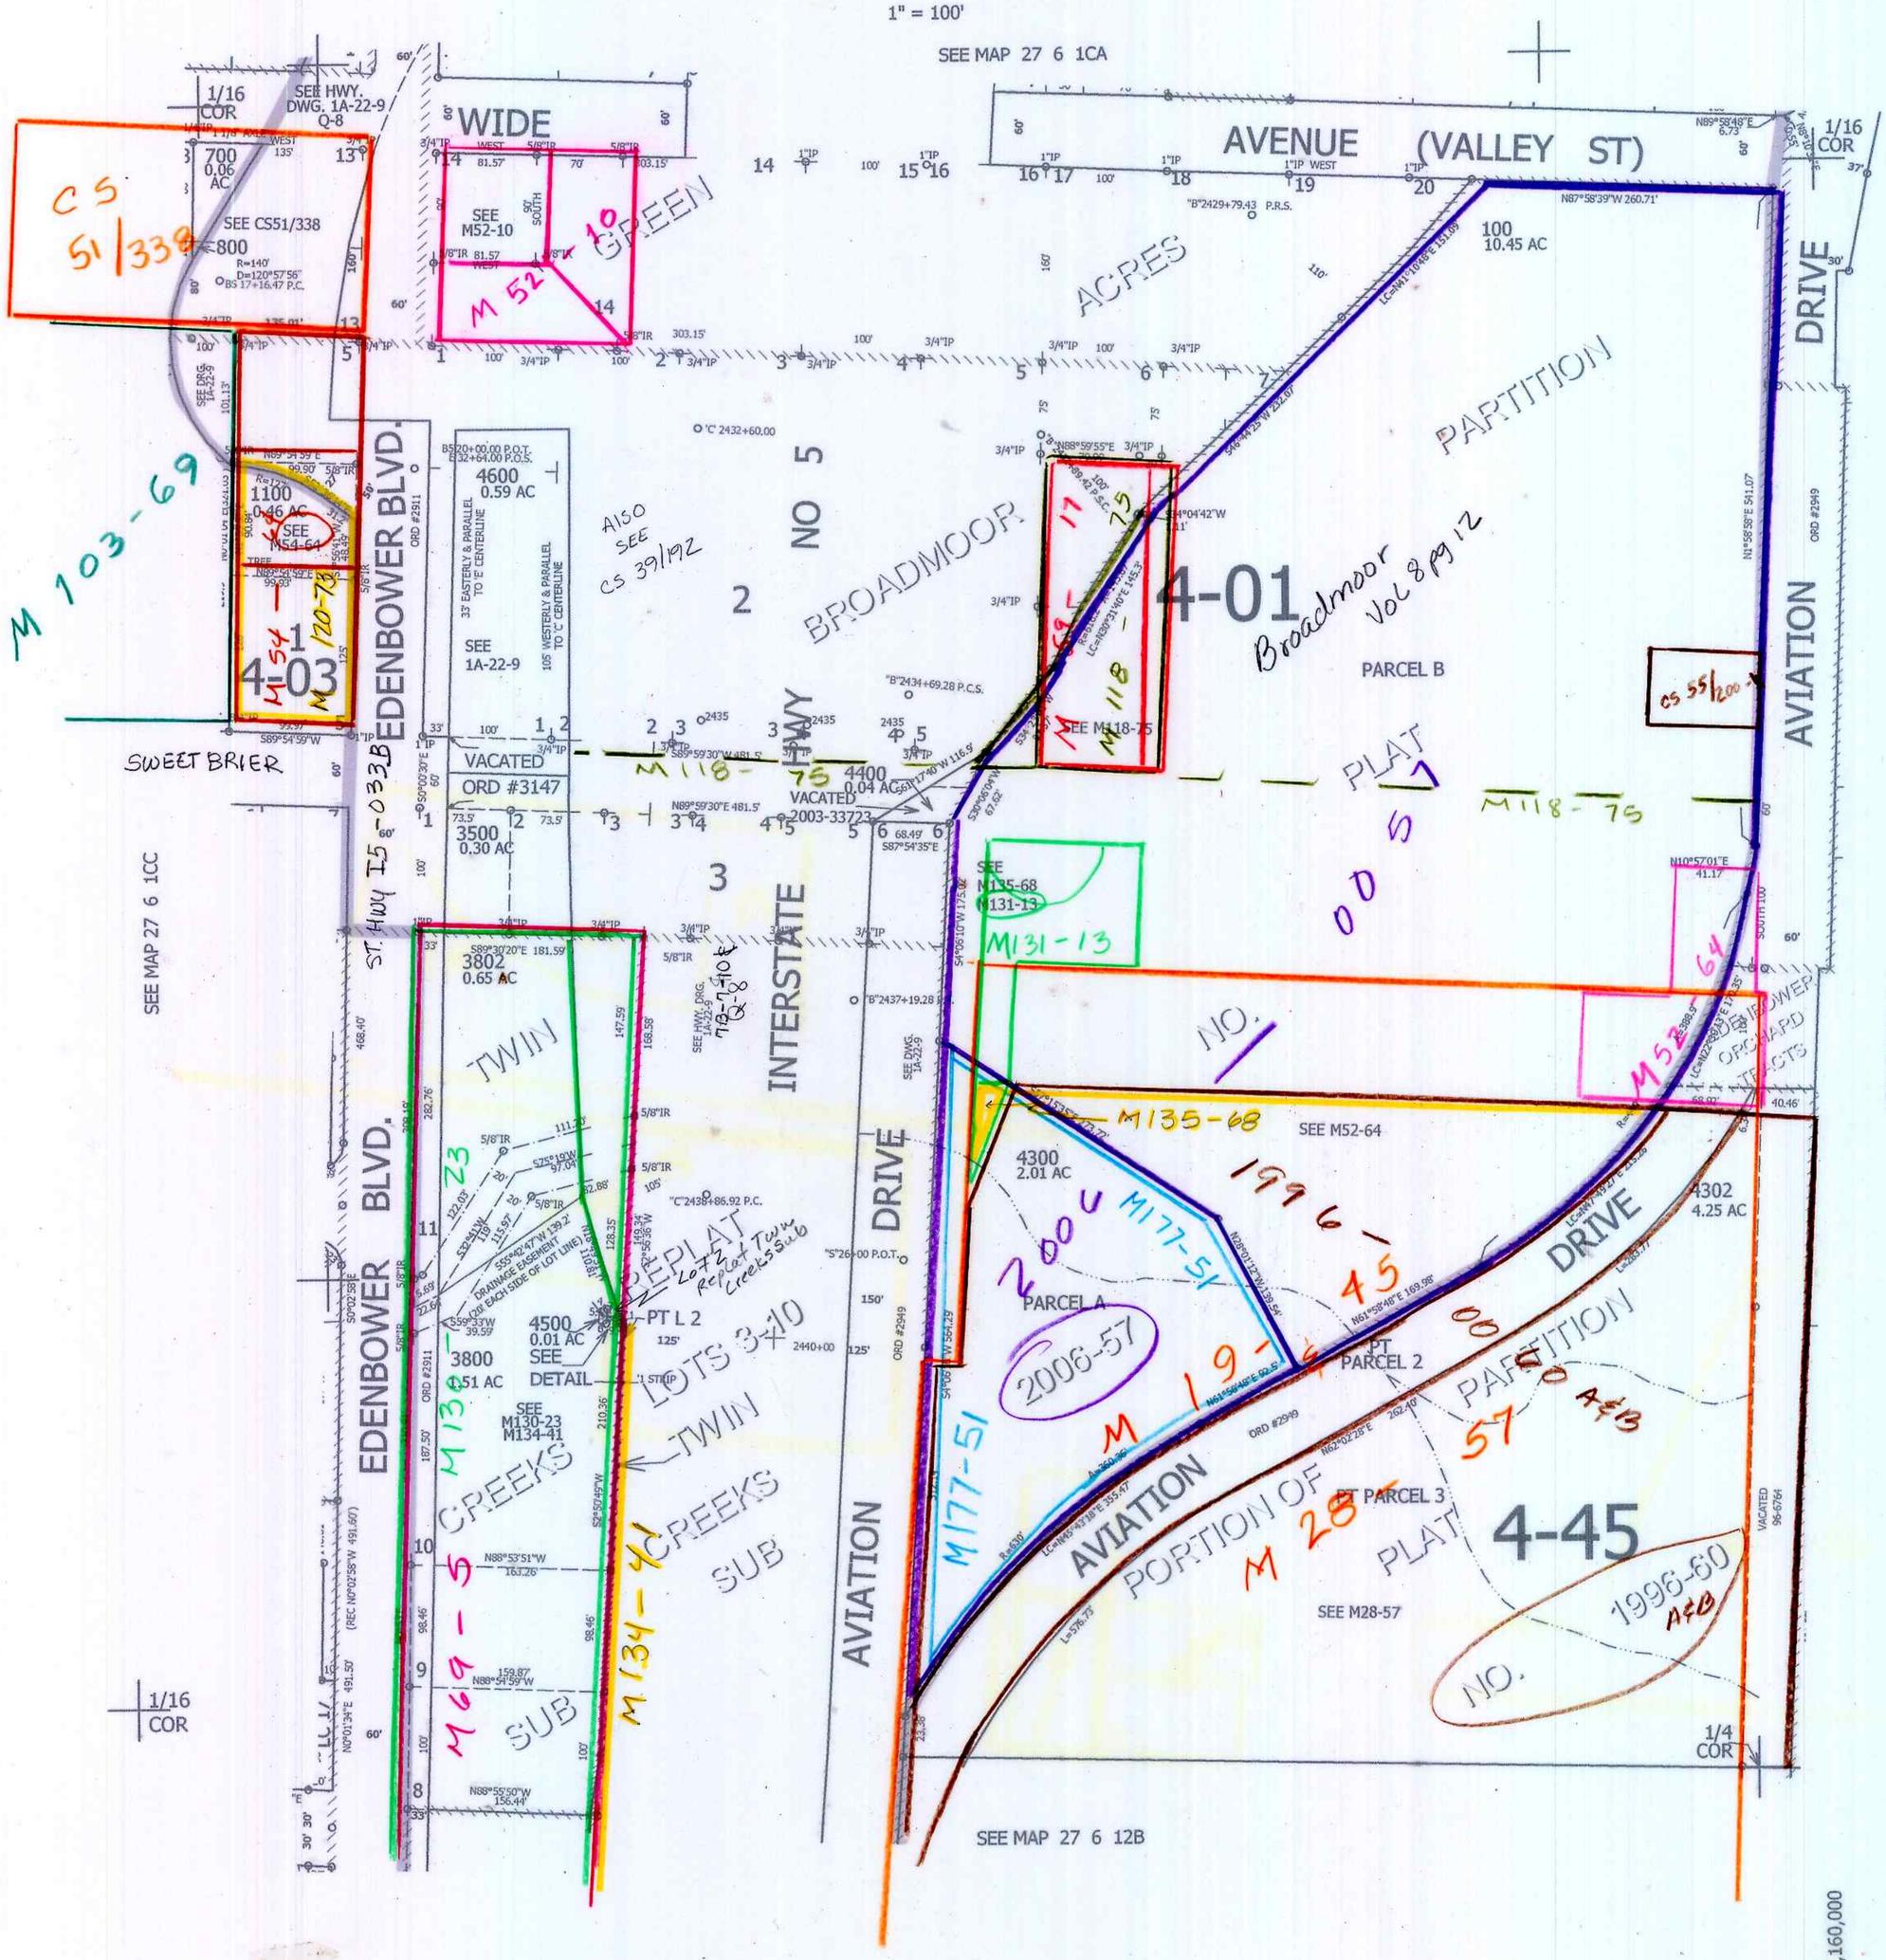

CANCELLED NO'S
1400 101 3702
200 300 1000
600 500 2001
900 1700 4200
1300 3601 1200
3602 400 3701
2600 3801 3901
3600 3700 3900
3703 3301 3401
3302 4401 1500
1600 1800 1900
2000 2100 2200
2300 2400 2500
2601 2700 2800
2900 3000 3100
3200 3300 3400
4000 4100 4303
3402 3800A1
4301

PARCEL 4500
1. N18°49'31"W 9'
2. N87°09'11"W 10.97'
3. N2°50'49"E 5.5'
4. N87°09'11"W 6'
5. S2°50'49"W 12'
6. S87°09'11"E 6'
7. N2°50'49"E 5.5'
8. S87°09'11"E 10.29'
9. S18°49'31"E 8.13'

DETAIL 1" = 50'

CW 7/6/06 JCV

27 6 1CD
ROSEBURG