THIS MAP WAS PREPARED FOR ASSESSMENT PURPOSE ONLY

NW1/4 SE1/4 SEC. 1 T.27S. R.6 W W.M.
DOUGLAS COUNTY

1"=100'

REVISED ON 8-7-00

27 6 1DB
ROSEBURG

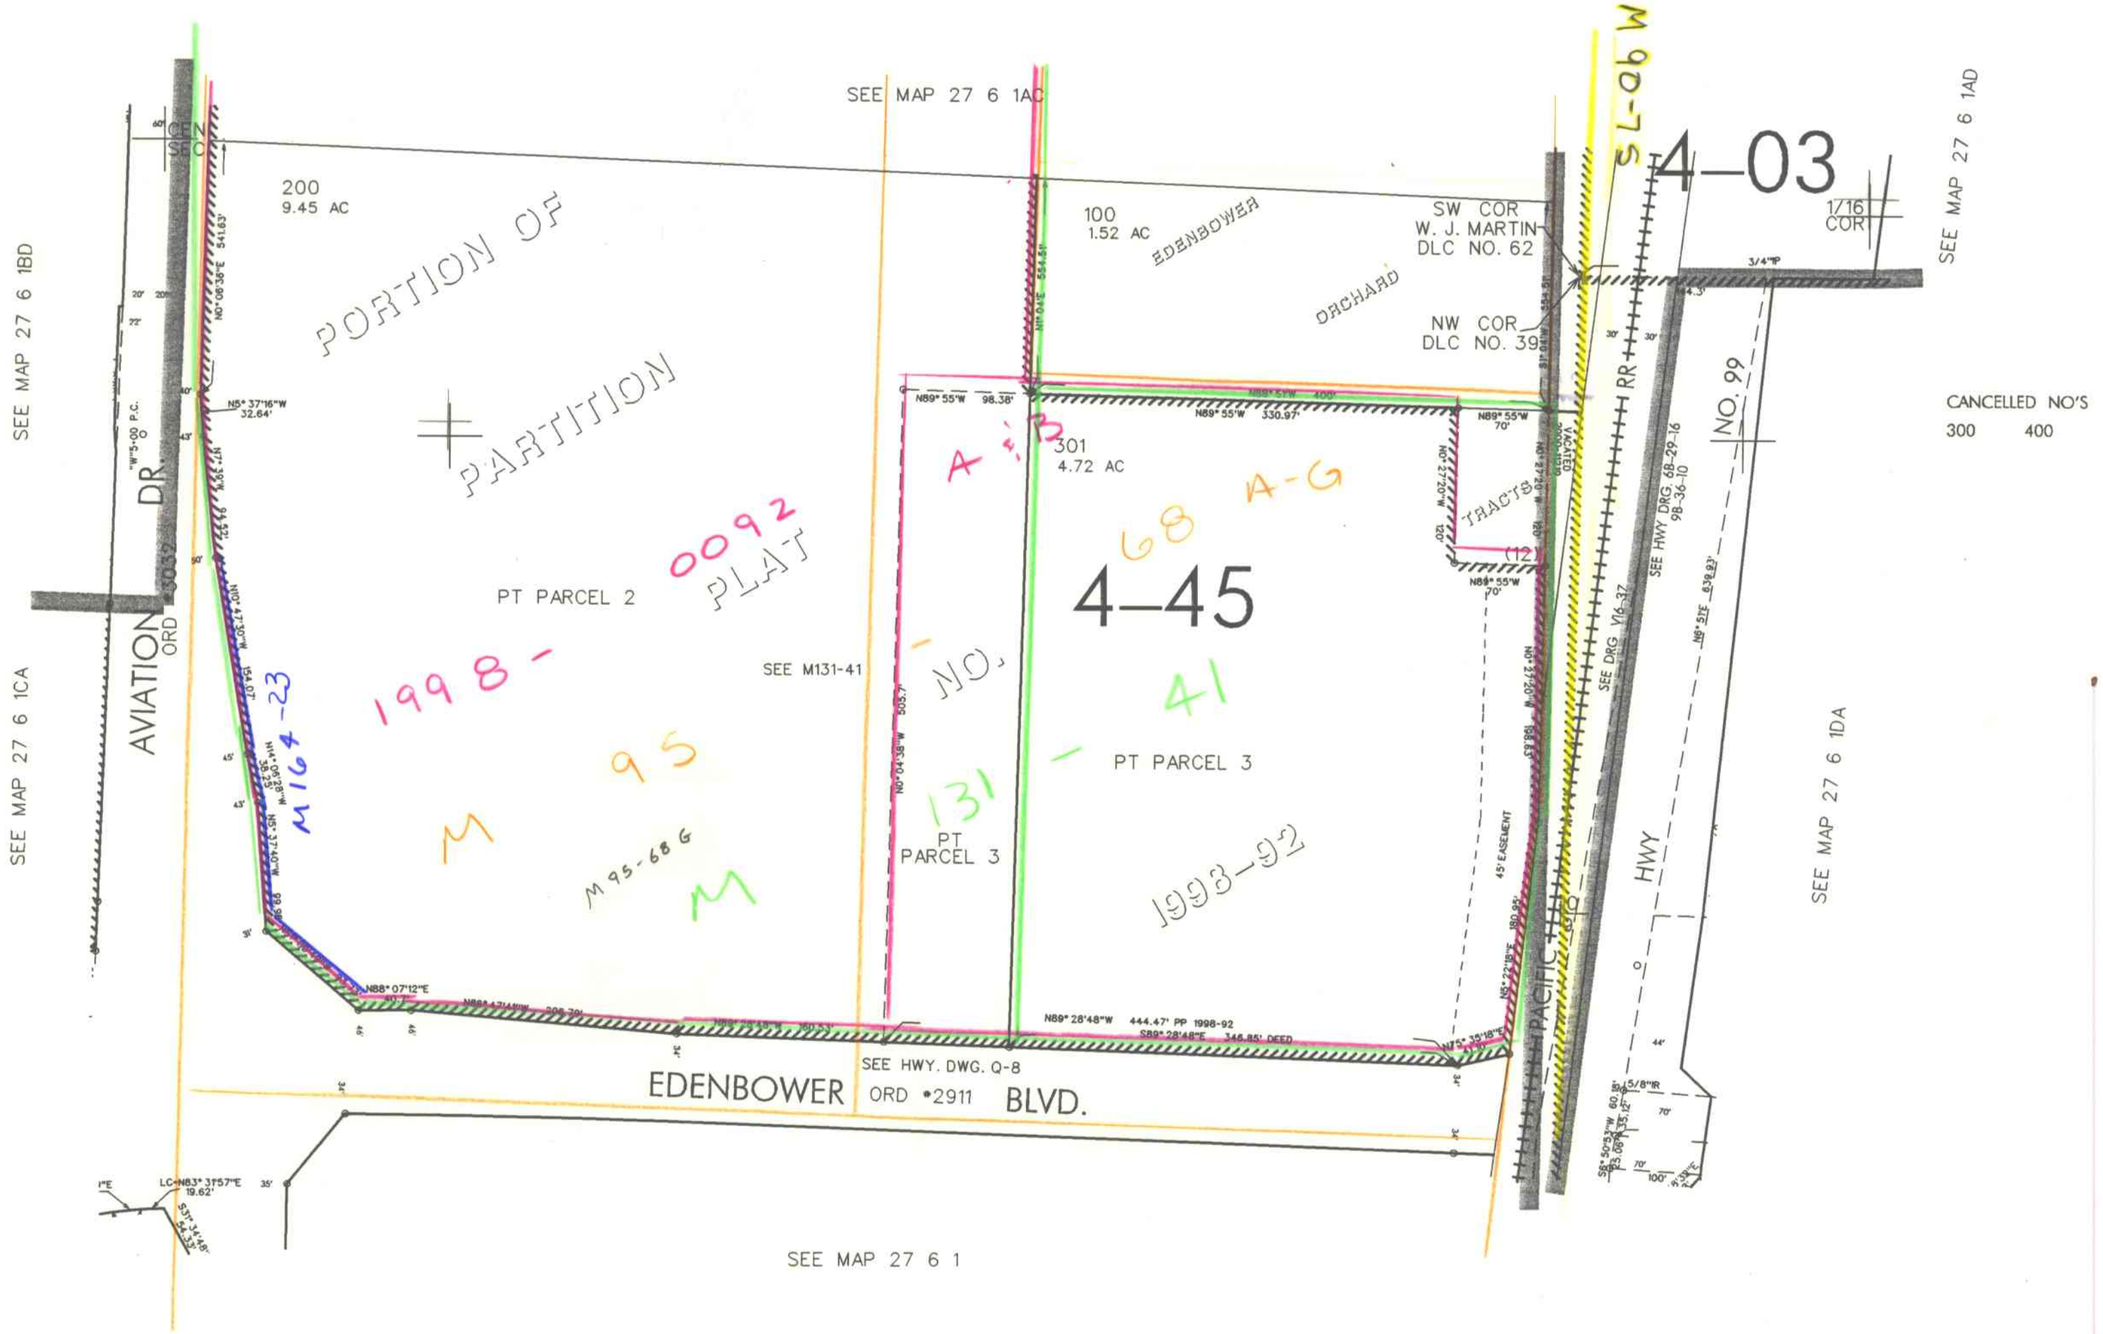

589,000

1/16 COR

4,161,500

1/16 COR

27 6 1DB
ROSEBURG

JC 11/98
JP