THIS MAP WAS PREPARED FOR ASSESSMENT PURPOSE ONLY.

SE1/4 SEC.6 T.27S. R.6W. W.M.
DOUGLAS COUNTY

1" = 200'

REVISED ON 12-29-21
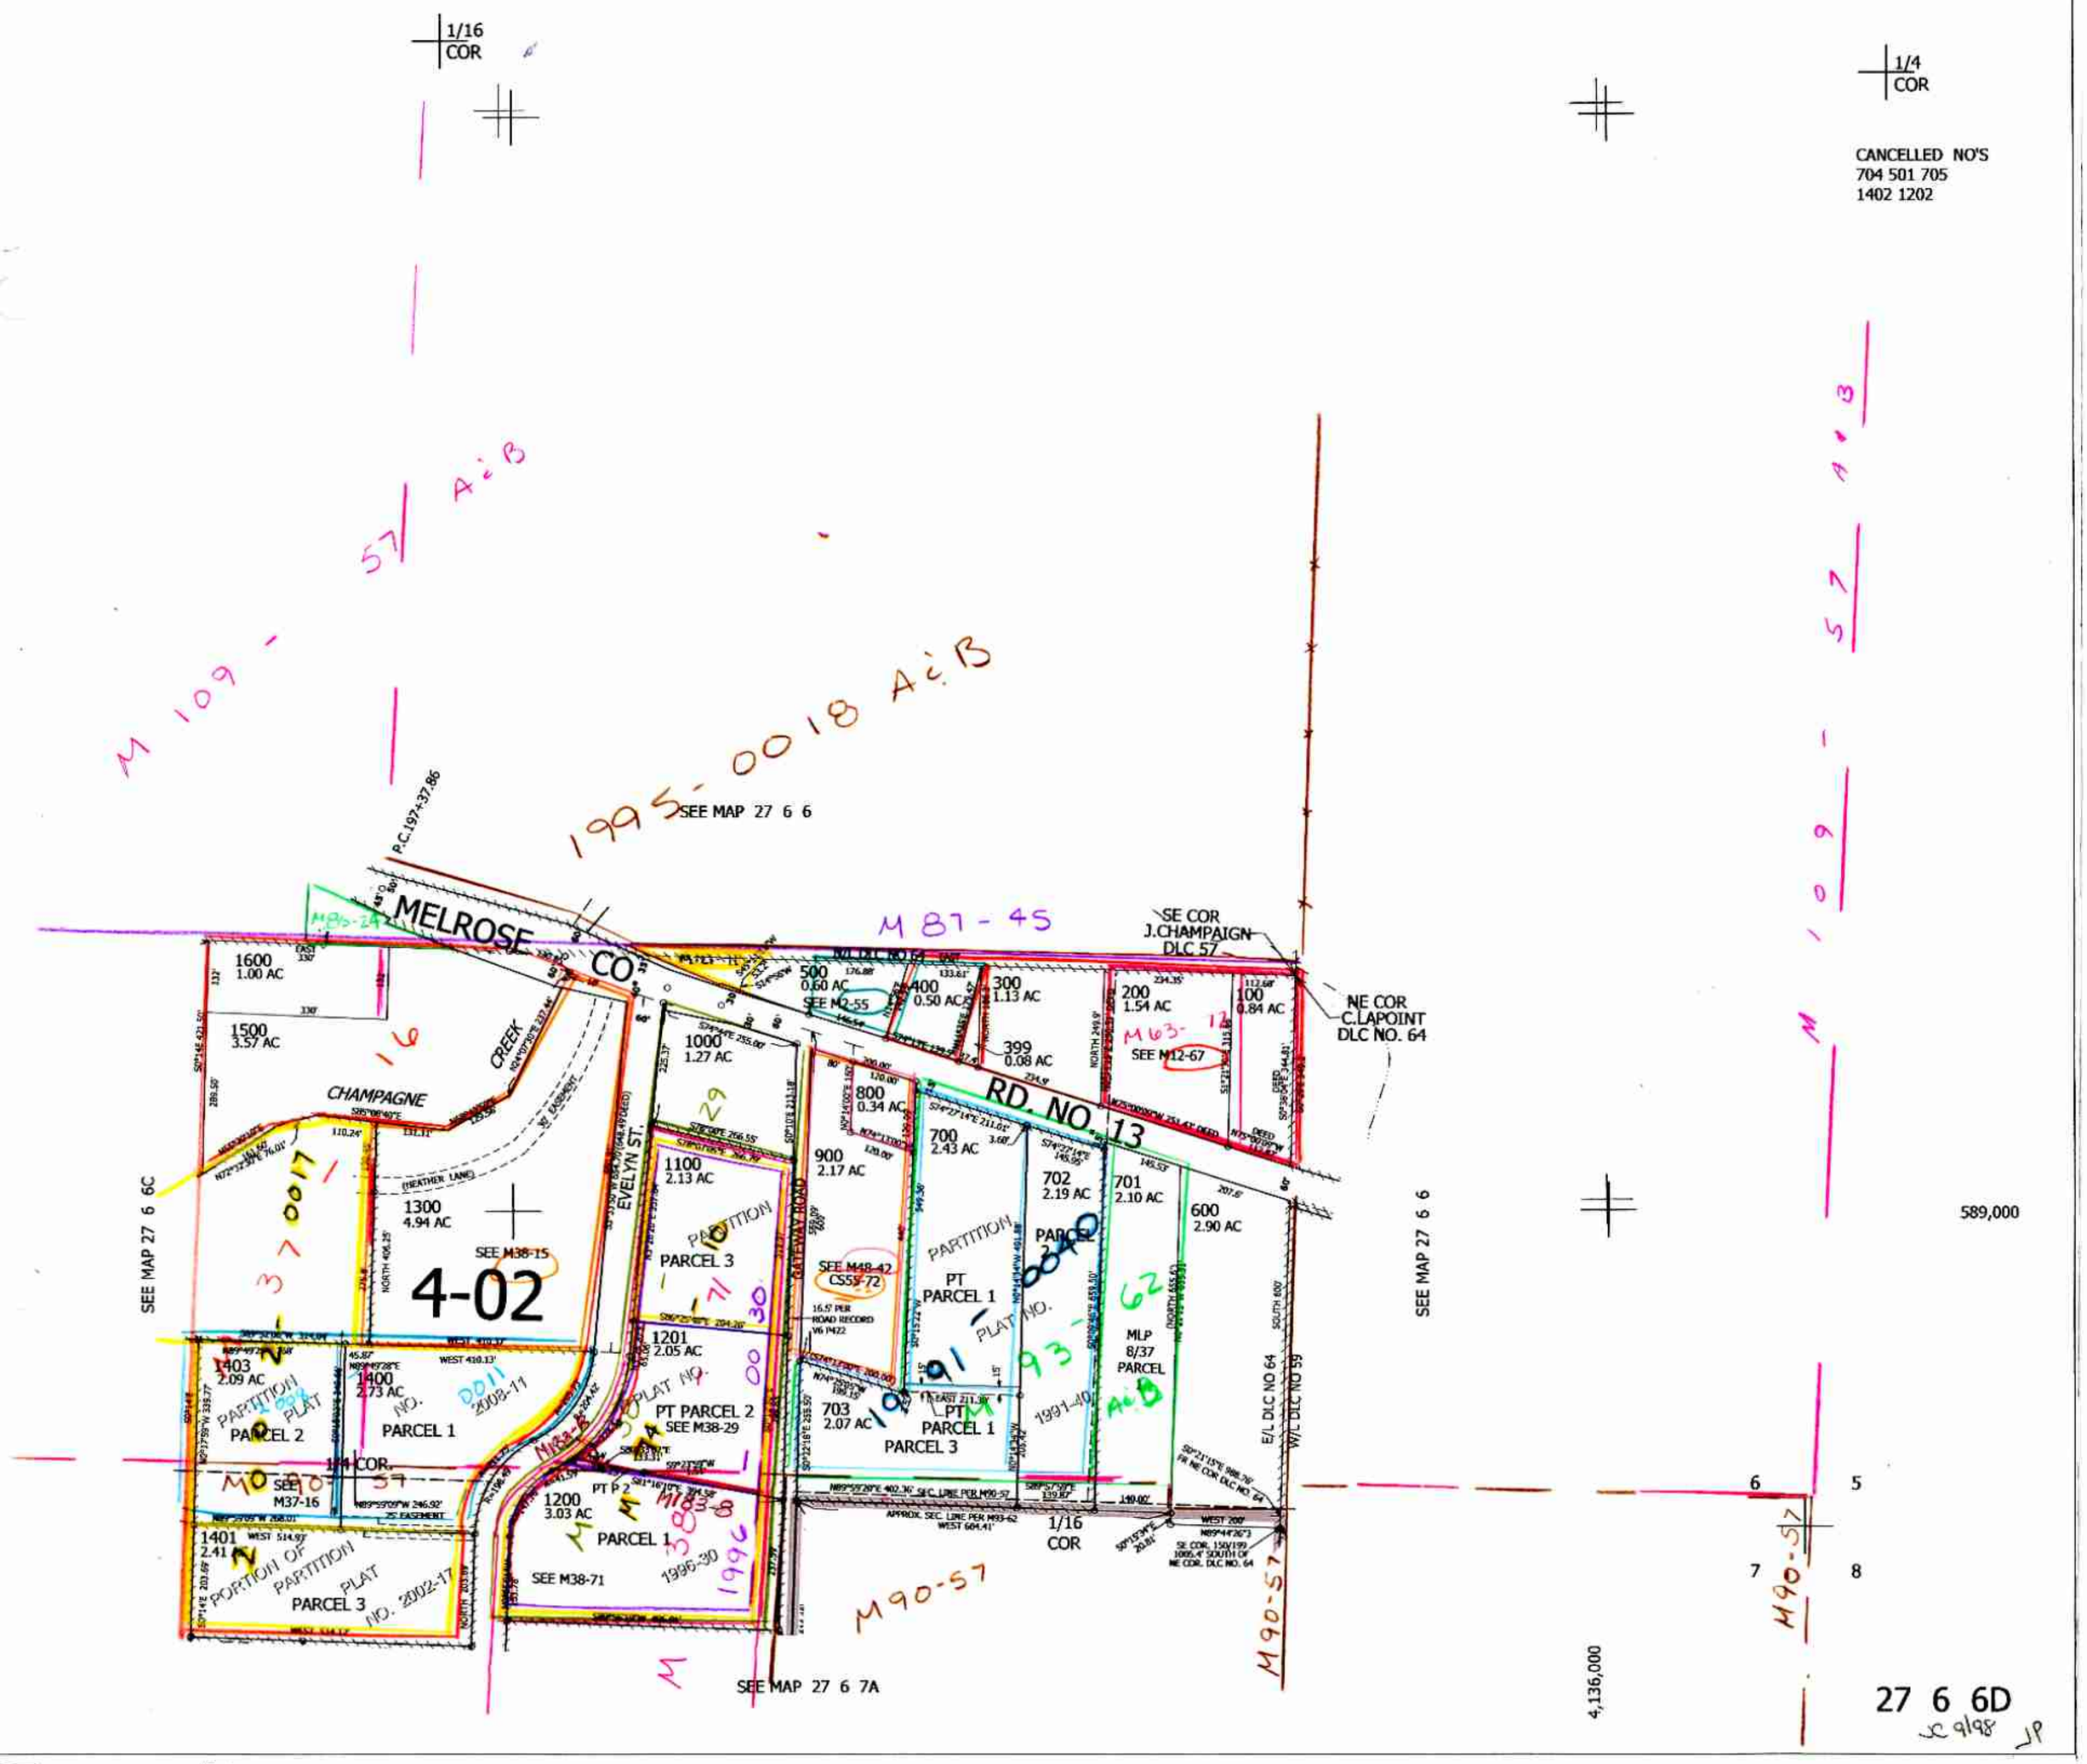
27 6 6D