


THIS MAP WAS PREPARED FOR ASSESSMENT PURPOSE ONLY.

NE1/4 NW1/4 SEC.11 T.27S. R.6W. W.M. DOUGLAS COUNTY

REVISED ON 4-20-17

27 6 11BA ROSEBURG

1" = 100'

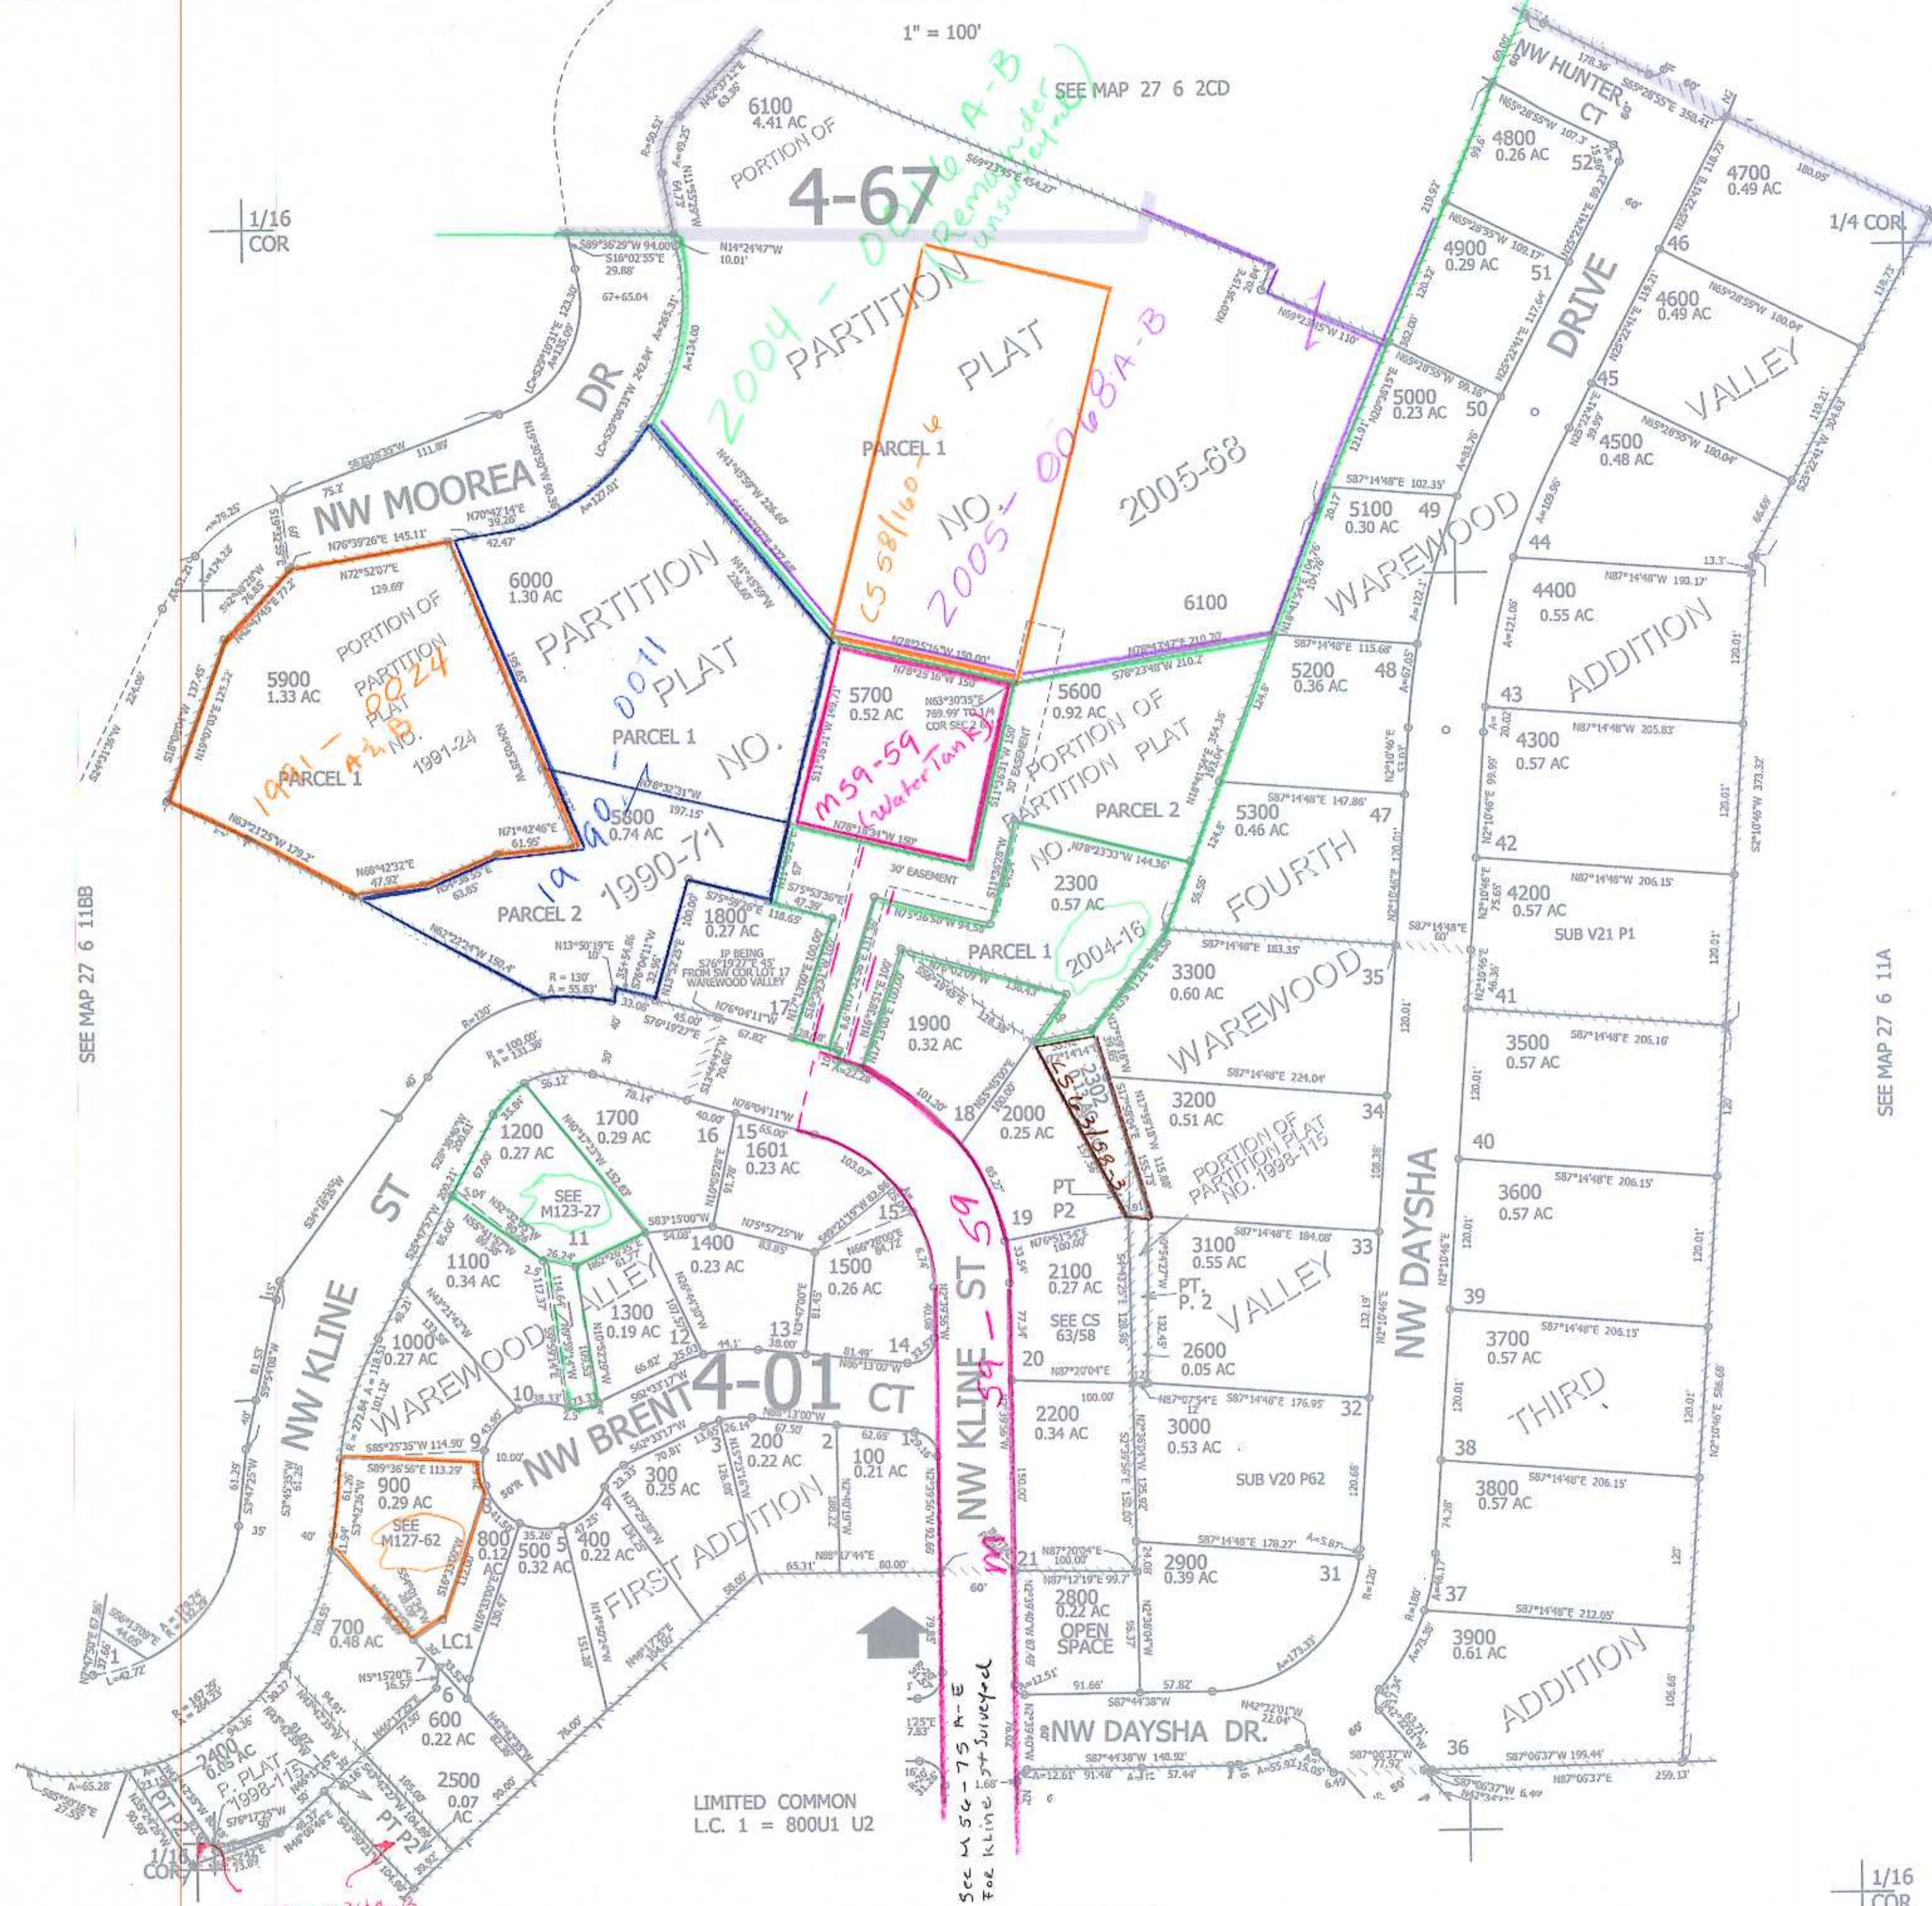

CANCELLED NO'S
901 1600 1101
2301 1201 2303
4100 3400 2304
2700 5500 6101
4000 5400

SEE MAP 27 6 11BB

SEE MAP 27 6 11A

SEE MAP 27 6 11BC

SEE MAP 27 6 11BD

1991-0024A-B
1998-0115A-B
(Portions of remainder
Parcels unsurveyed.)

See M 54 - 75 A-E
For Kline St Surveyed

LIMITED COMMON
L.C. 1 = 800U1 U2

586,500

1/16
COR

4,154,500

CM
9/11/14
JC
27 6 11BA
ROSEBURG