SW1/4NE1/4 SEC. 12 T.27S. R.6W. W.M.
DOUGLAS COUNTY

1"=100'

THIS MAP WAS PREPARED FOR ASSESSMENT PURPOSE ONLY.

REVISED ON 1-20-93
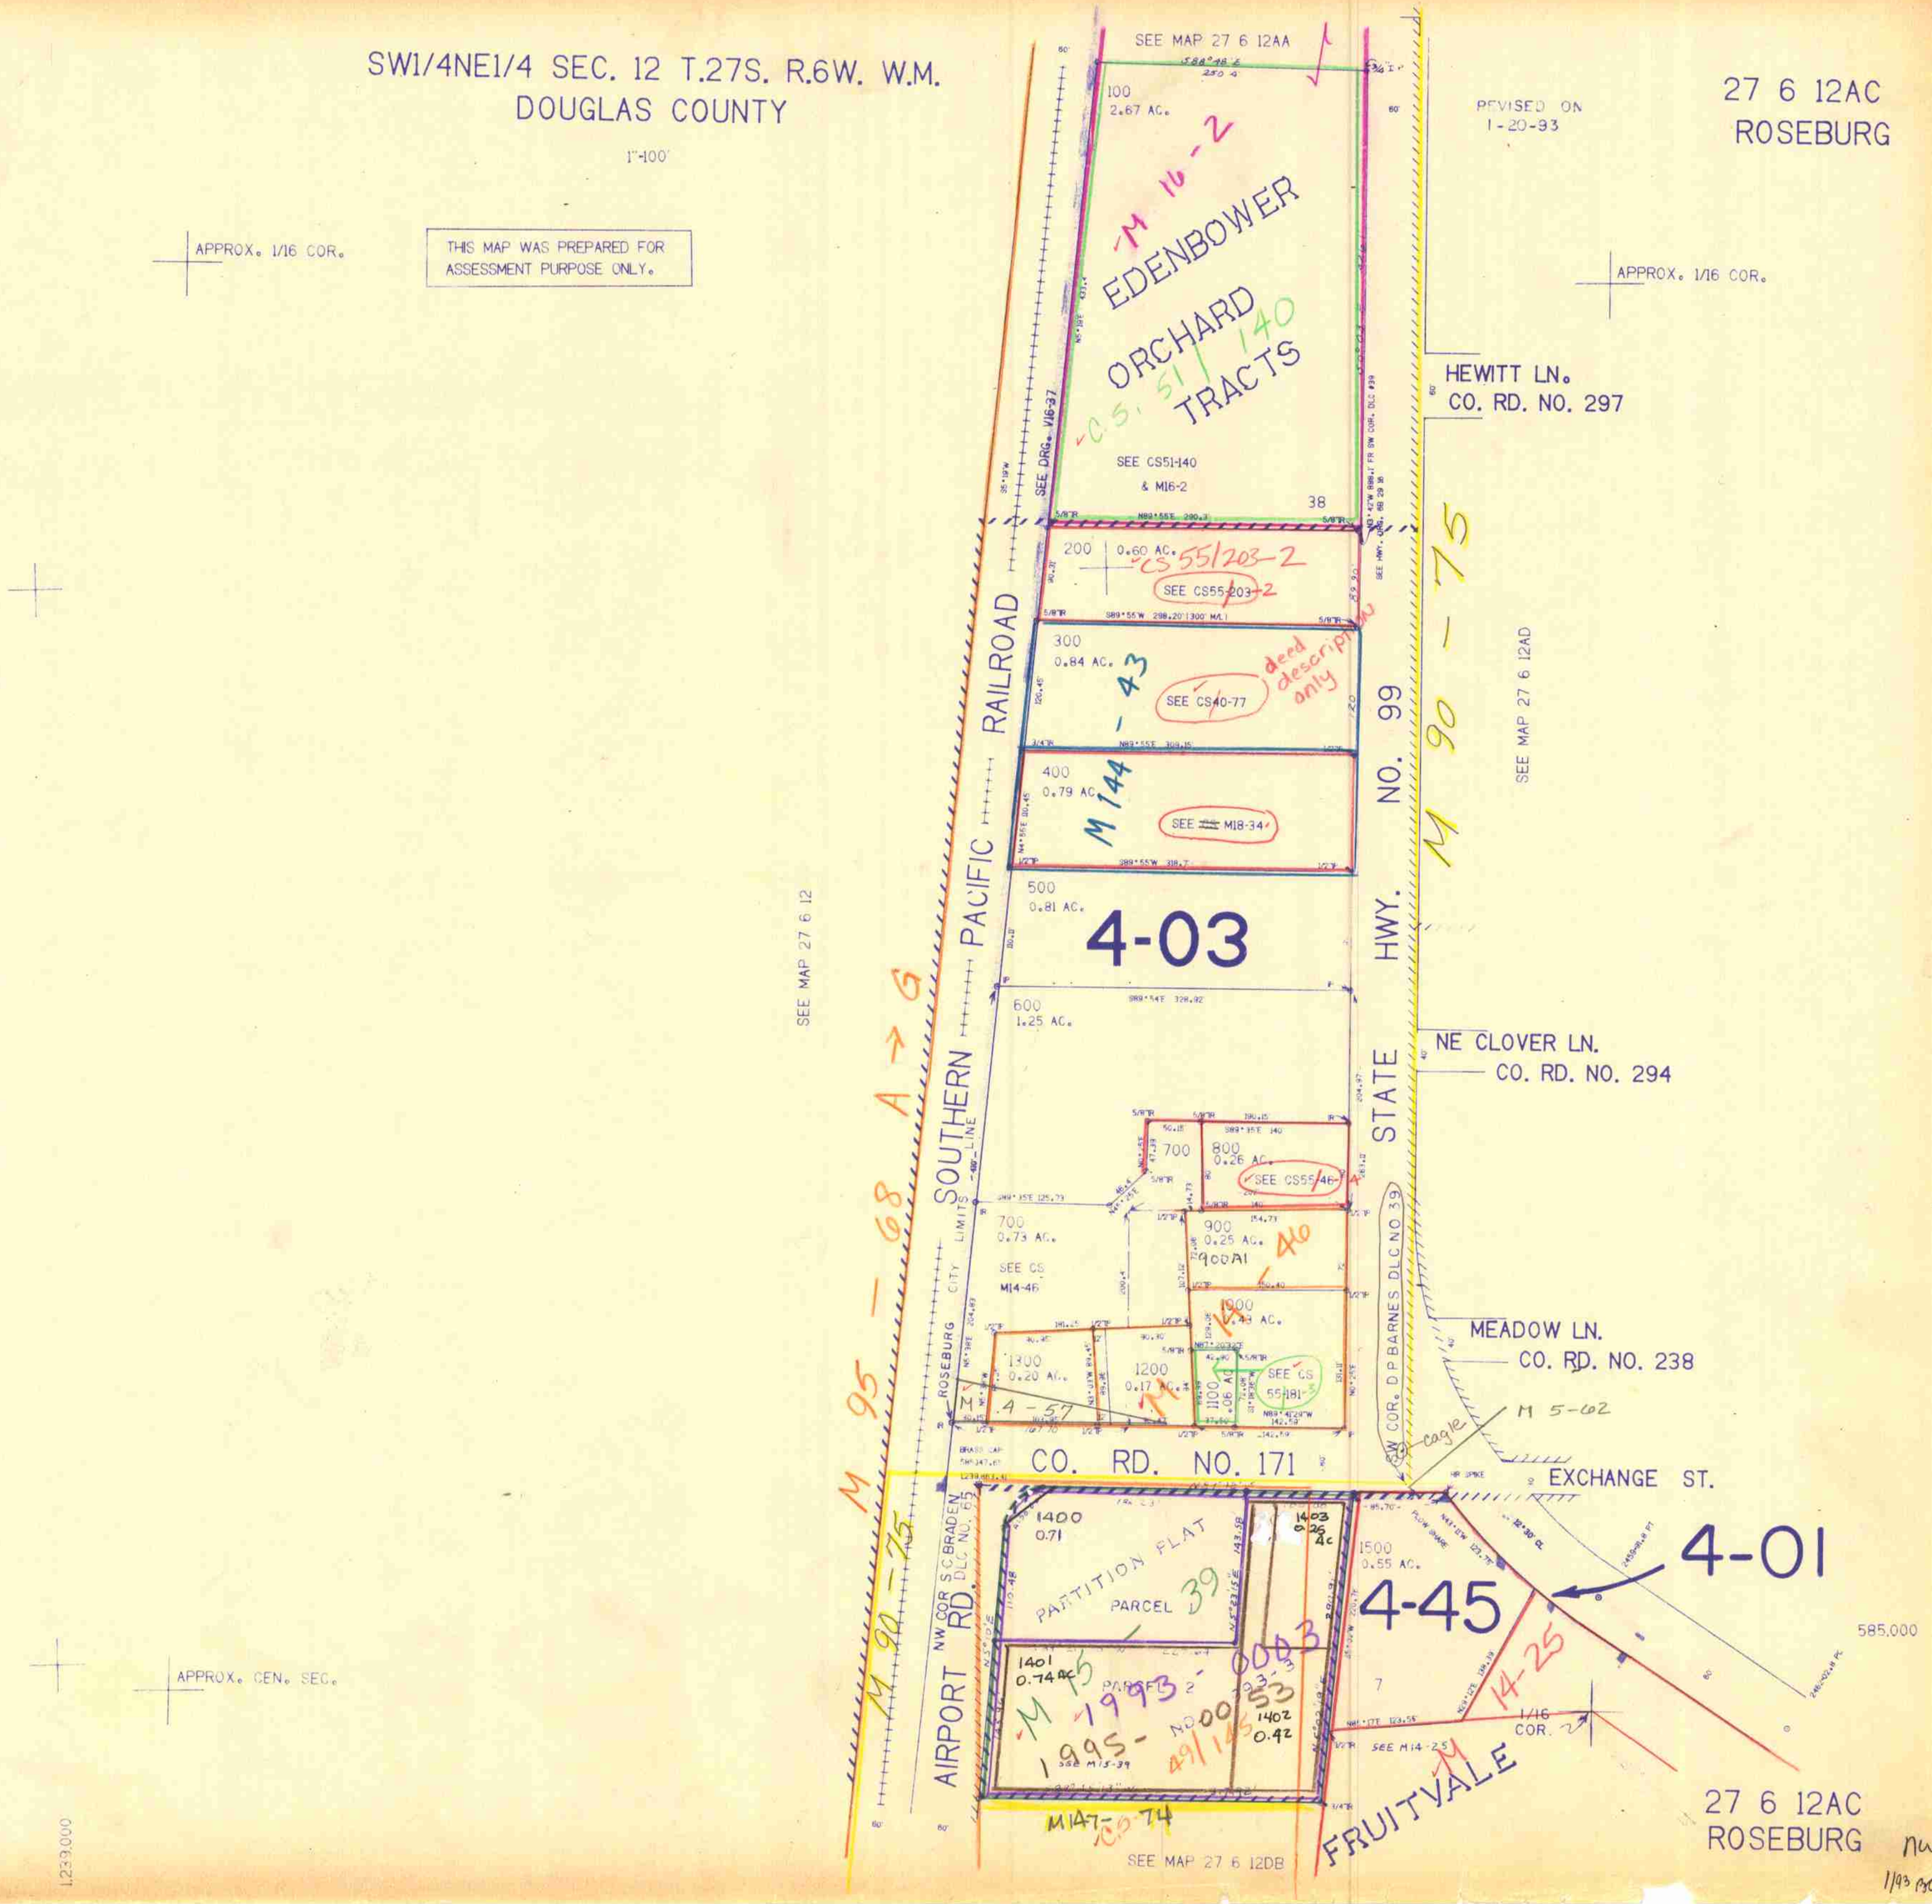
27 6 12AC
ROSEBURG