THIS MAP WAS PREPARED FOR ASSESSMENT PURPOSE ONLY.

NW1/4 SE1/4 SEC.14 T.27S. R.6W. W.M.
DOUGLAS COUNTY

1" = 100'

REVISED ON 2-3-20

27 6 14DB
ROSEBURG

SEE MAP 27 6 14AC

CEN SEC

1/16 COR

CANCELLED NO'S
800 300 400
801 201 2900
104 105 203
204 205 200
202

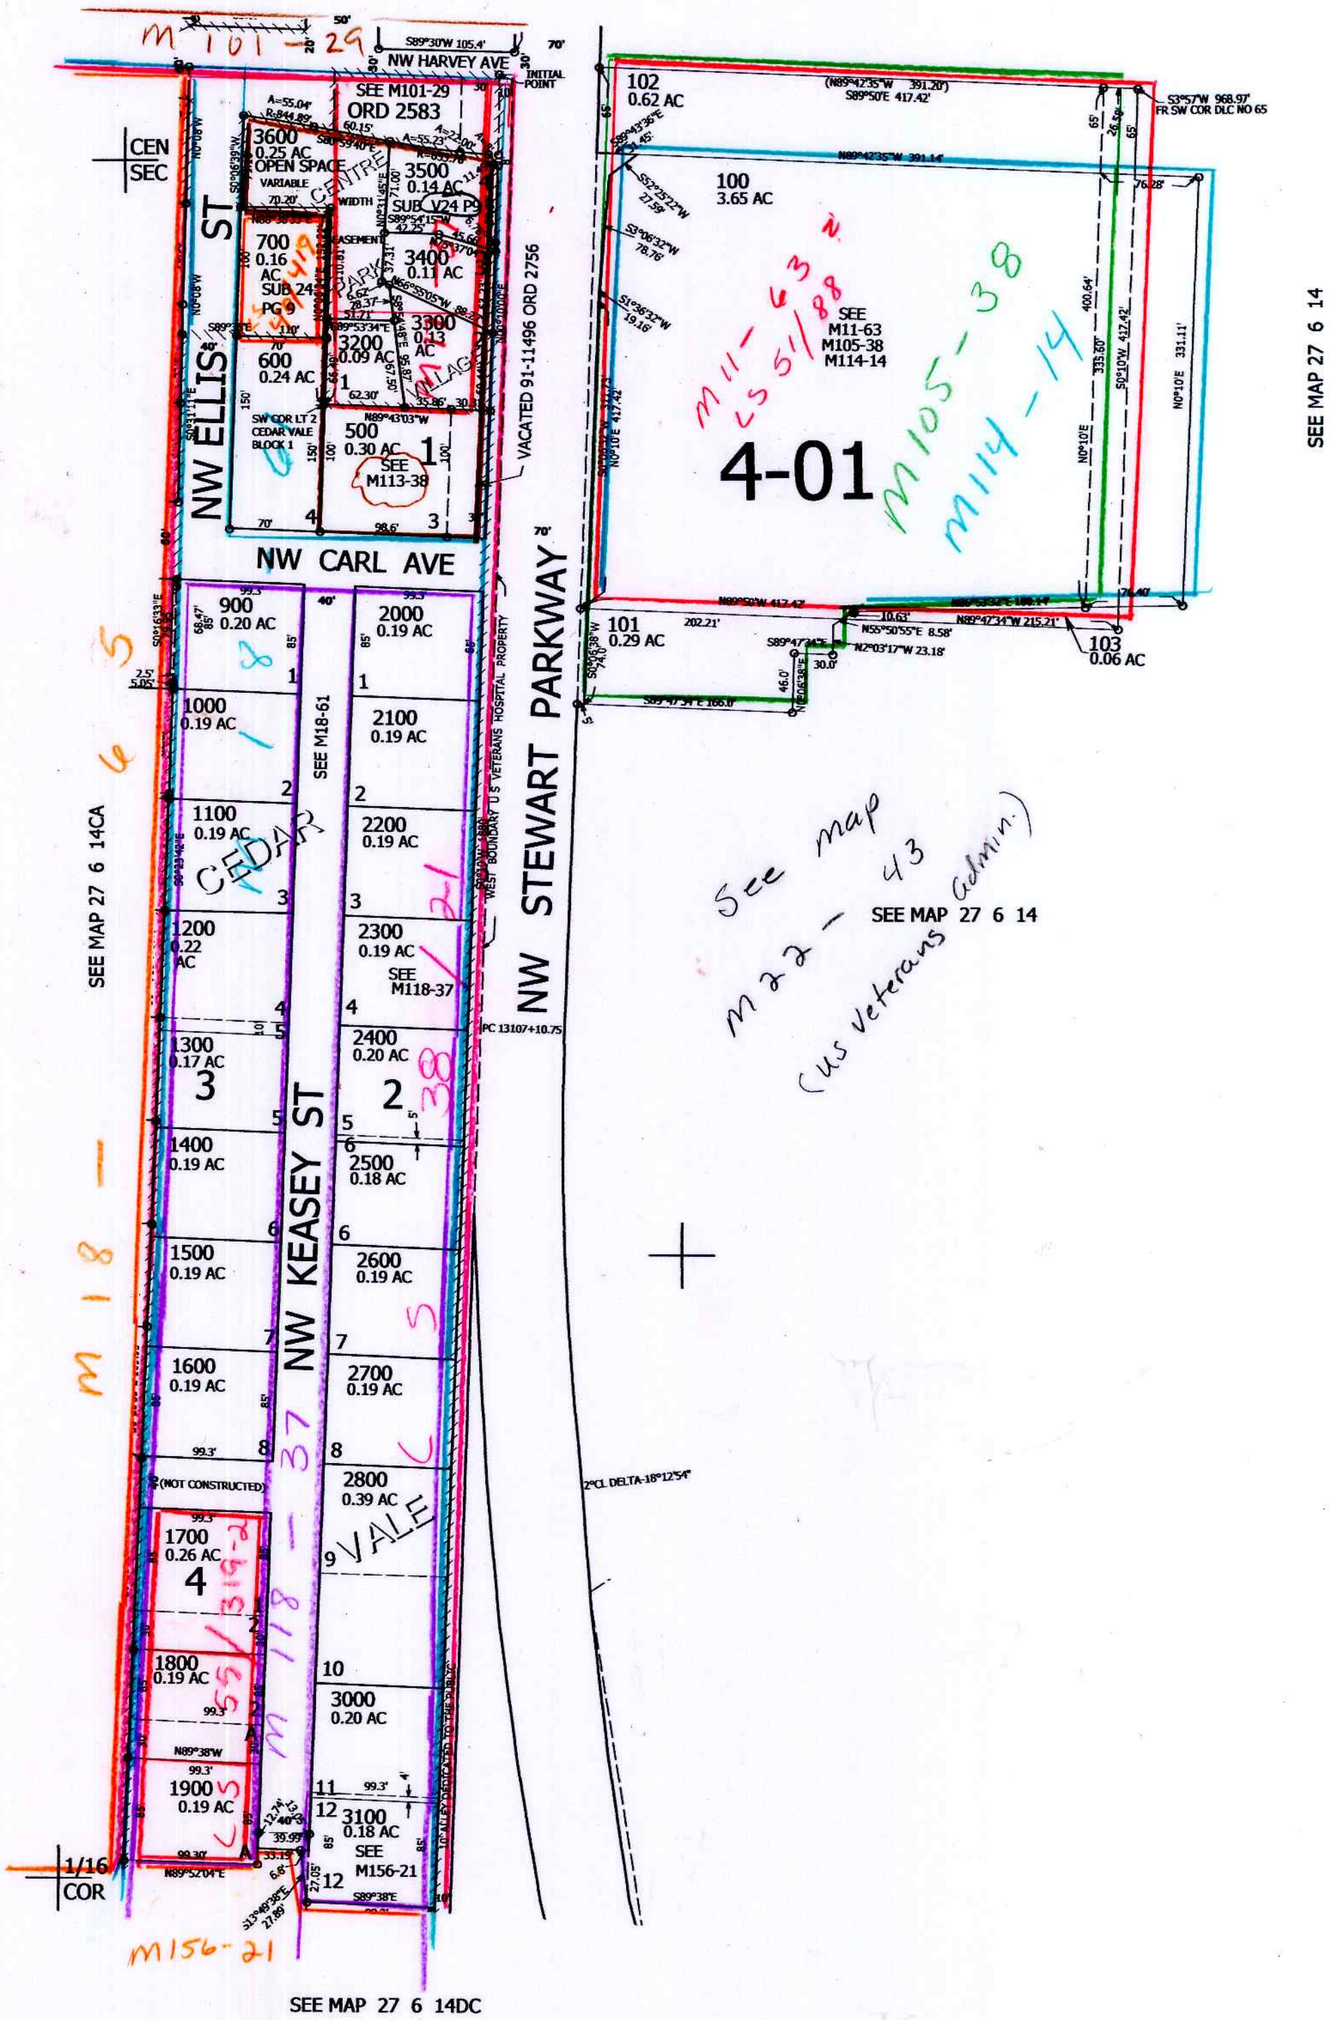

579,000

4,156,000

27 6 14DB
ROSEBURG