

NW1/4 SW1/4 SEC. 15 T.27S. R.6W. W.M.  
DOUGLAS COUNTY

REVISED ON  
10-26-92

27 6 15CB


1"=100'

THIS MAP WAS PREPARED FOR  
ASSESSMENT PURPOSE ONLY.

SEE MAP 27 6 15BC

SEE MAP 27 6 16AD

SEE MAP 27 6 15CA

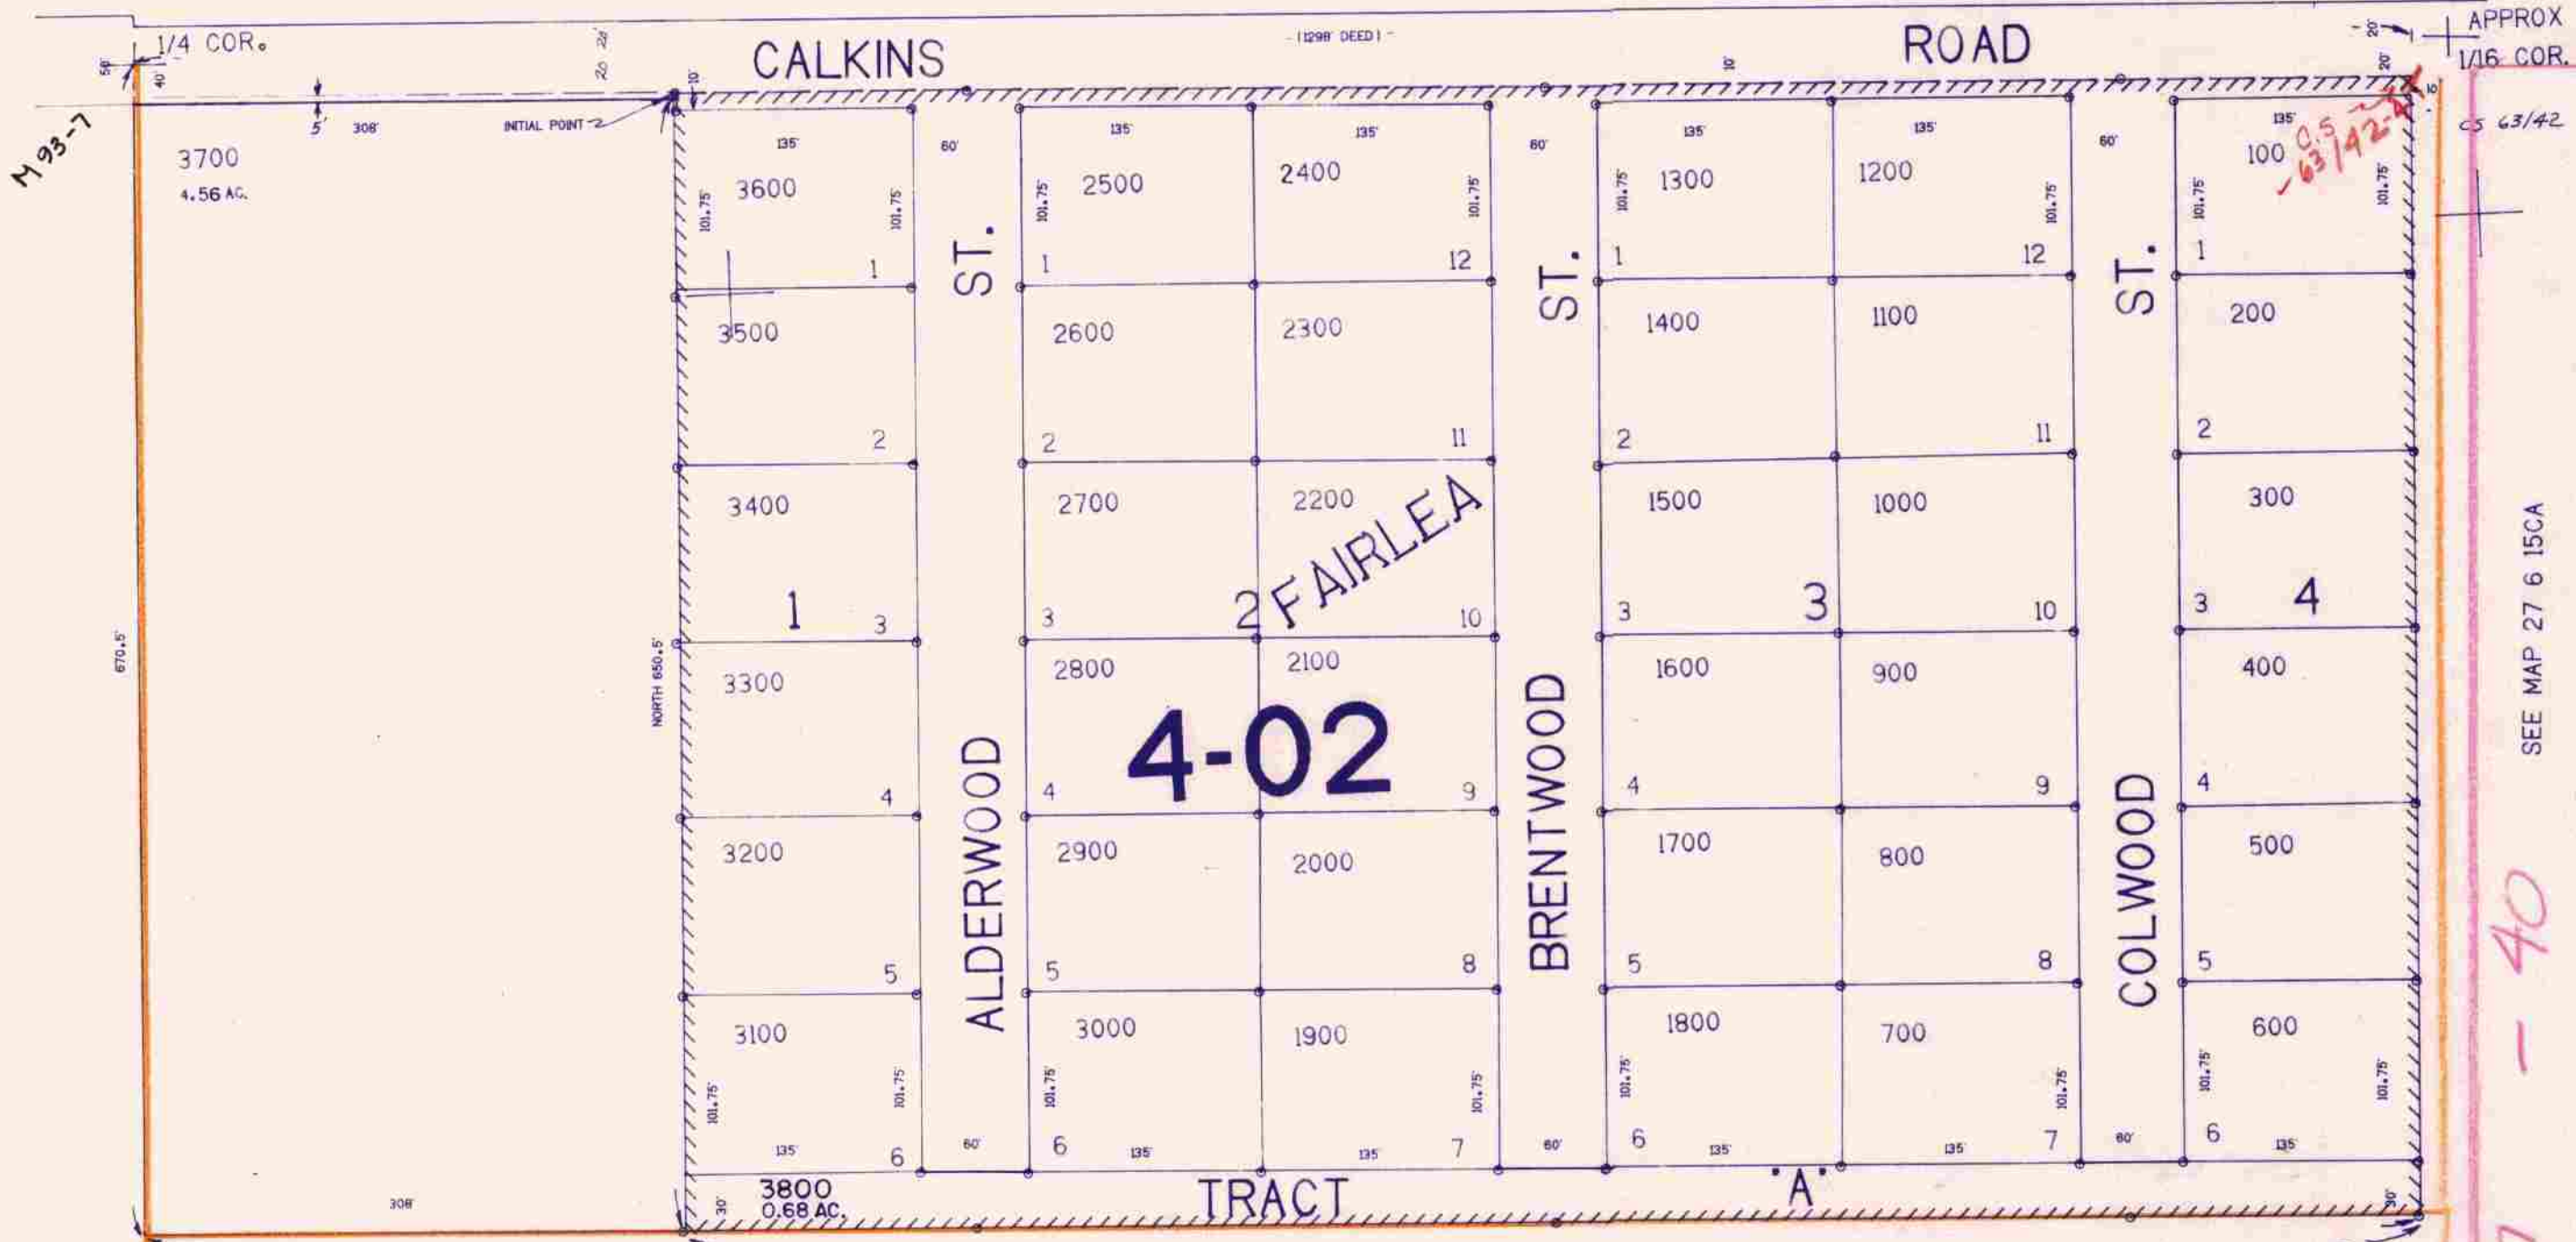

4-02

2 FAIRLEA

M 18 - 68  
M 18 - 68  
M 18 - 69

M 27 - 40

579.000

APPROX  
1/16 COR.

1,227,000

27 6 15CB

10/12/92