THIS MAP WAS PREPARED FOR ASSESSMENT PURPOSE ONLY.

Upper Left:
123°25'45"W 43°13'47"N
4140780E 583264N ft

NW1/4 SEC.16 T.27S. R.06W. W.M.
DOUGLAS COUNTY
1" = 200'

Date Exported 2025-12-22

2706 16B

CANCELLED NO'S
301 1604 3001
3102 1701 602
701

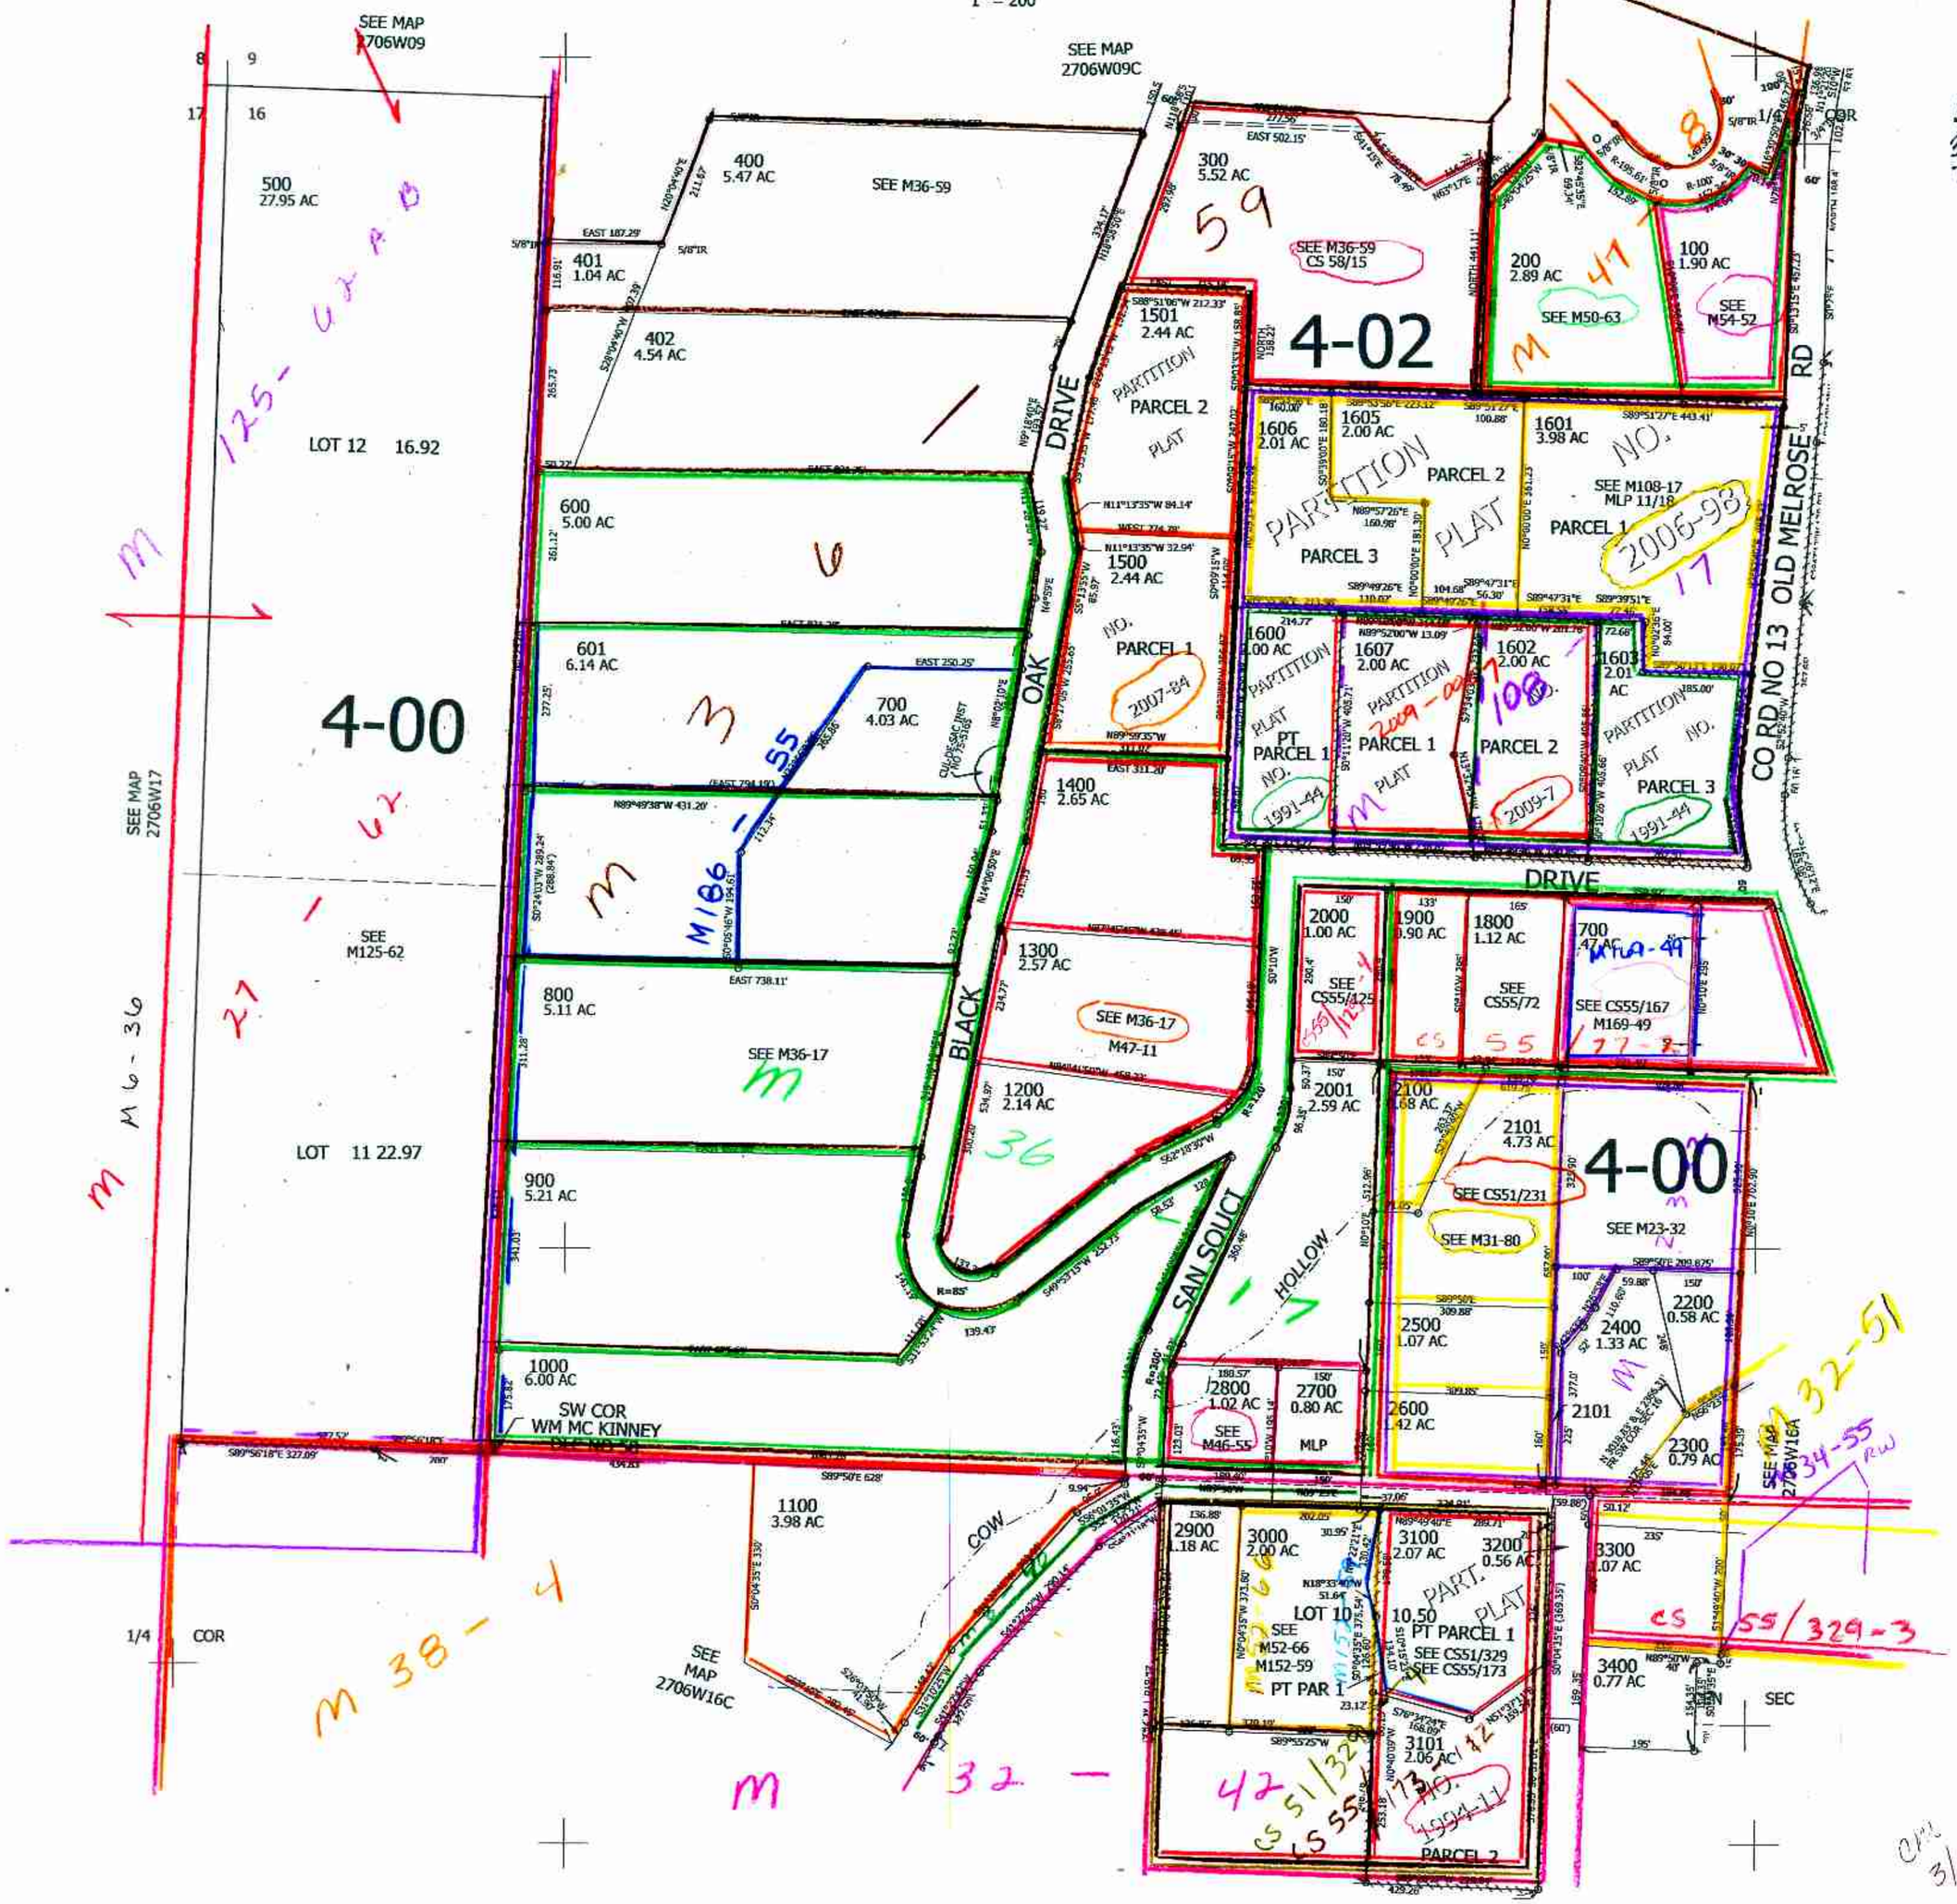

Lower Right:
123°24'51"W 43°13'12"N

2706 16B