

THIS MAP WAS PREPARED FOR ASSESSMENT PURPOSE ONLY


SEV4 SEC. 20 T.27S. R.6 W W.M. DOUGLAS COUNTY

REVISED ON 11-19-02

27 6 20D

1"=200'

SEE MAP 27 6 20A

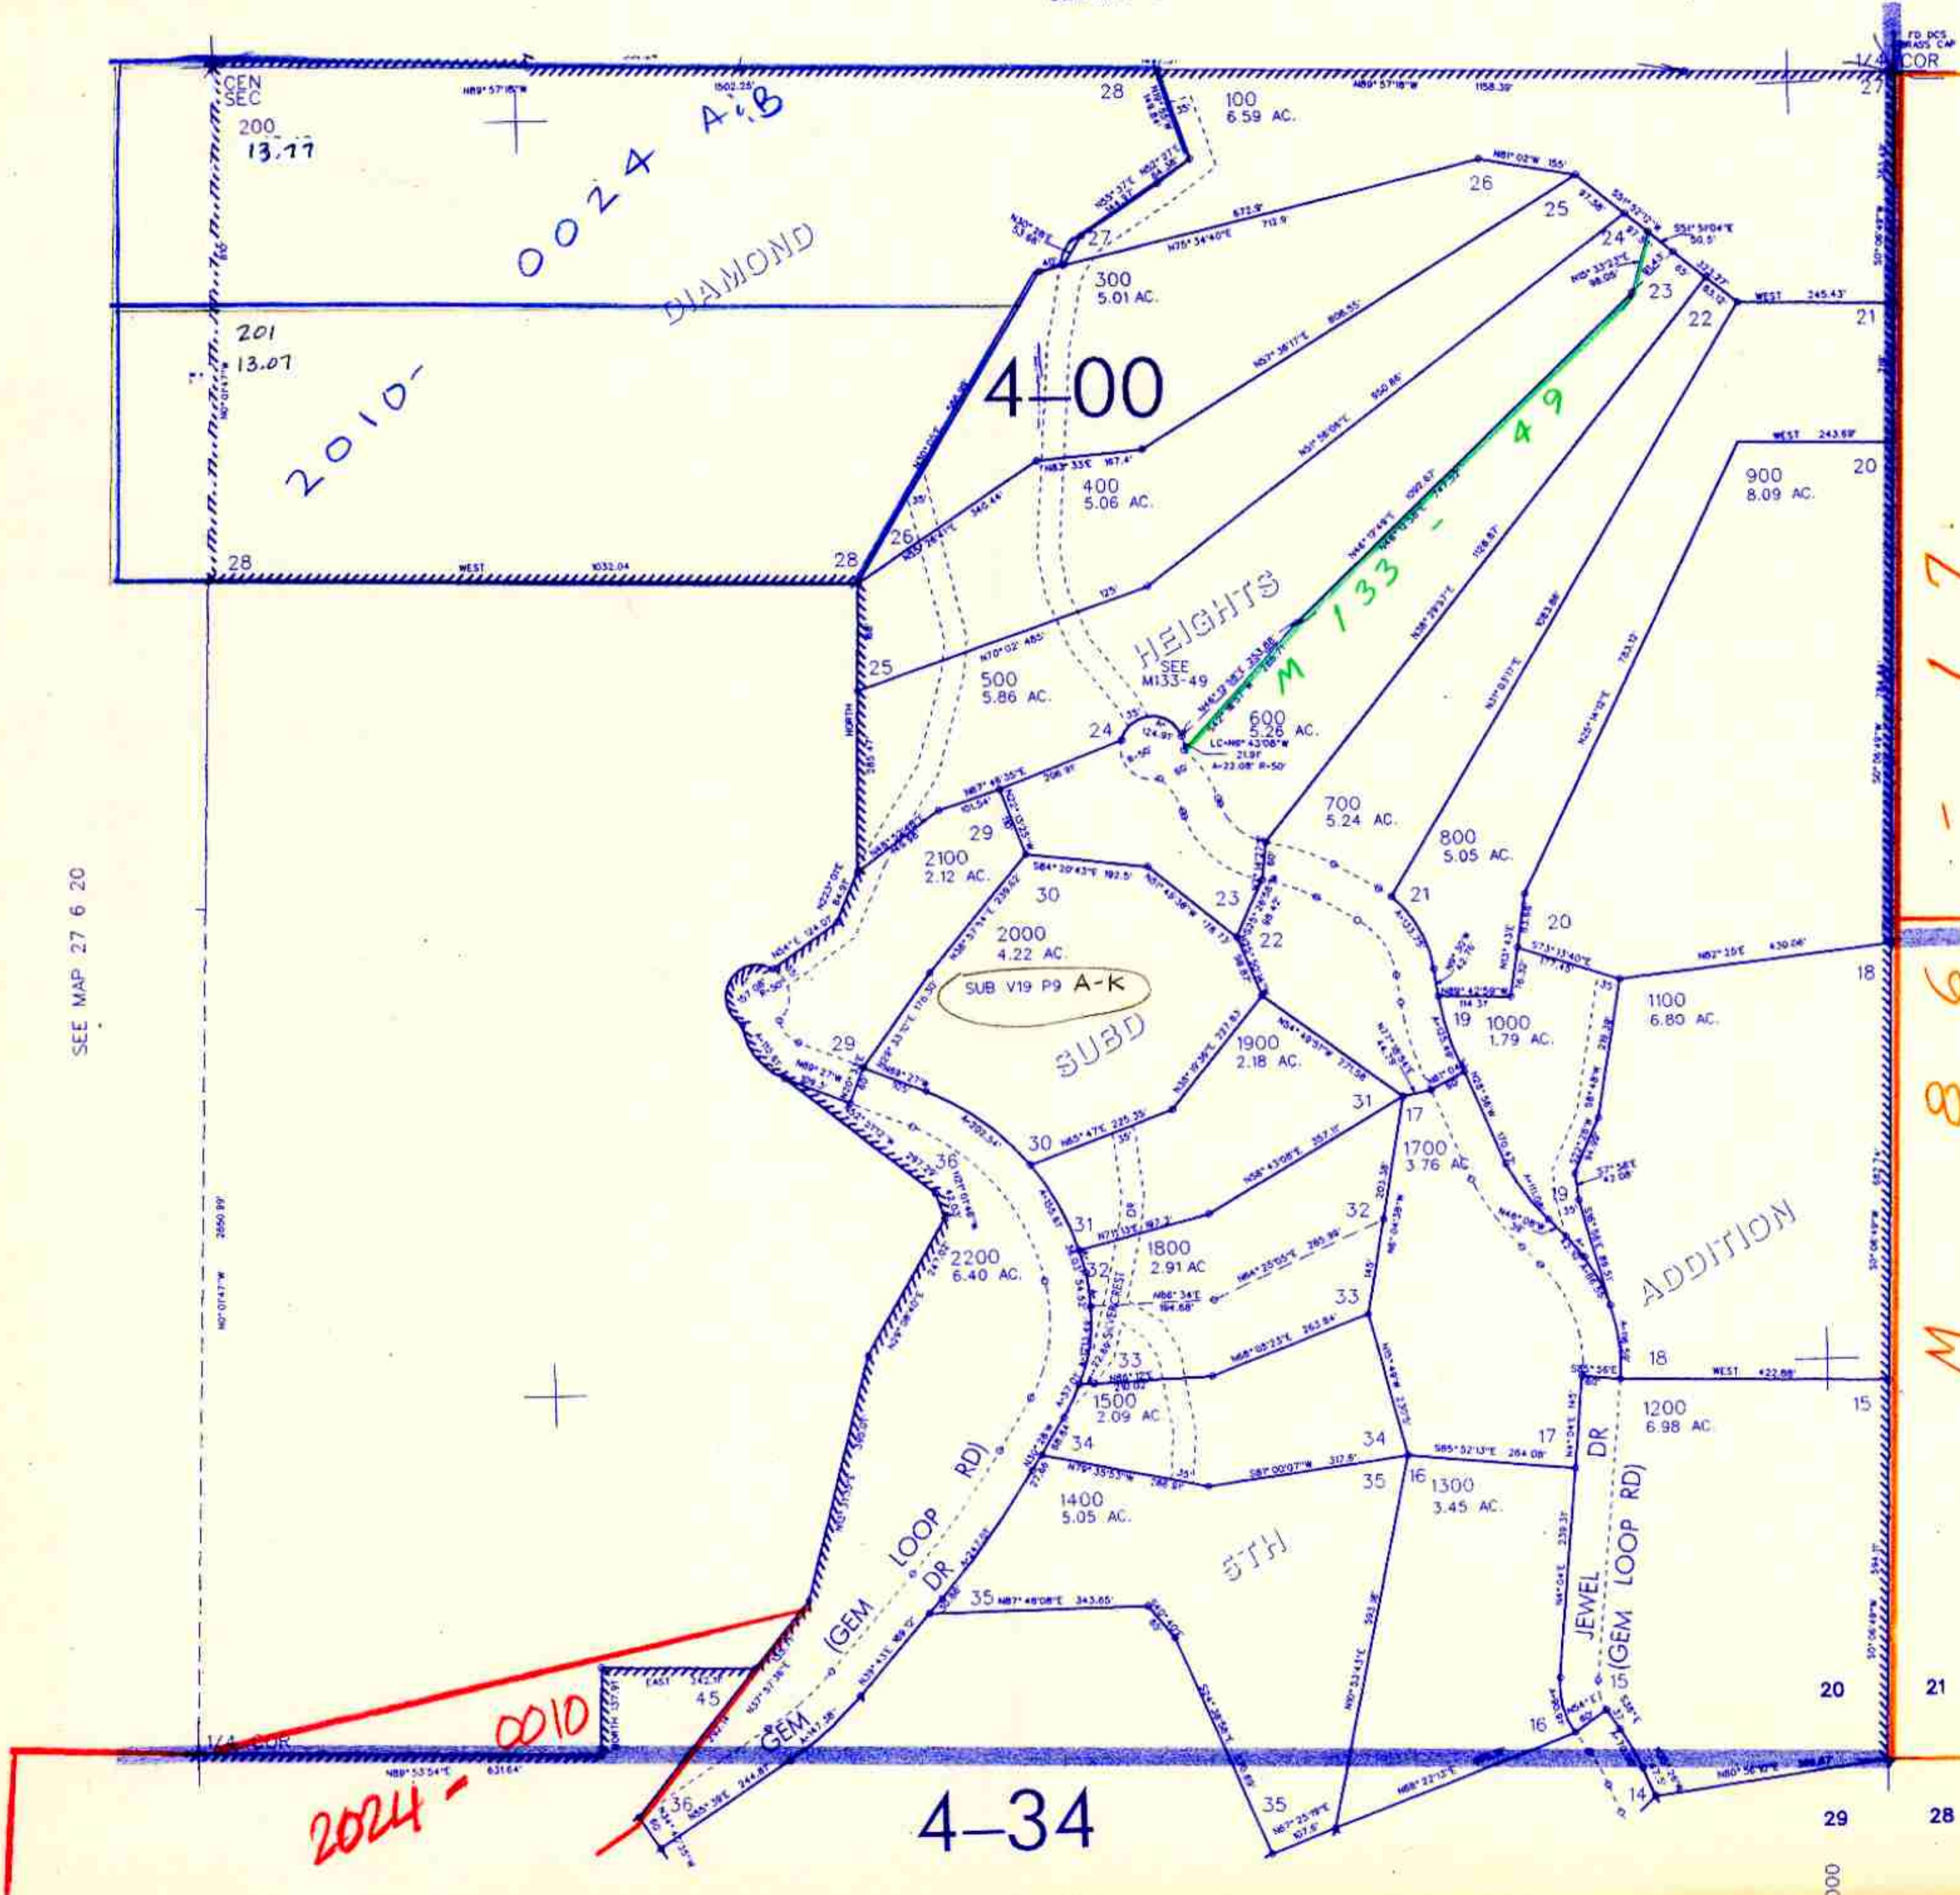

CANCELLED NO'S 501 601 1600

SEE MAP 27 6 21

573,000

SEE MAP 27 6 29A

27 6 20D
11/12/02 JP