NW1/4 NE1/4 SEC. 22 T.27S. R.6W. W.M.
DOUGLAS COUNTY

REVISED ON
8-26-92

27 6 22AB
ROSEBURG

1"=100'
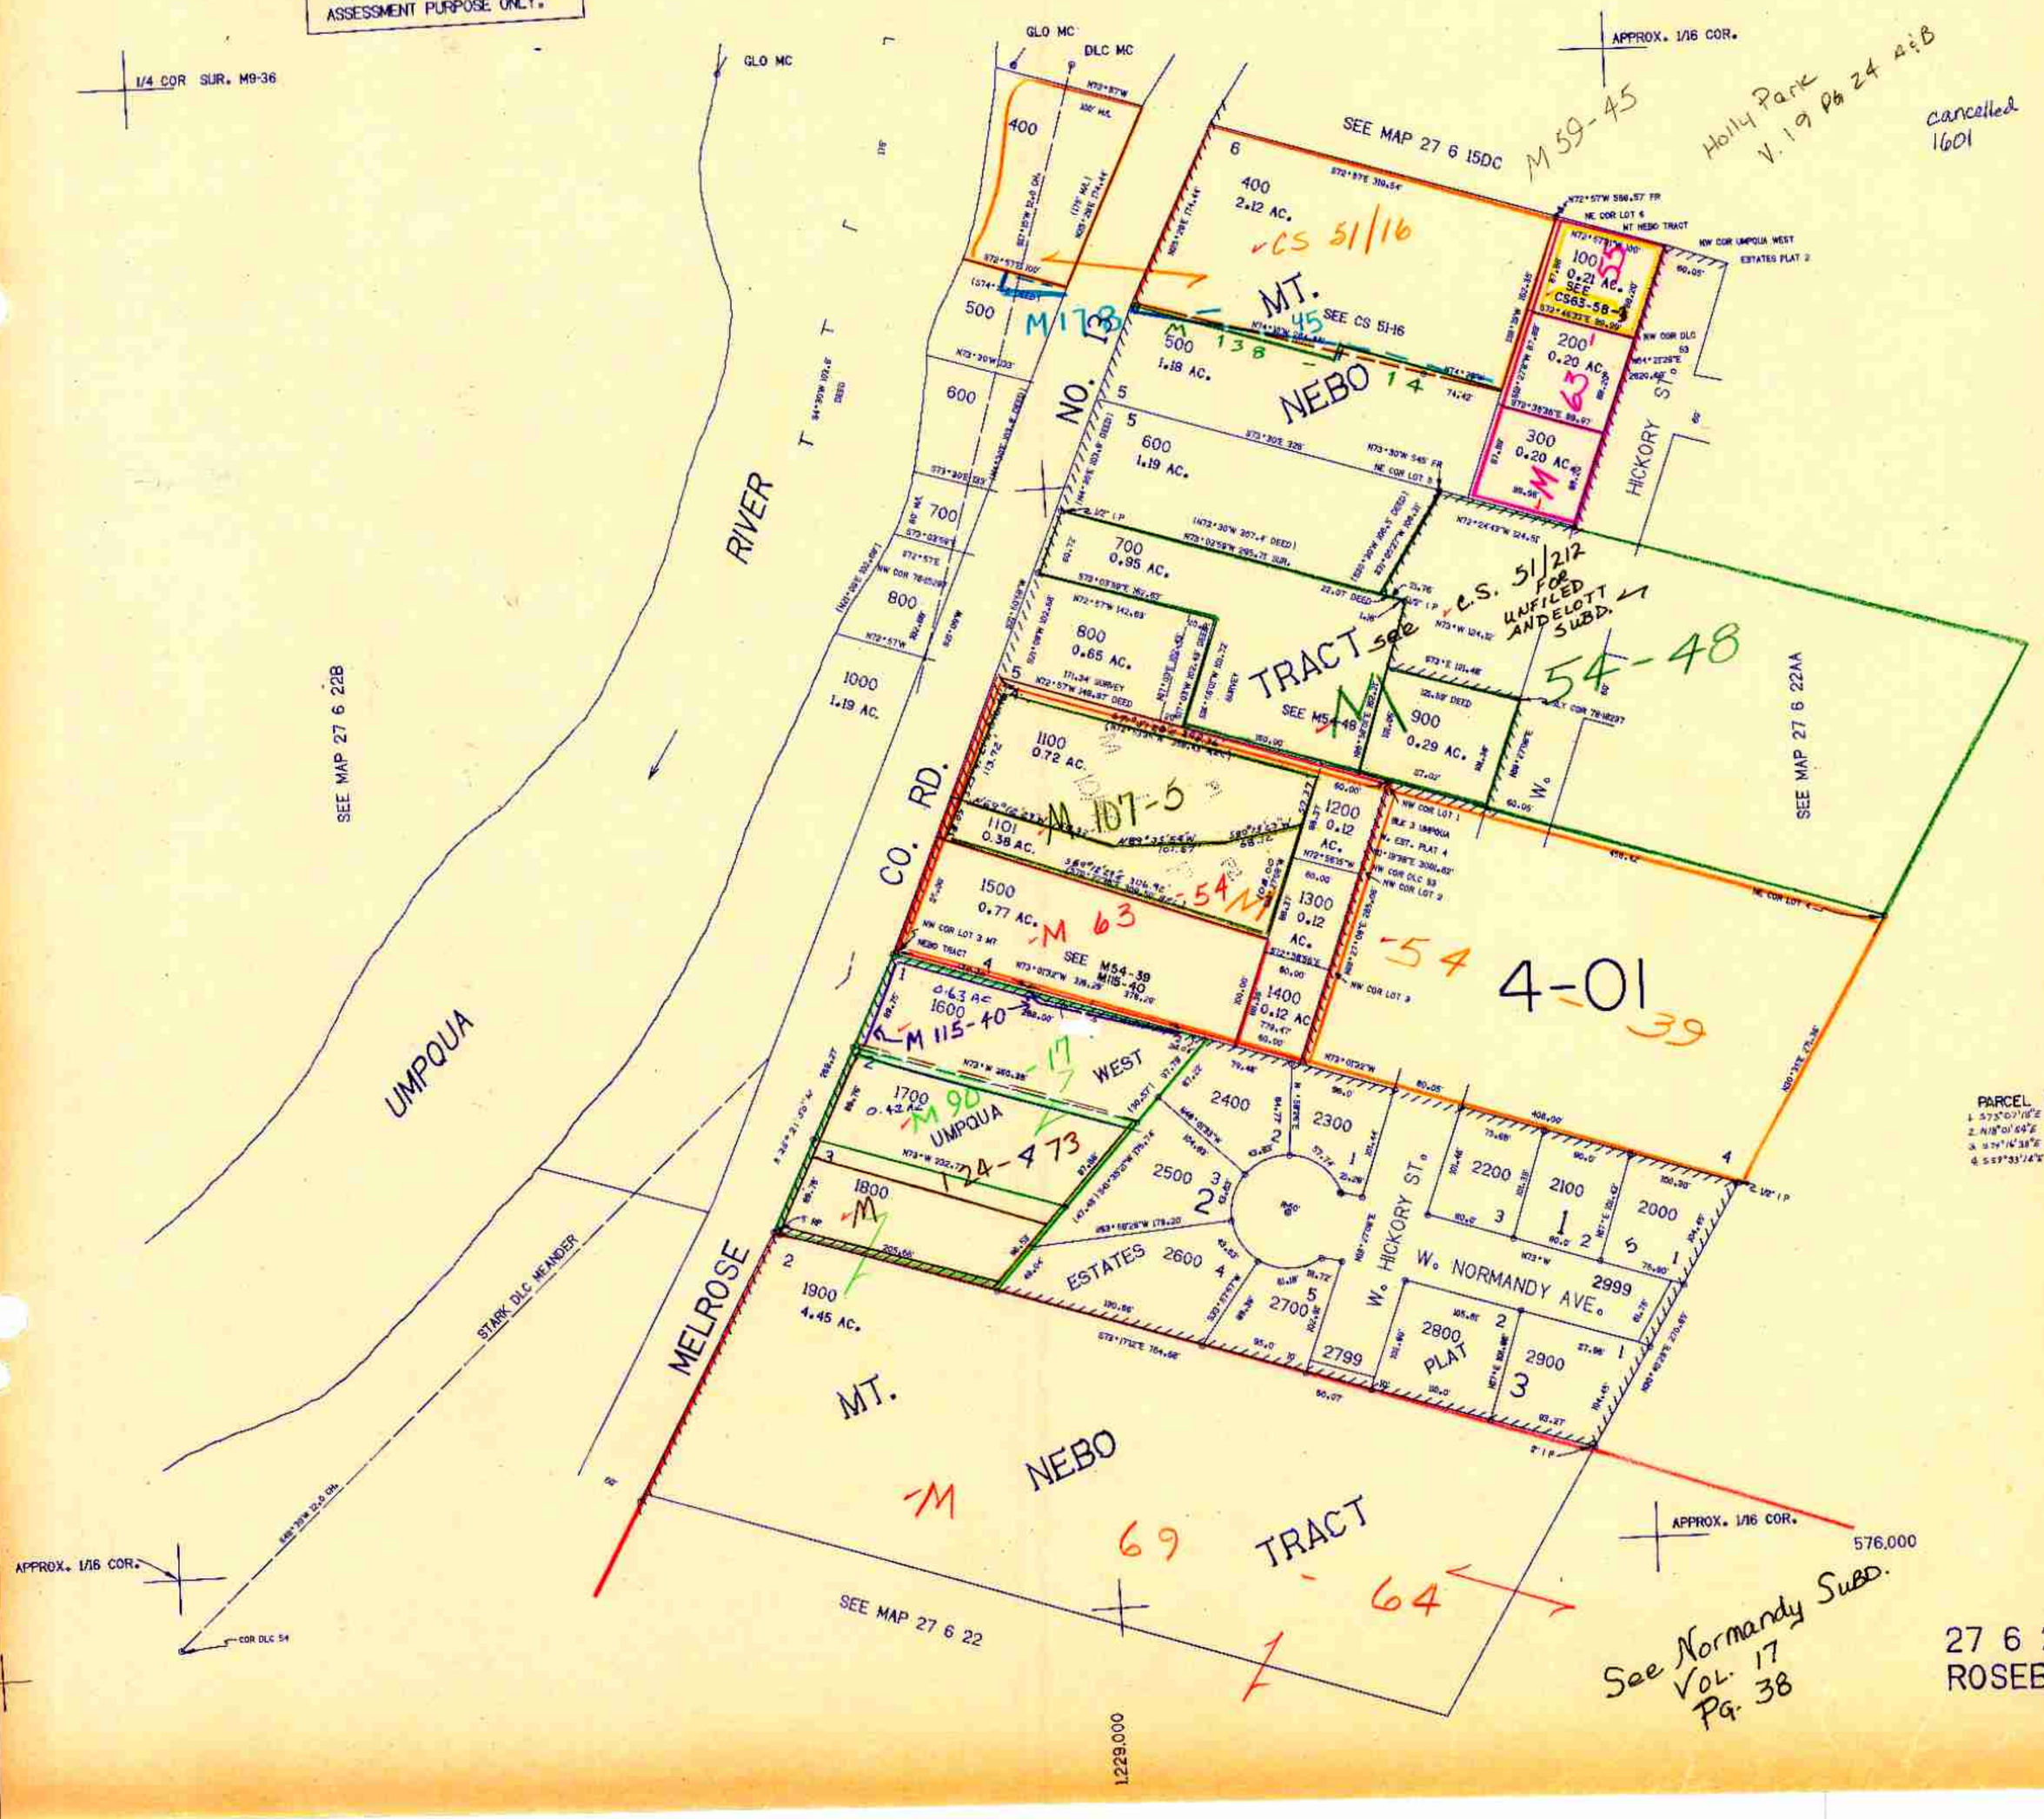
THIS MAP WAS PREPARED FOR ASSESSMENT PURPOSE ONLY.