


THIS MAP WAS PREPARED FOR ASSESSMENT PURPOSE ONLY.

SEC.26 T.27S. R.6W. W.M. DOUGLAS COUNTY

1" = 400'

REVISED ON 5-13-20

27 6 26 & INDEX

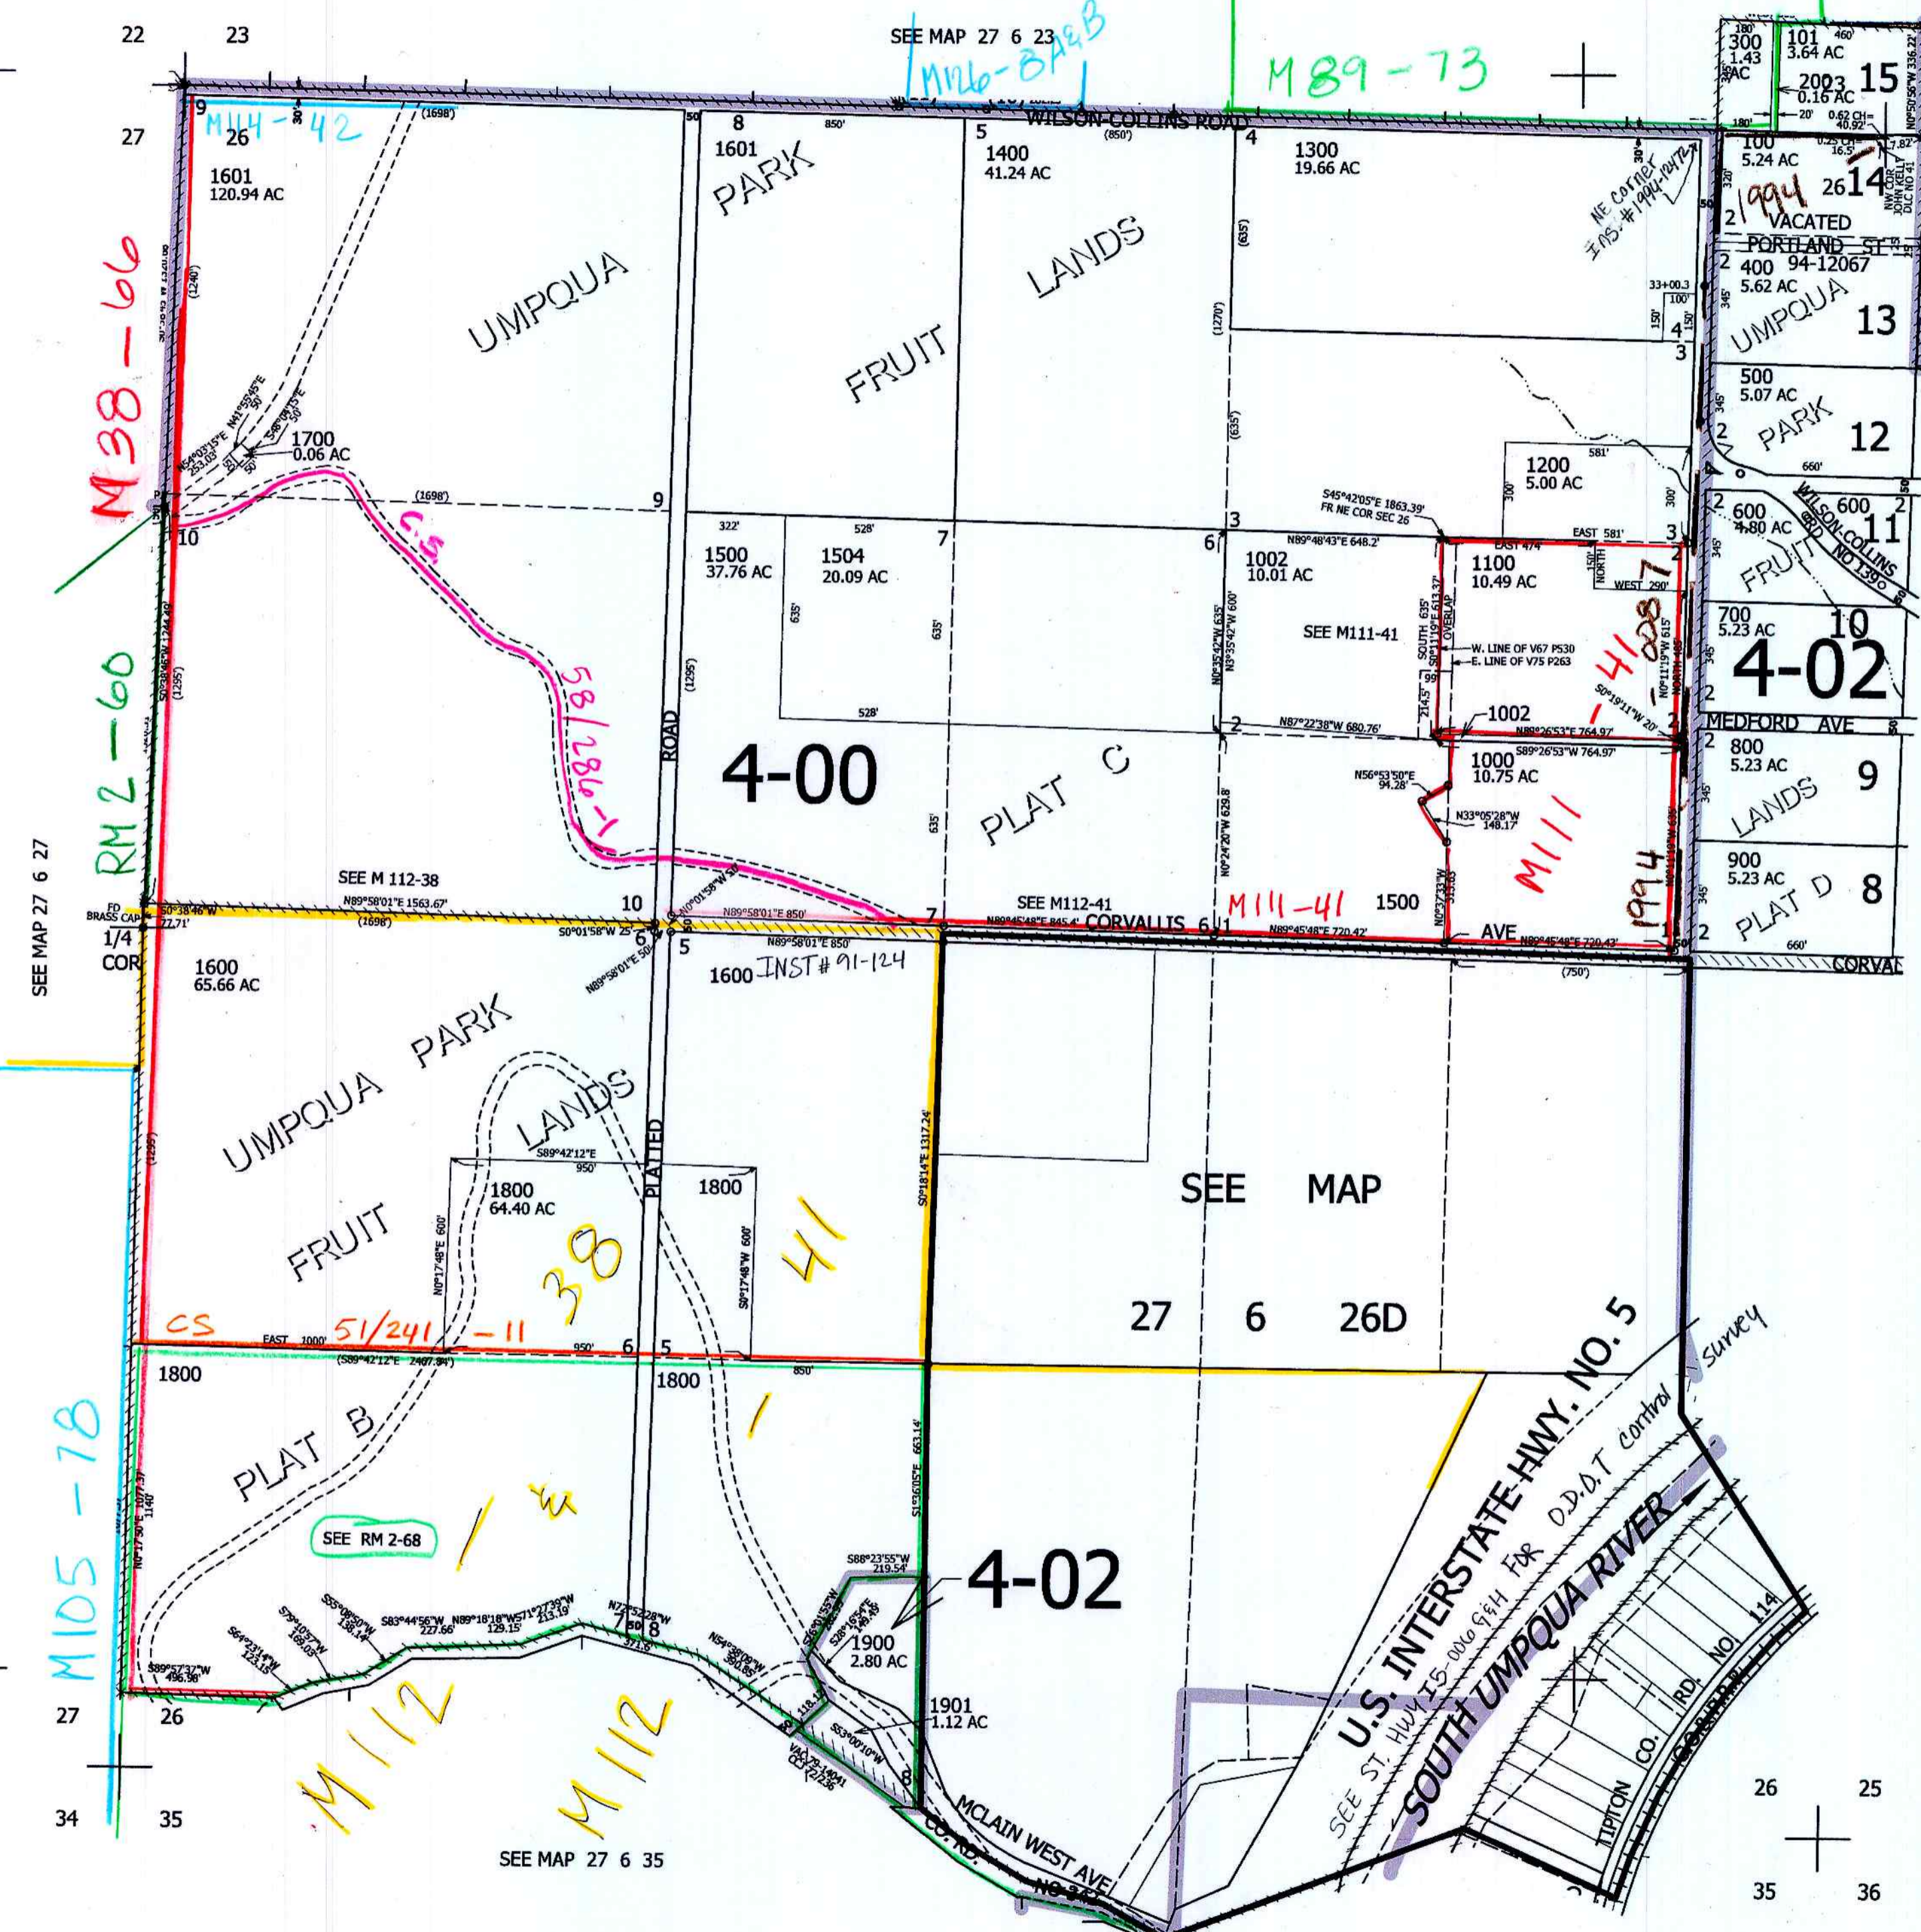

CANCELLED NO'S 1502 1501 1503 1001 1602 1603

SEE MAP 27 6 25BB

SEE MAP 27 6 25BC

SEE MAP 27 6 25C

567,000

26 25
35 36

SEE MAP 27 6 35A

4,156,000

27 6 26 & INDEX

519-2020
D1