


1" = 200'

SEE MAP 27 6 26

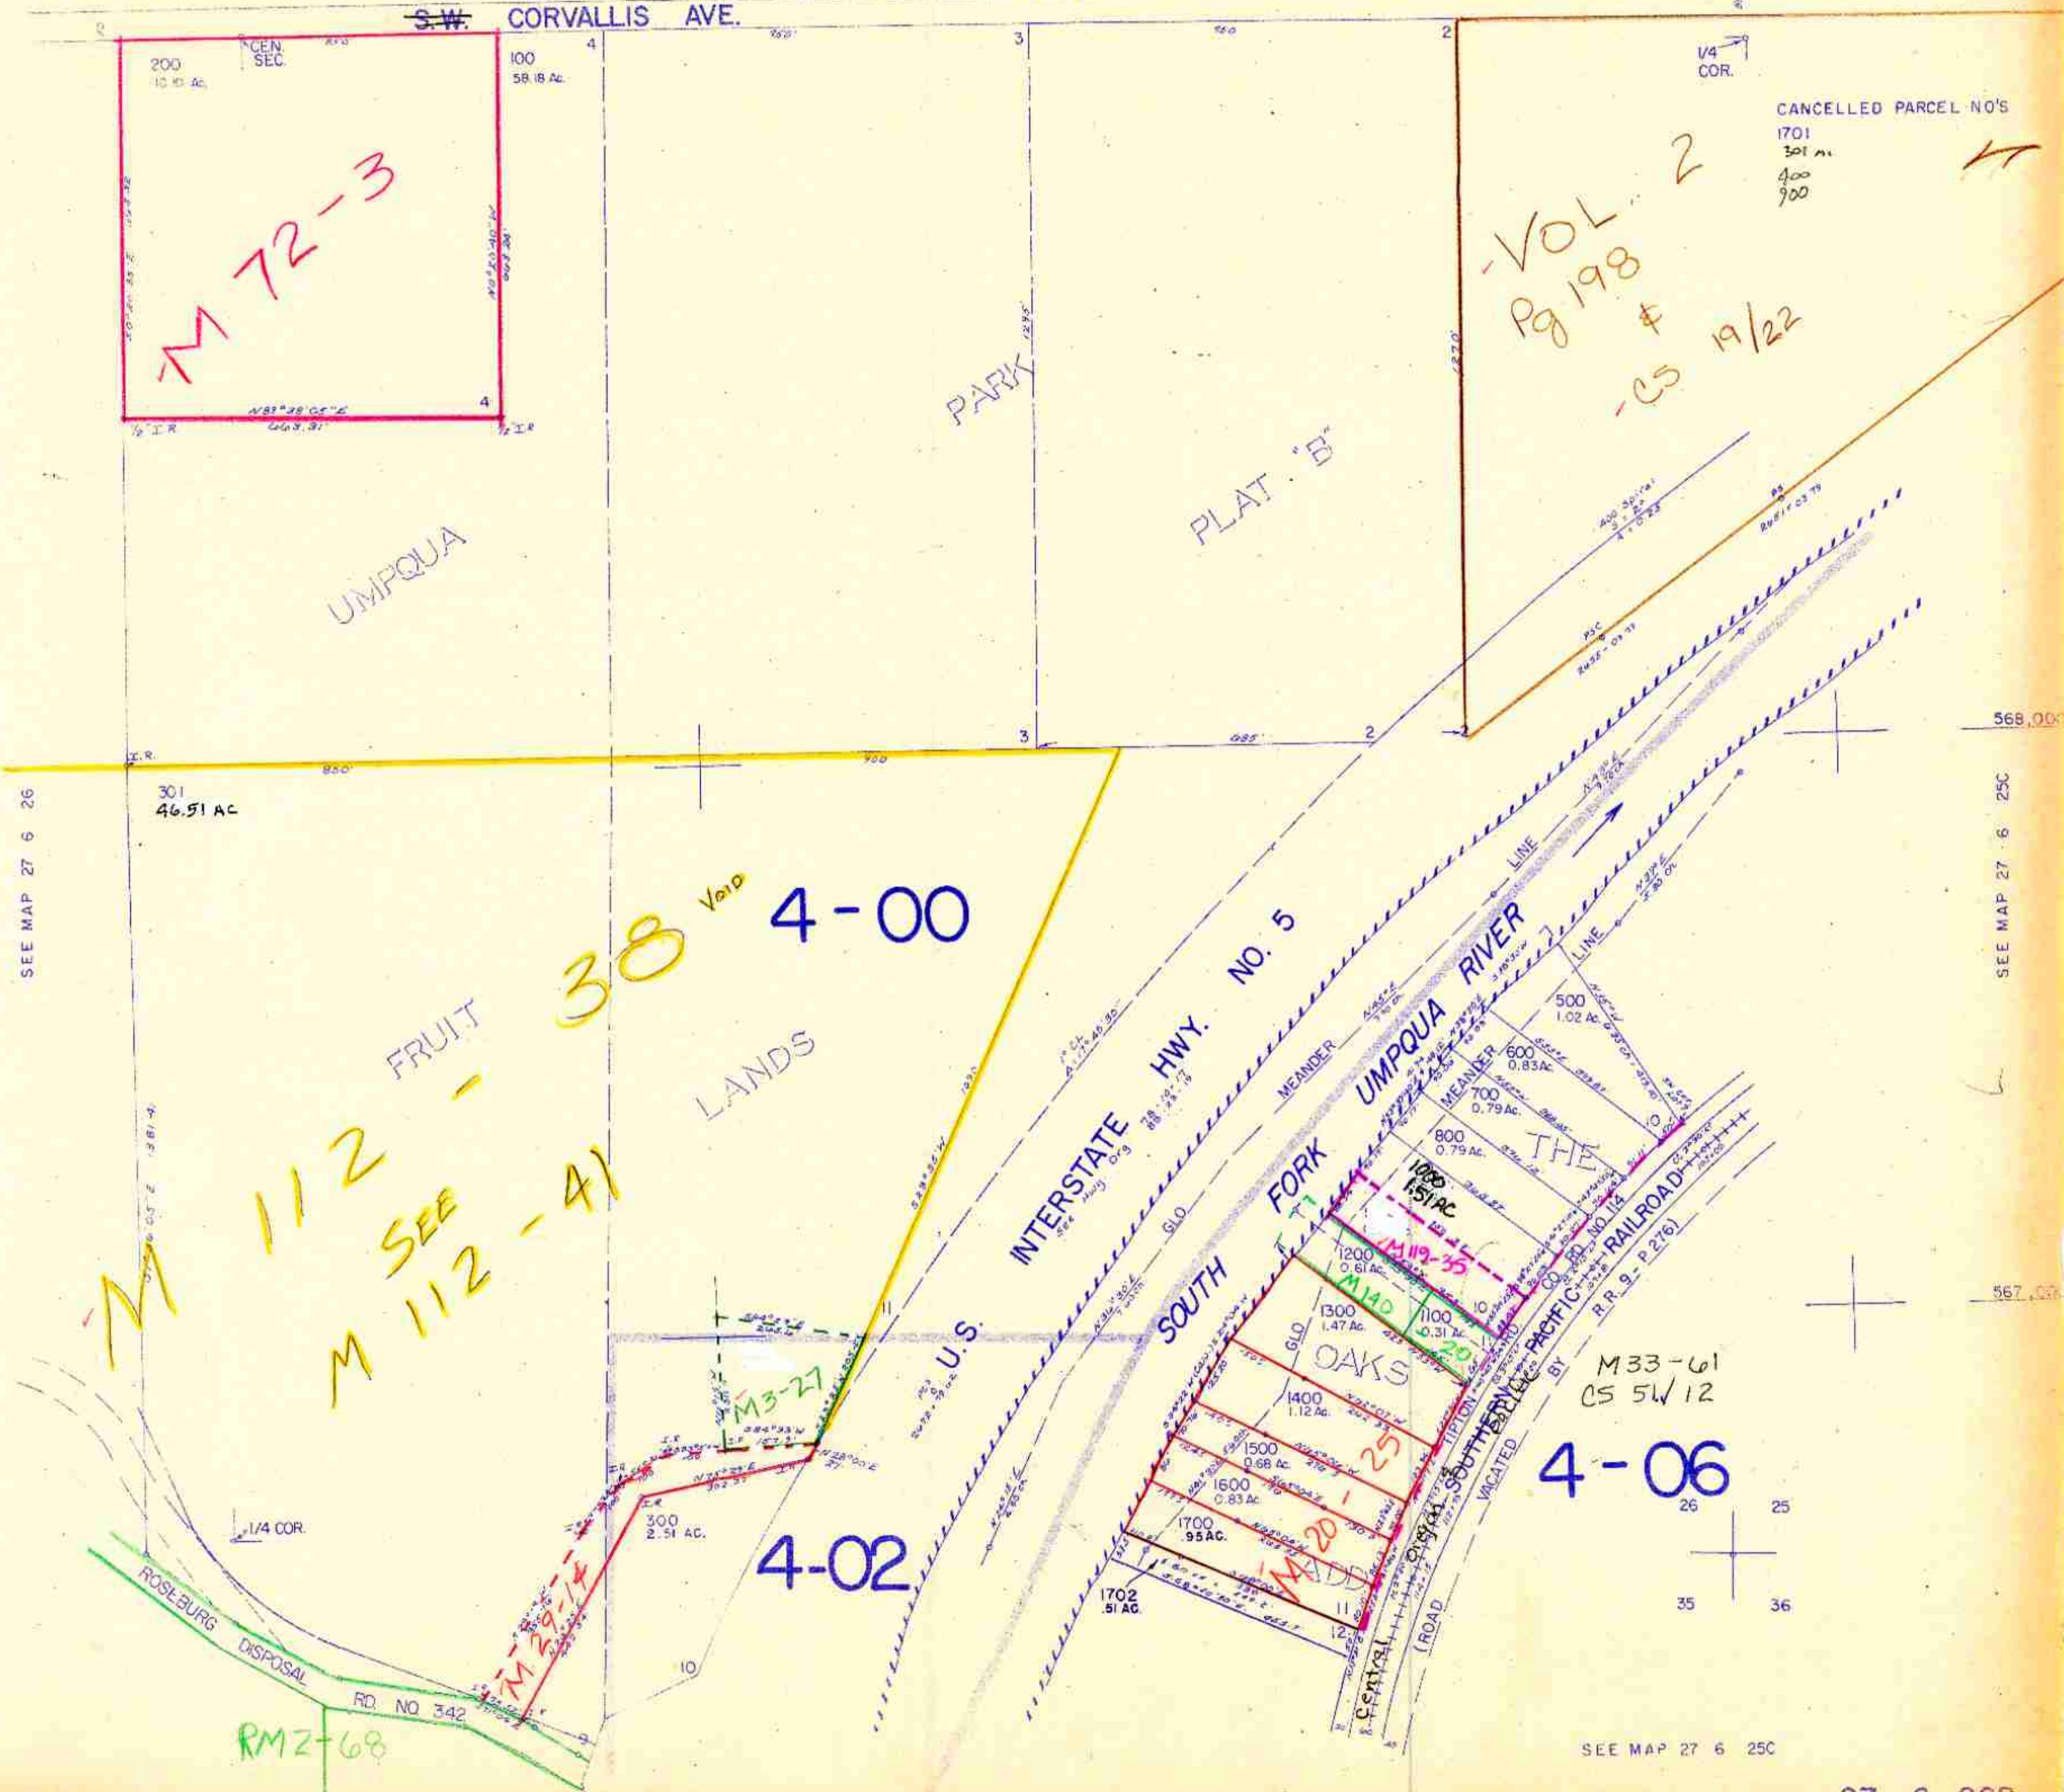

M 72-3

VOL. 2
Pg 198
CS 19/22

CANCELLED PARCEL NO'S
1701
301
400
900

38^{VOID} 4-00

M 112
SEE
M 112-4

4-02

4-06

M 33-61
CS 5/12

RMZ-68

SEE MAP 27 6 25C