THIS MAP WAS PREPARED FOR ASSESSMENT PURPOSE ONLY

Upper Left:
123°25'56"W 43°12'6"N
4139600E 573101N ft

SEC.28 T.27S. R.06W. W.M.
DOUGLAS COUNTY
1" =400'

Date Exported 2024-04-22

& INDEX

CANCELLED NOS:
200 404 405
700A1

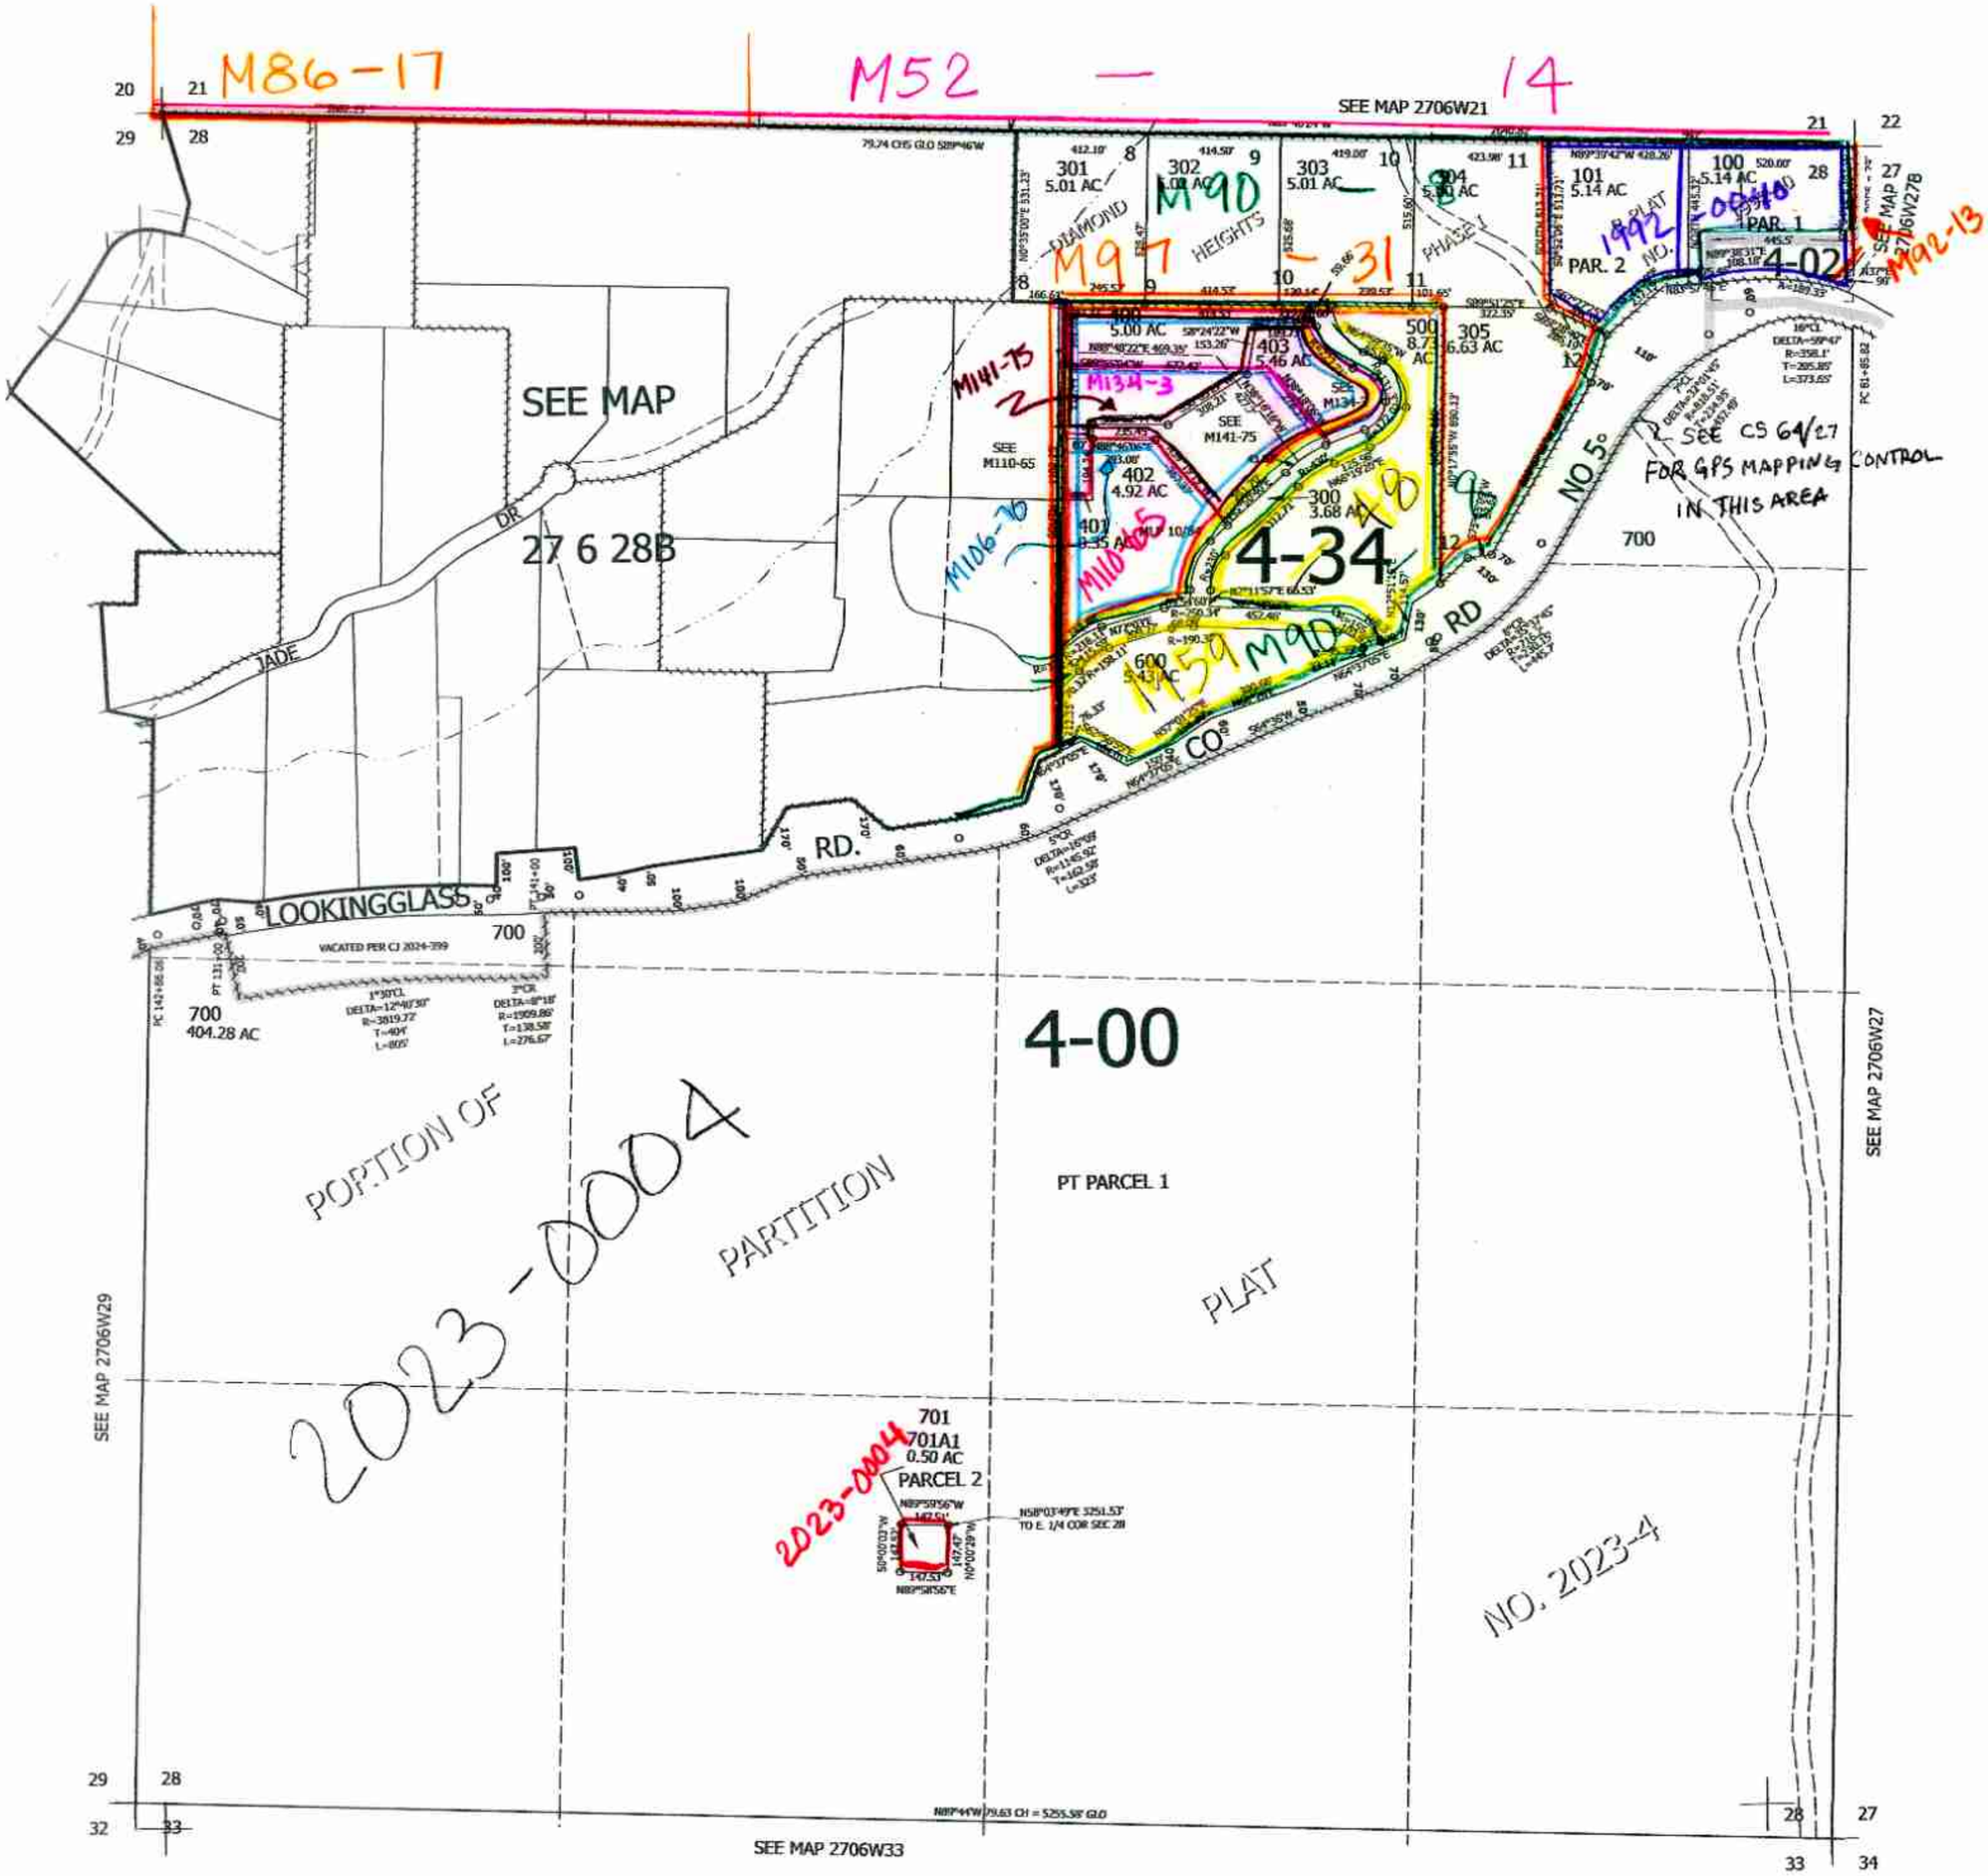

2/2023

270628
& INDEX

Lower Right:
123°24'7"W 43°11'N
4147449E 566146N ft