


1" = 400'

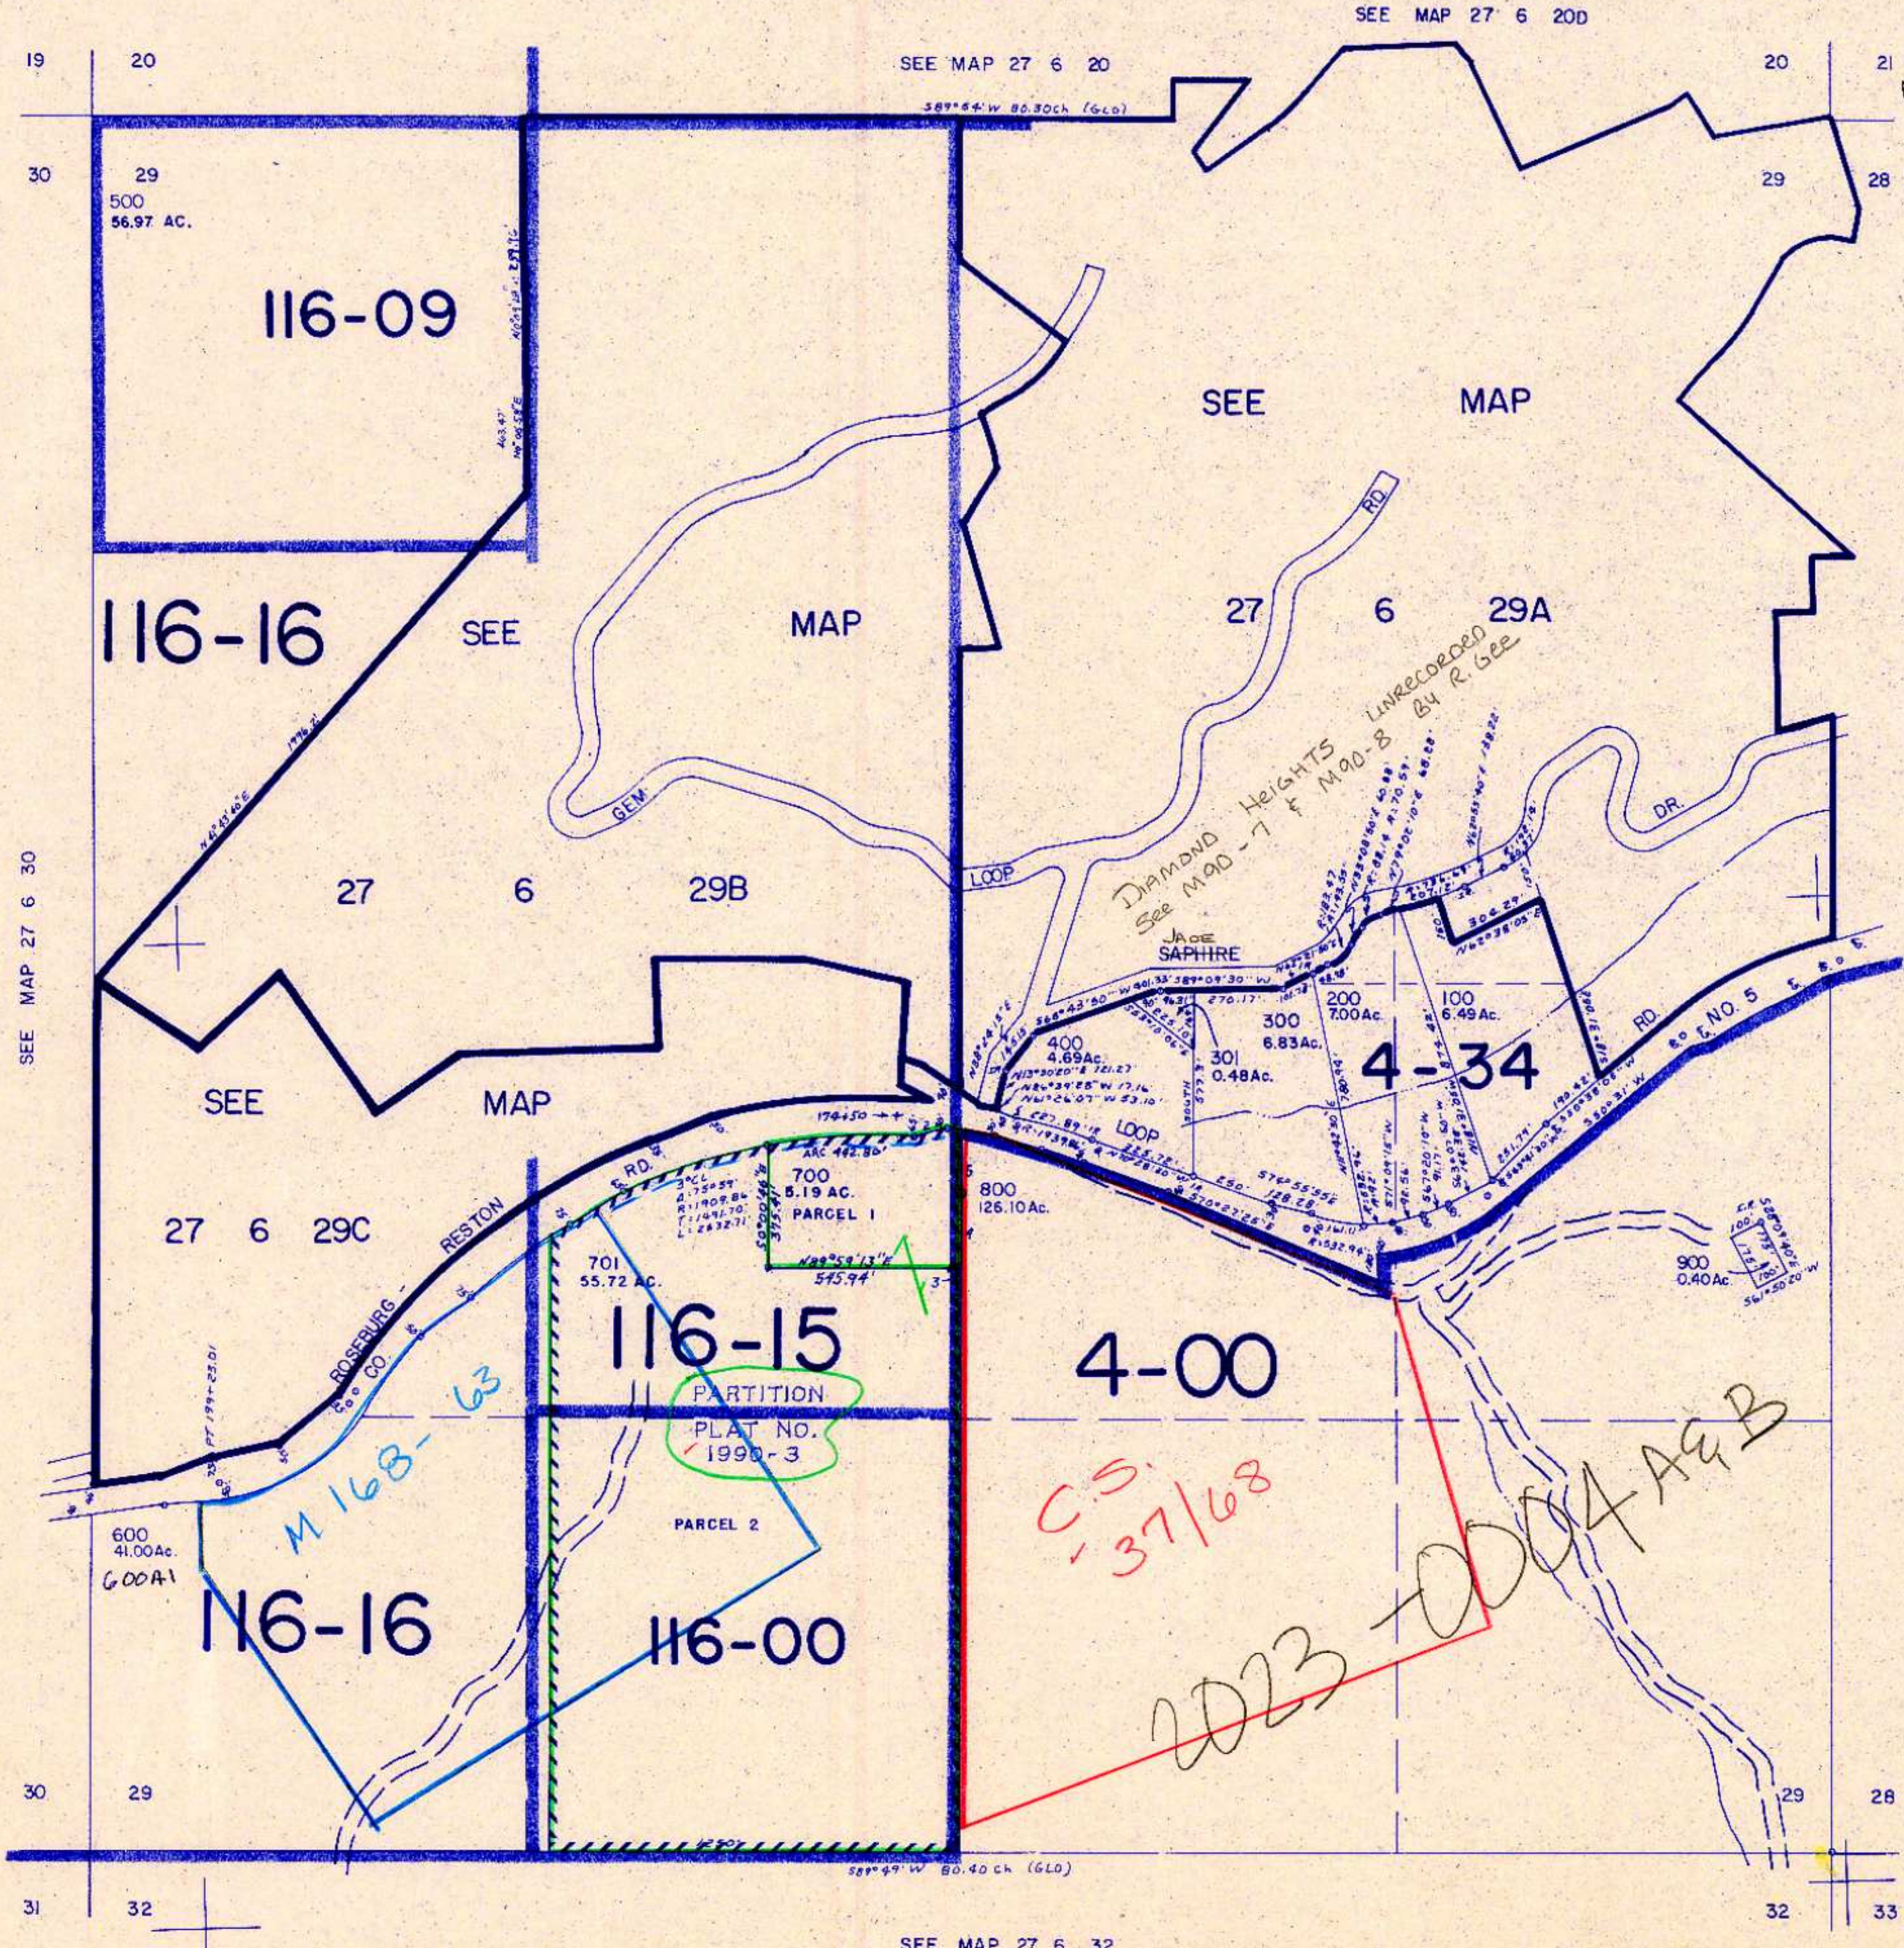

M 97-31

PARCEL 700
 1. N82°40'58"W 27.96'
 2. S75°37'06"W 104.10'
 3. N89°54'13"E 10.00'
 4. N3°14'36"E 231.83'
 5. N10°00'43"E 189.90'

CANCELLED NO'S
 702 501 502

SEE MAP 27 6 28B

SEE MAP 27 6 2B

567,000

1,220,000

JP
10/18/96