THIS MAP WAS PREPARED FOR ASSESSMENT PURPOSE ONLY

SEC. 33 T.27S. R.6 W W.M.
DOUGLAS COUNTY

1" = 400'

REVISED ON

27 6 33

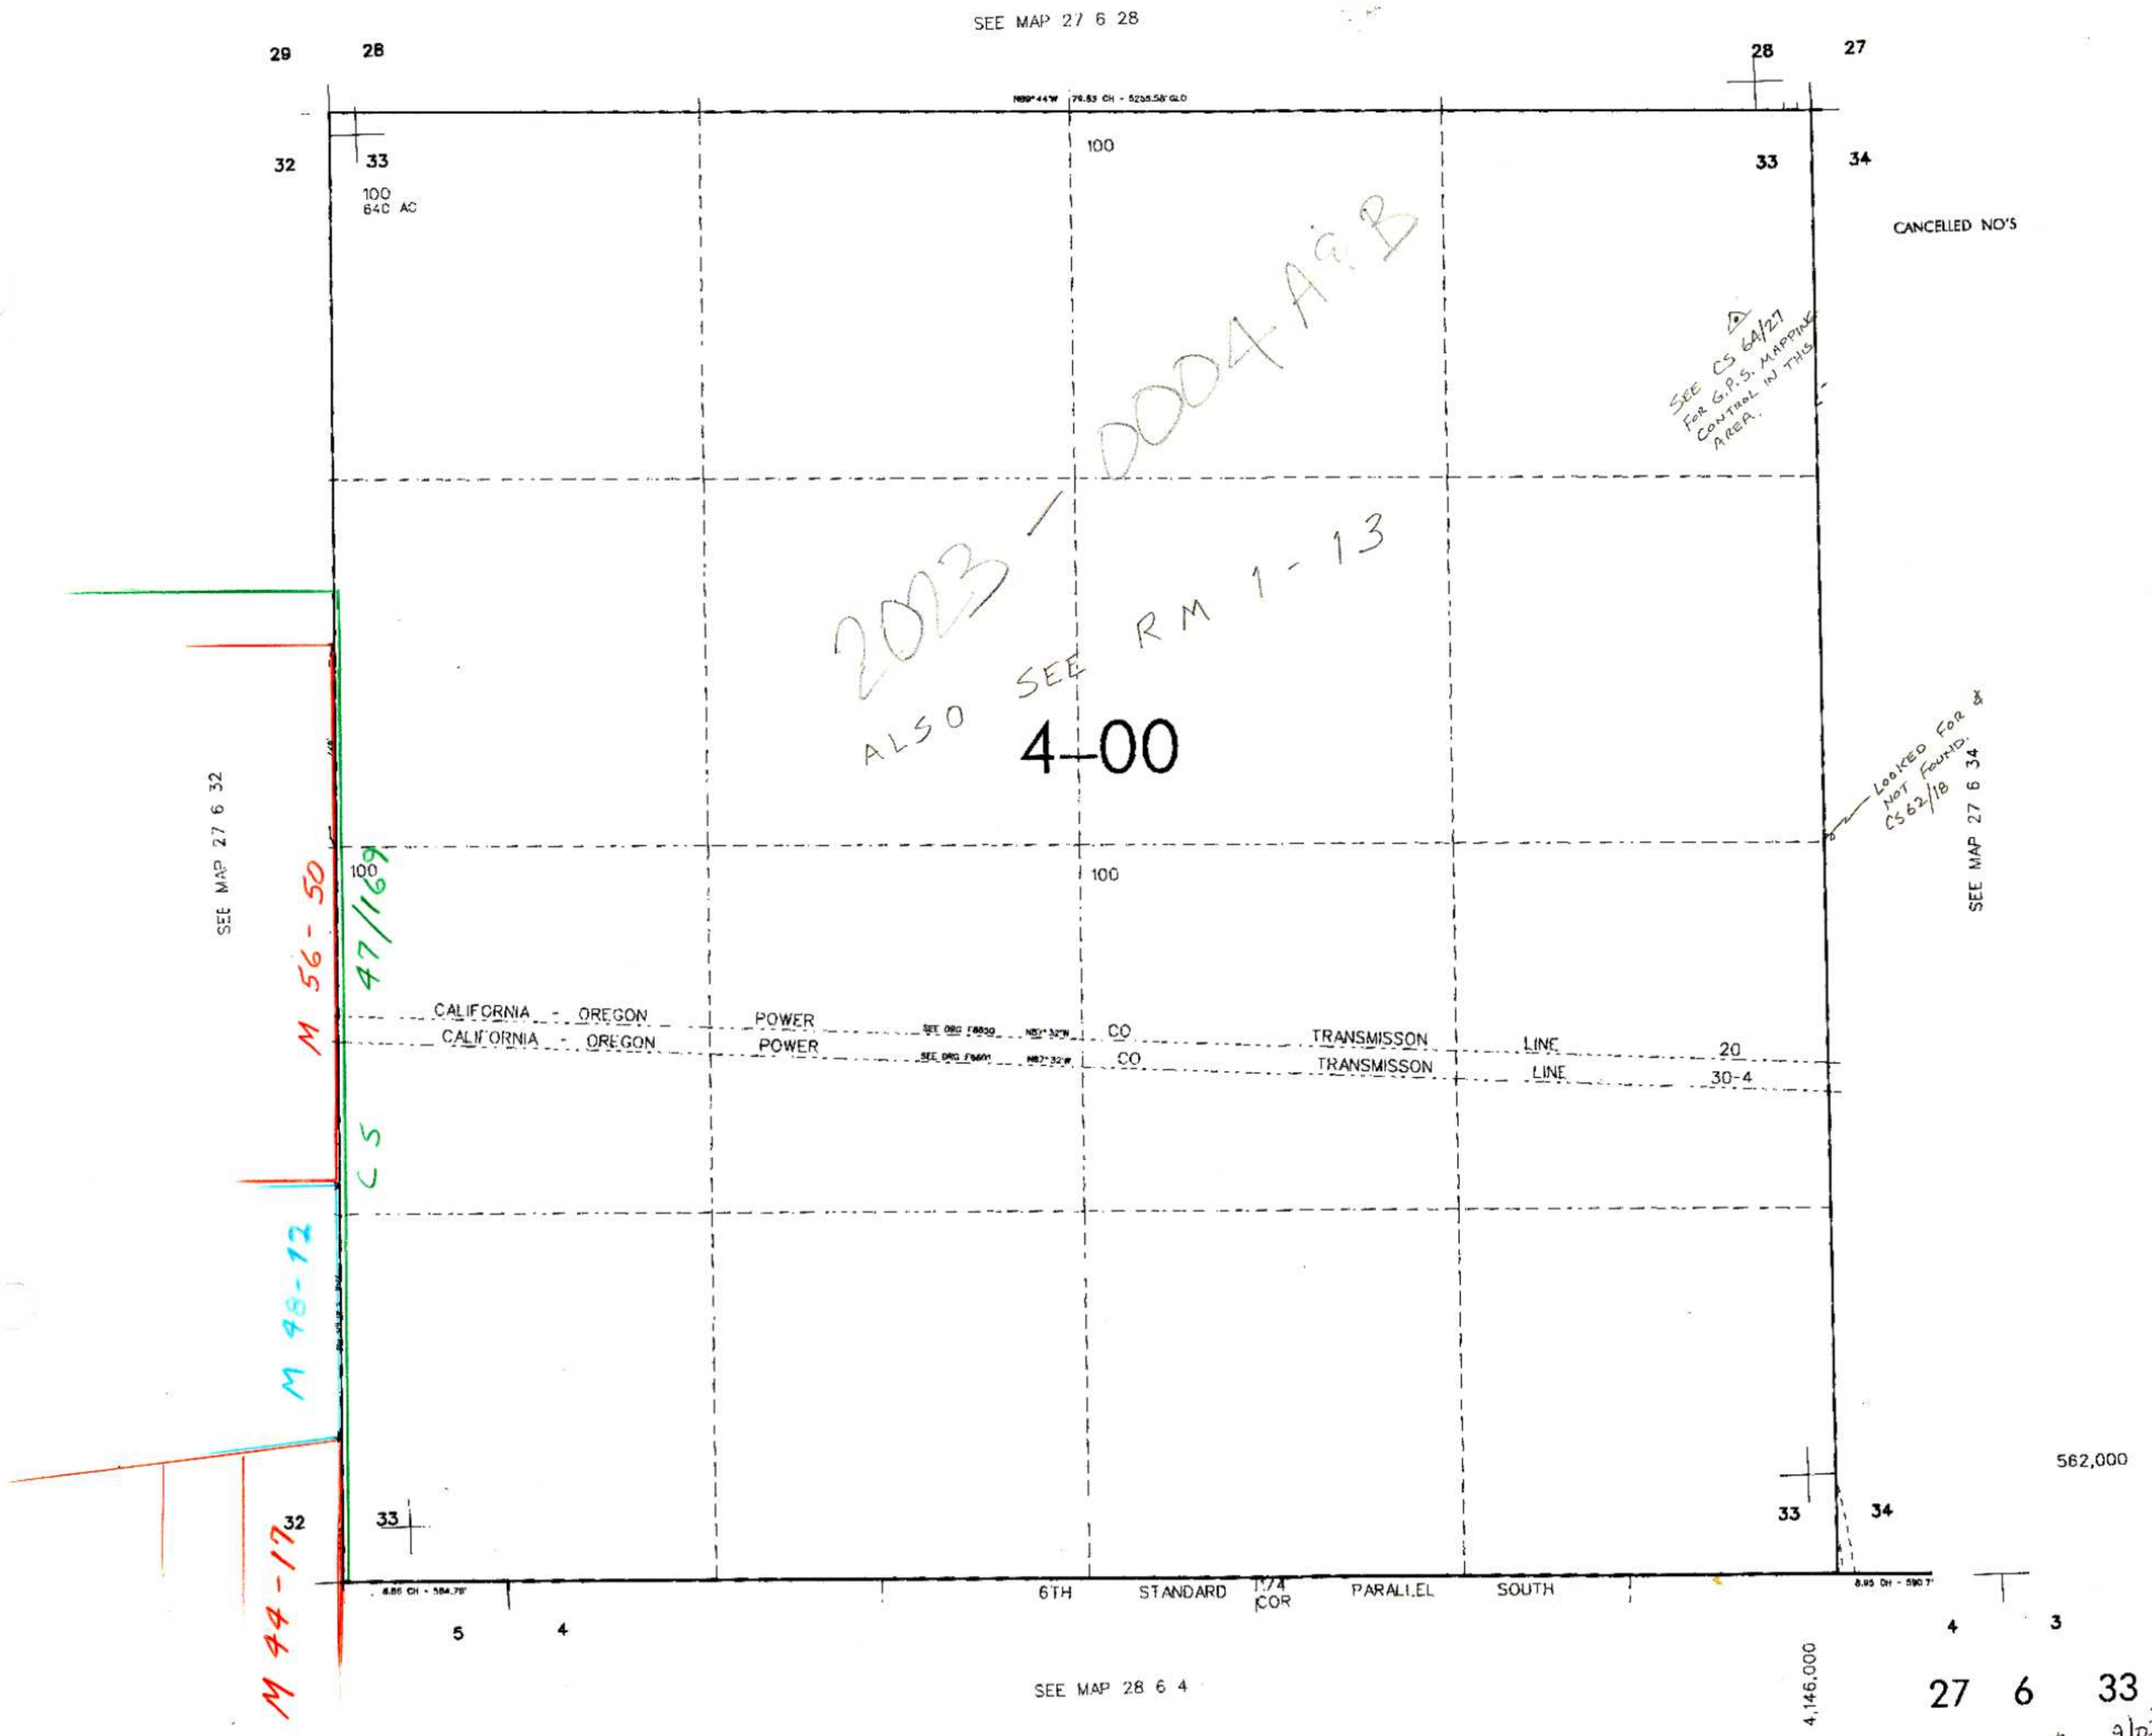

27 6 33

nw 9/03