NW1/4 SEC. 35 T.26S. R.7W. W.M.
DOUGLAS COUNTY

1" = 200'

THIS MAP WAS PREPARED FOR ASSESSMENT PURPOSE ONLY.

REVISED ON 3-5-91

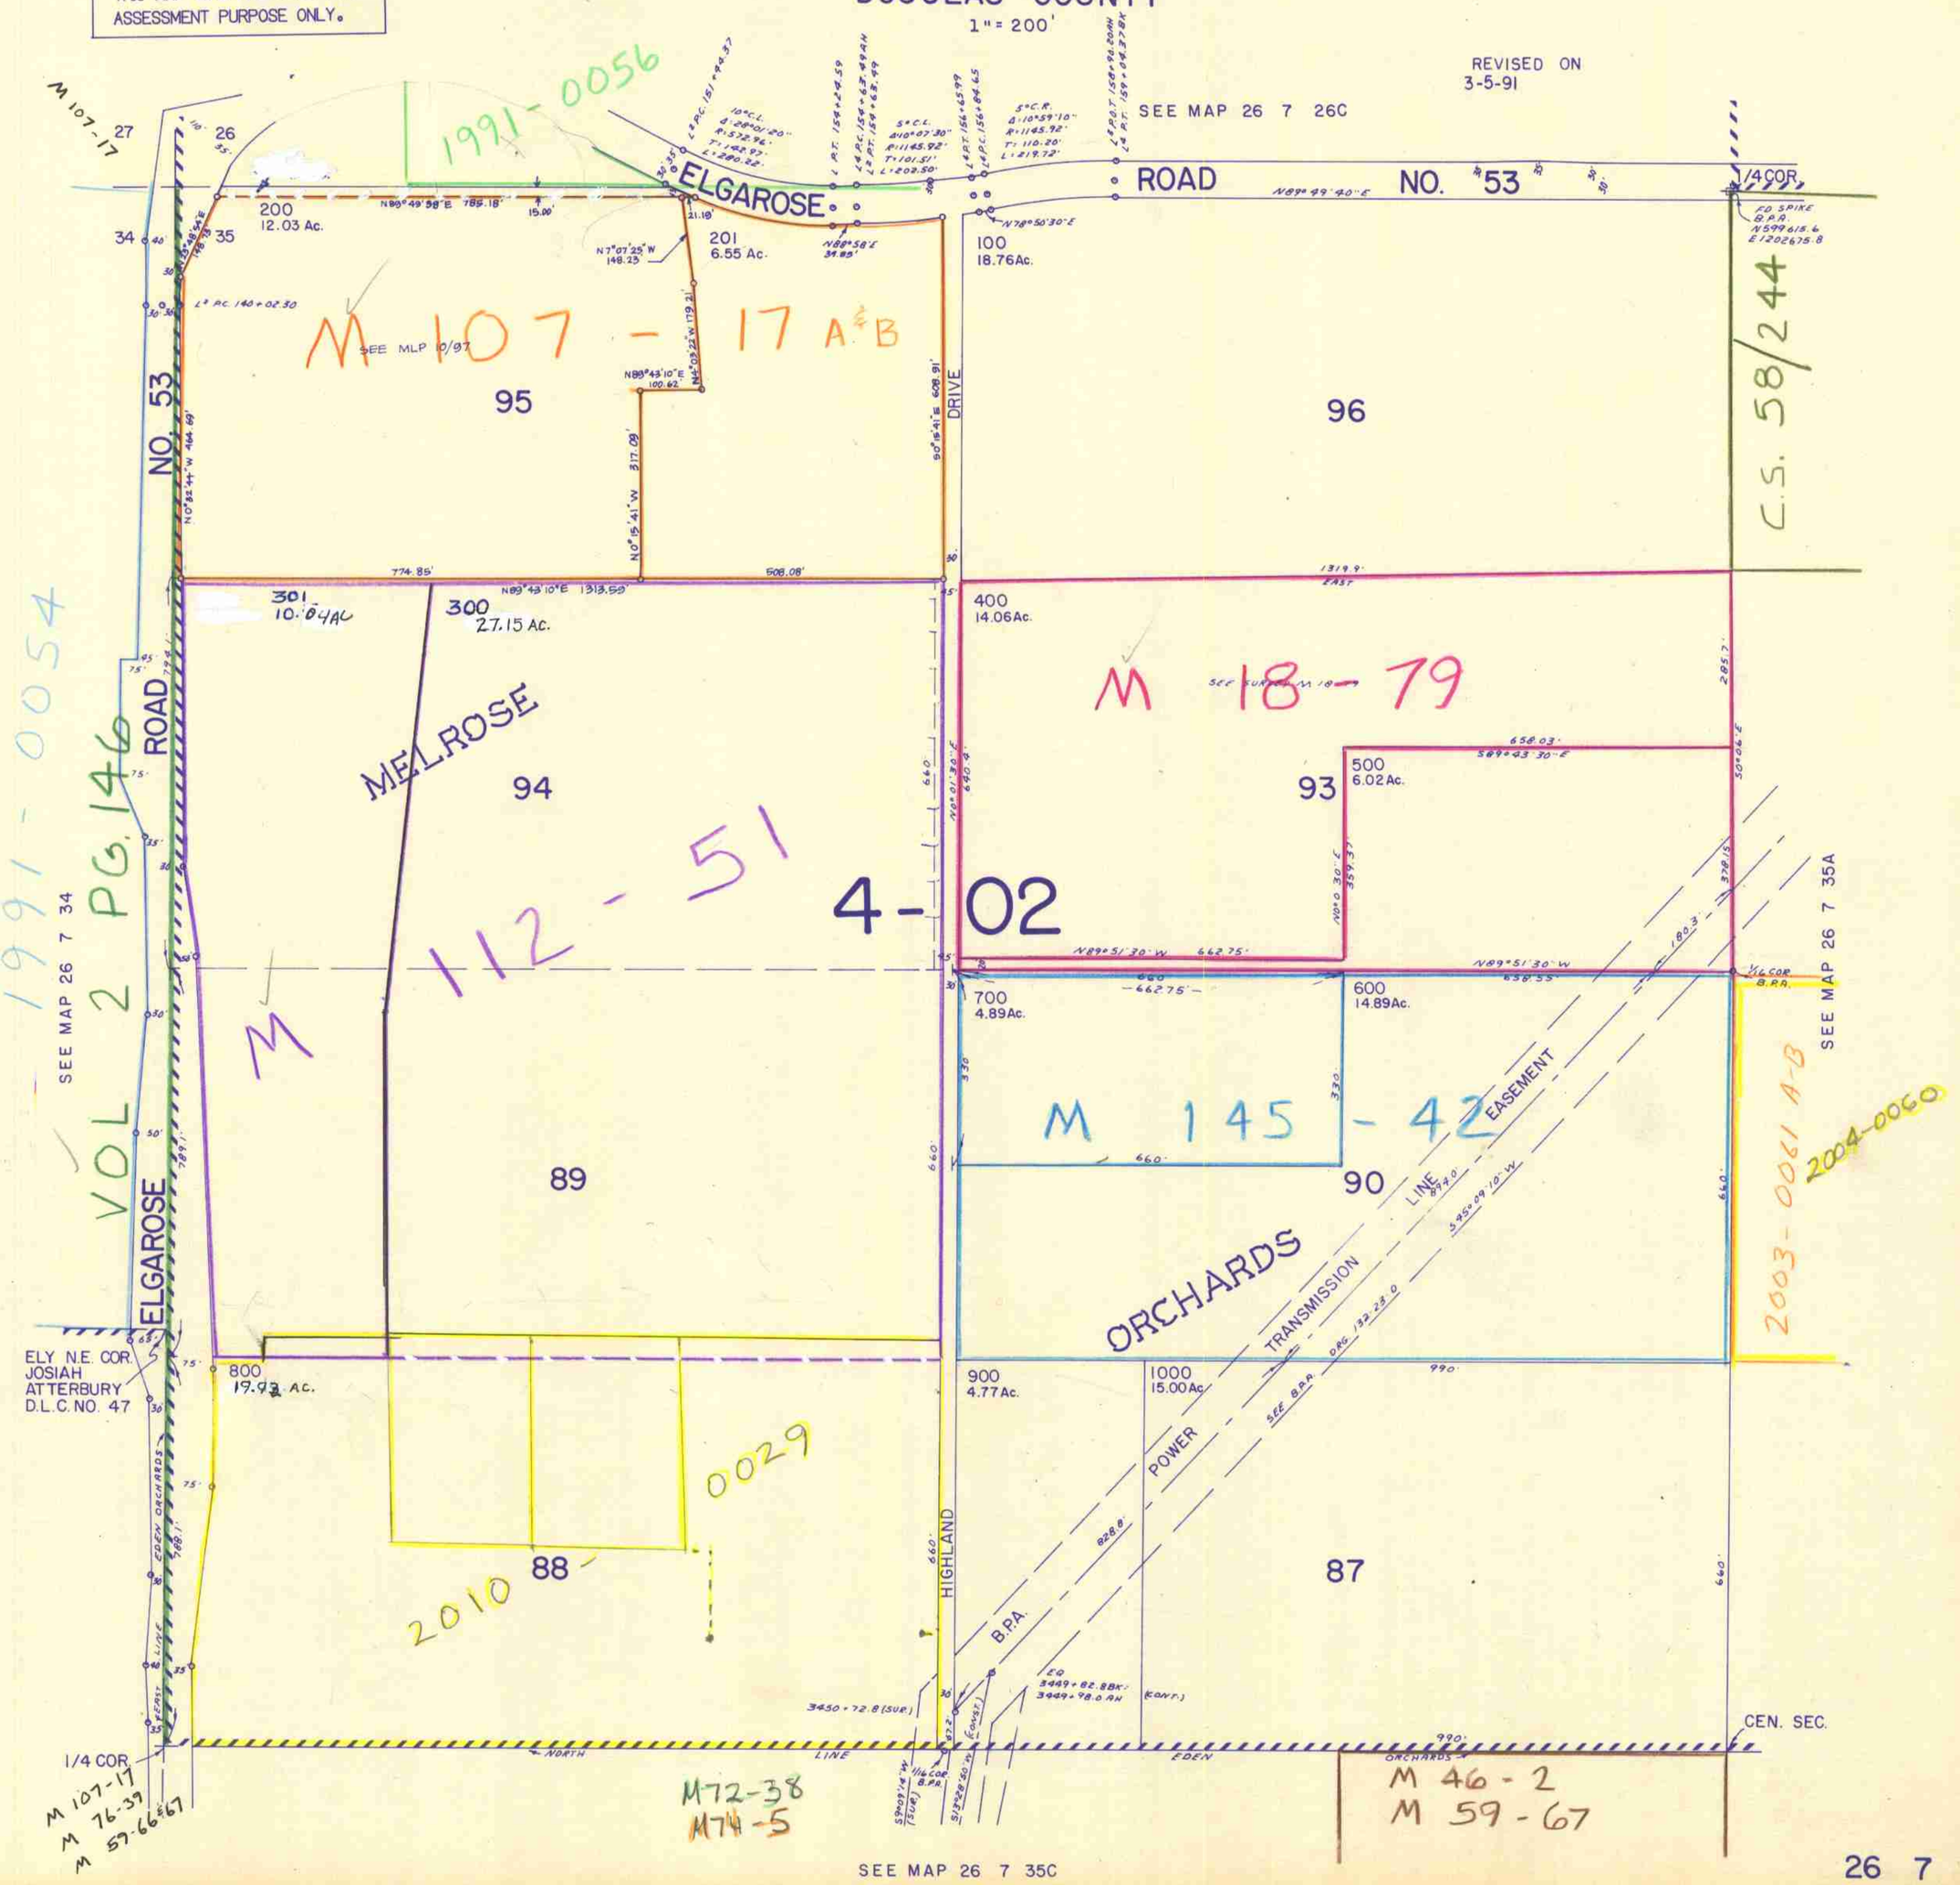

3/91 JP