THIS MAP WAS PREPARED FOR ASSESSMENT PURPOSE ONLY.

SEC.3 T.27S. R.7W. W.M.
DOUGLAS COUNTY

1" = 400'

REVISED ON 5-8-19

27 7 3

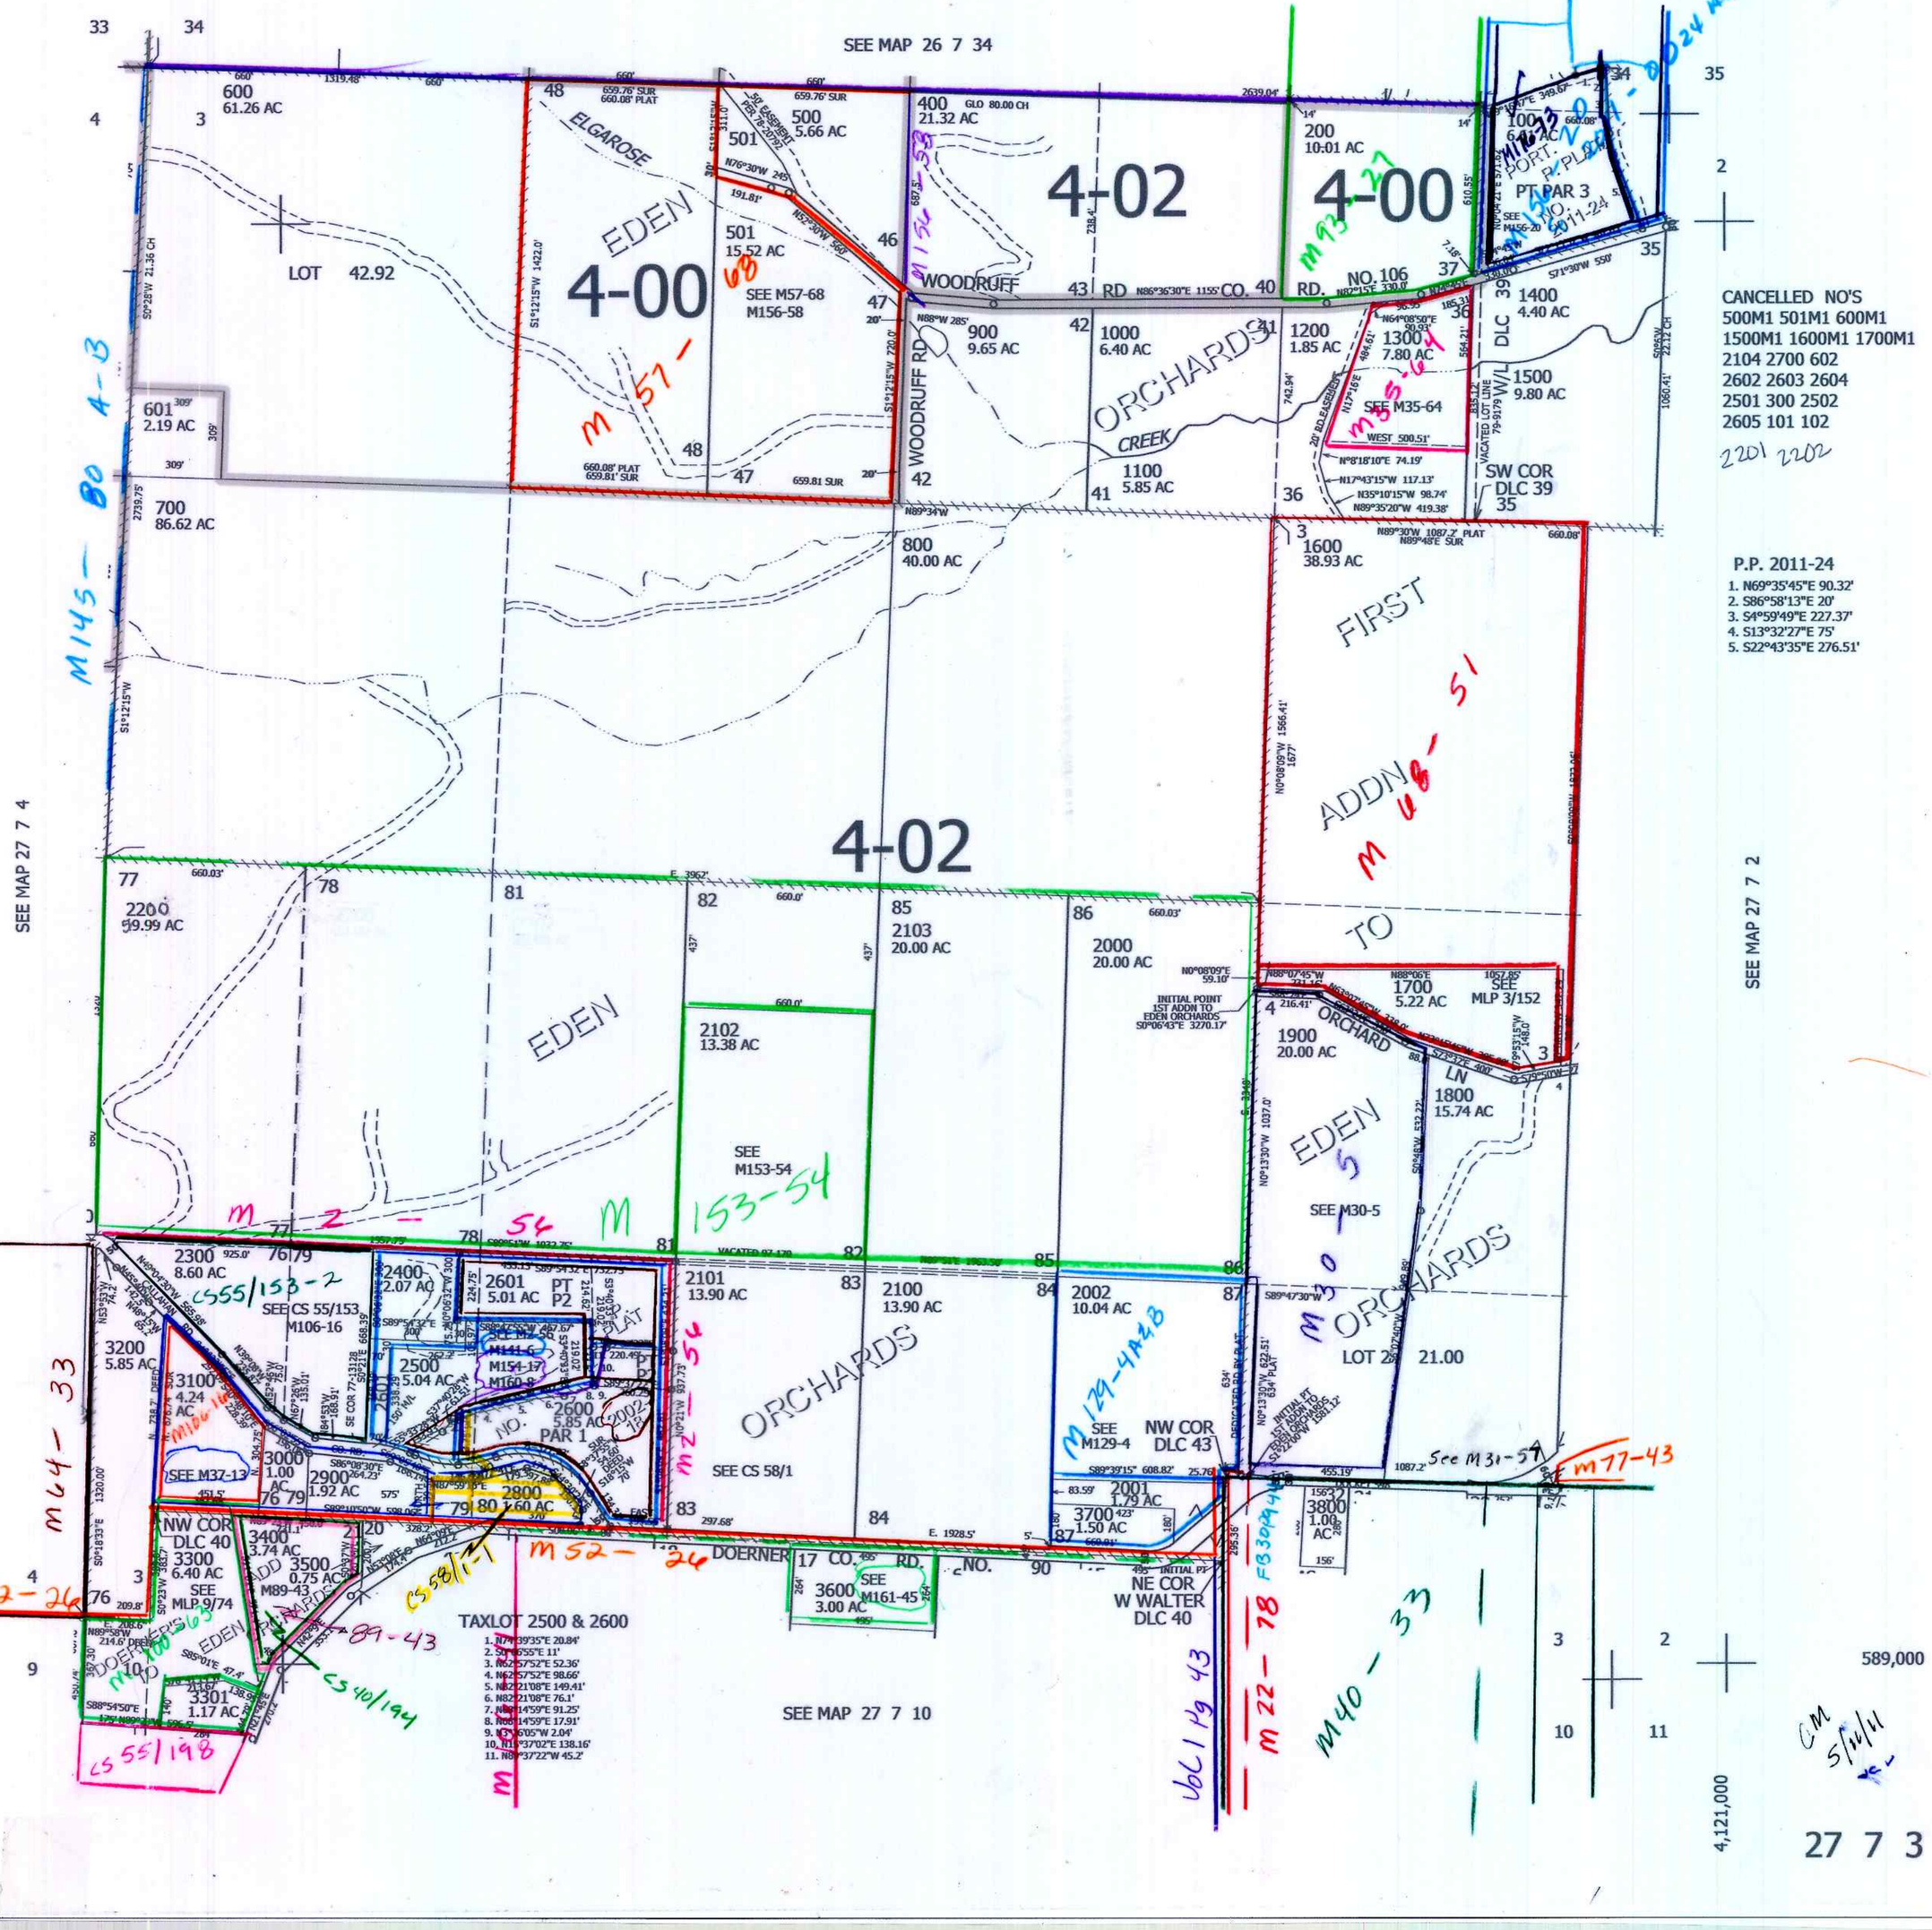

CANCELLED NO'S
500M1 501M1 600M1
1500M1 1600M1 1700M1
2104 2700 602
2602 2603 2604
2501 300 2502
2605 101 102
2201 2202

P.P. 2011-24
1. N69°35'45"E 90.32'
2. S86°58'13"E 20'
3. S4°59'49"E 227.37'
4. S13°32'27"E 75'
5. S22°43'35"E 276.51'

CM 5/10/11

27 7 3