


This map was prepared for assessment purposes only.

SECTION 14 T 27S. R. 7 W. W.M.
DOUGLAS COUNTY

27 7 14

1" = 400'

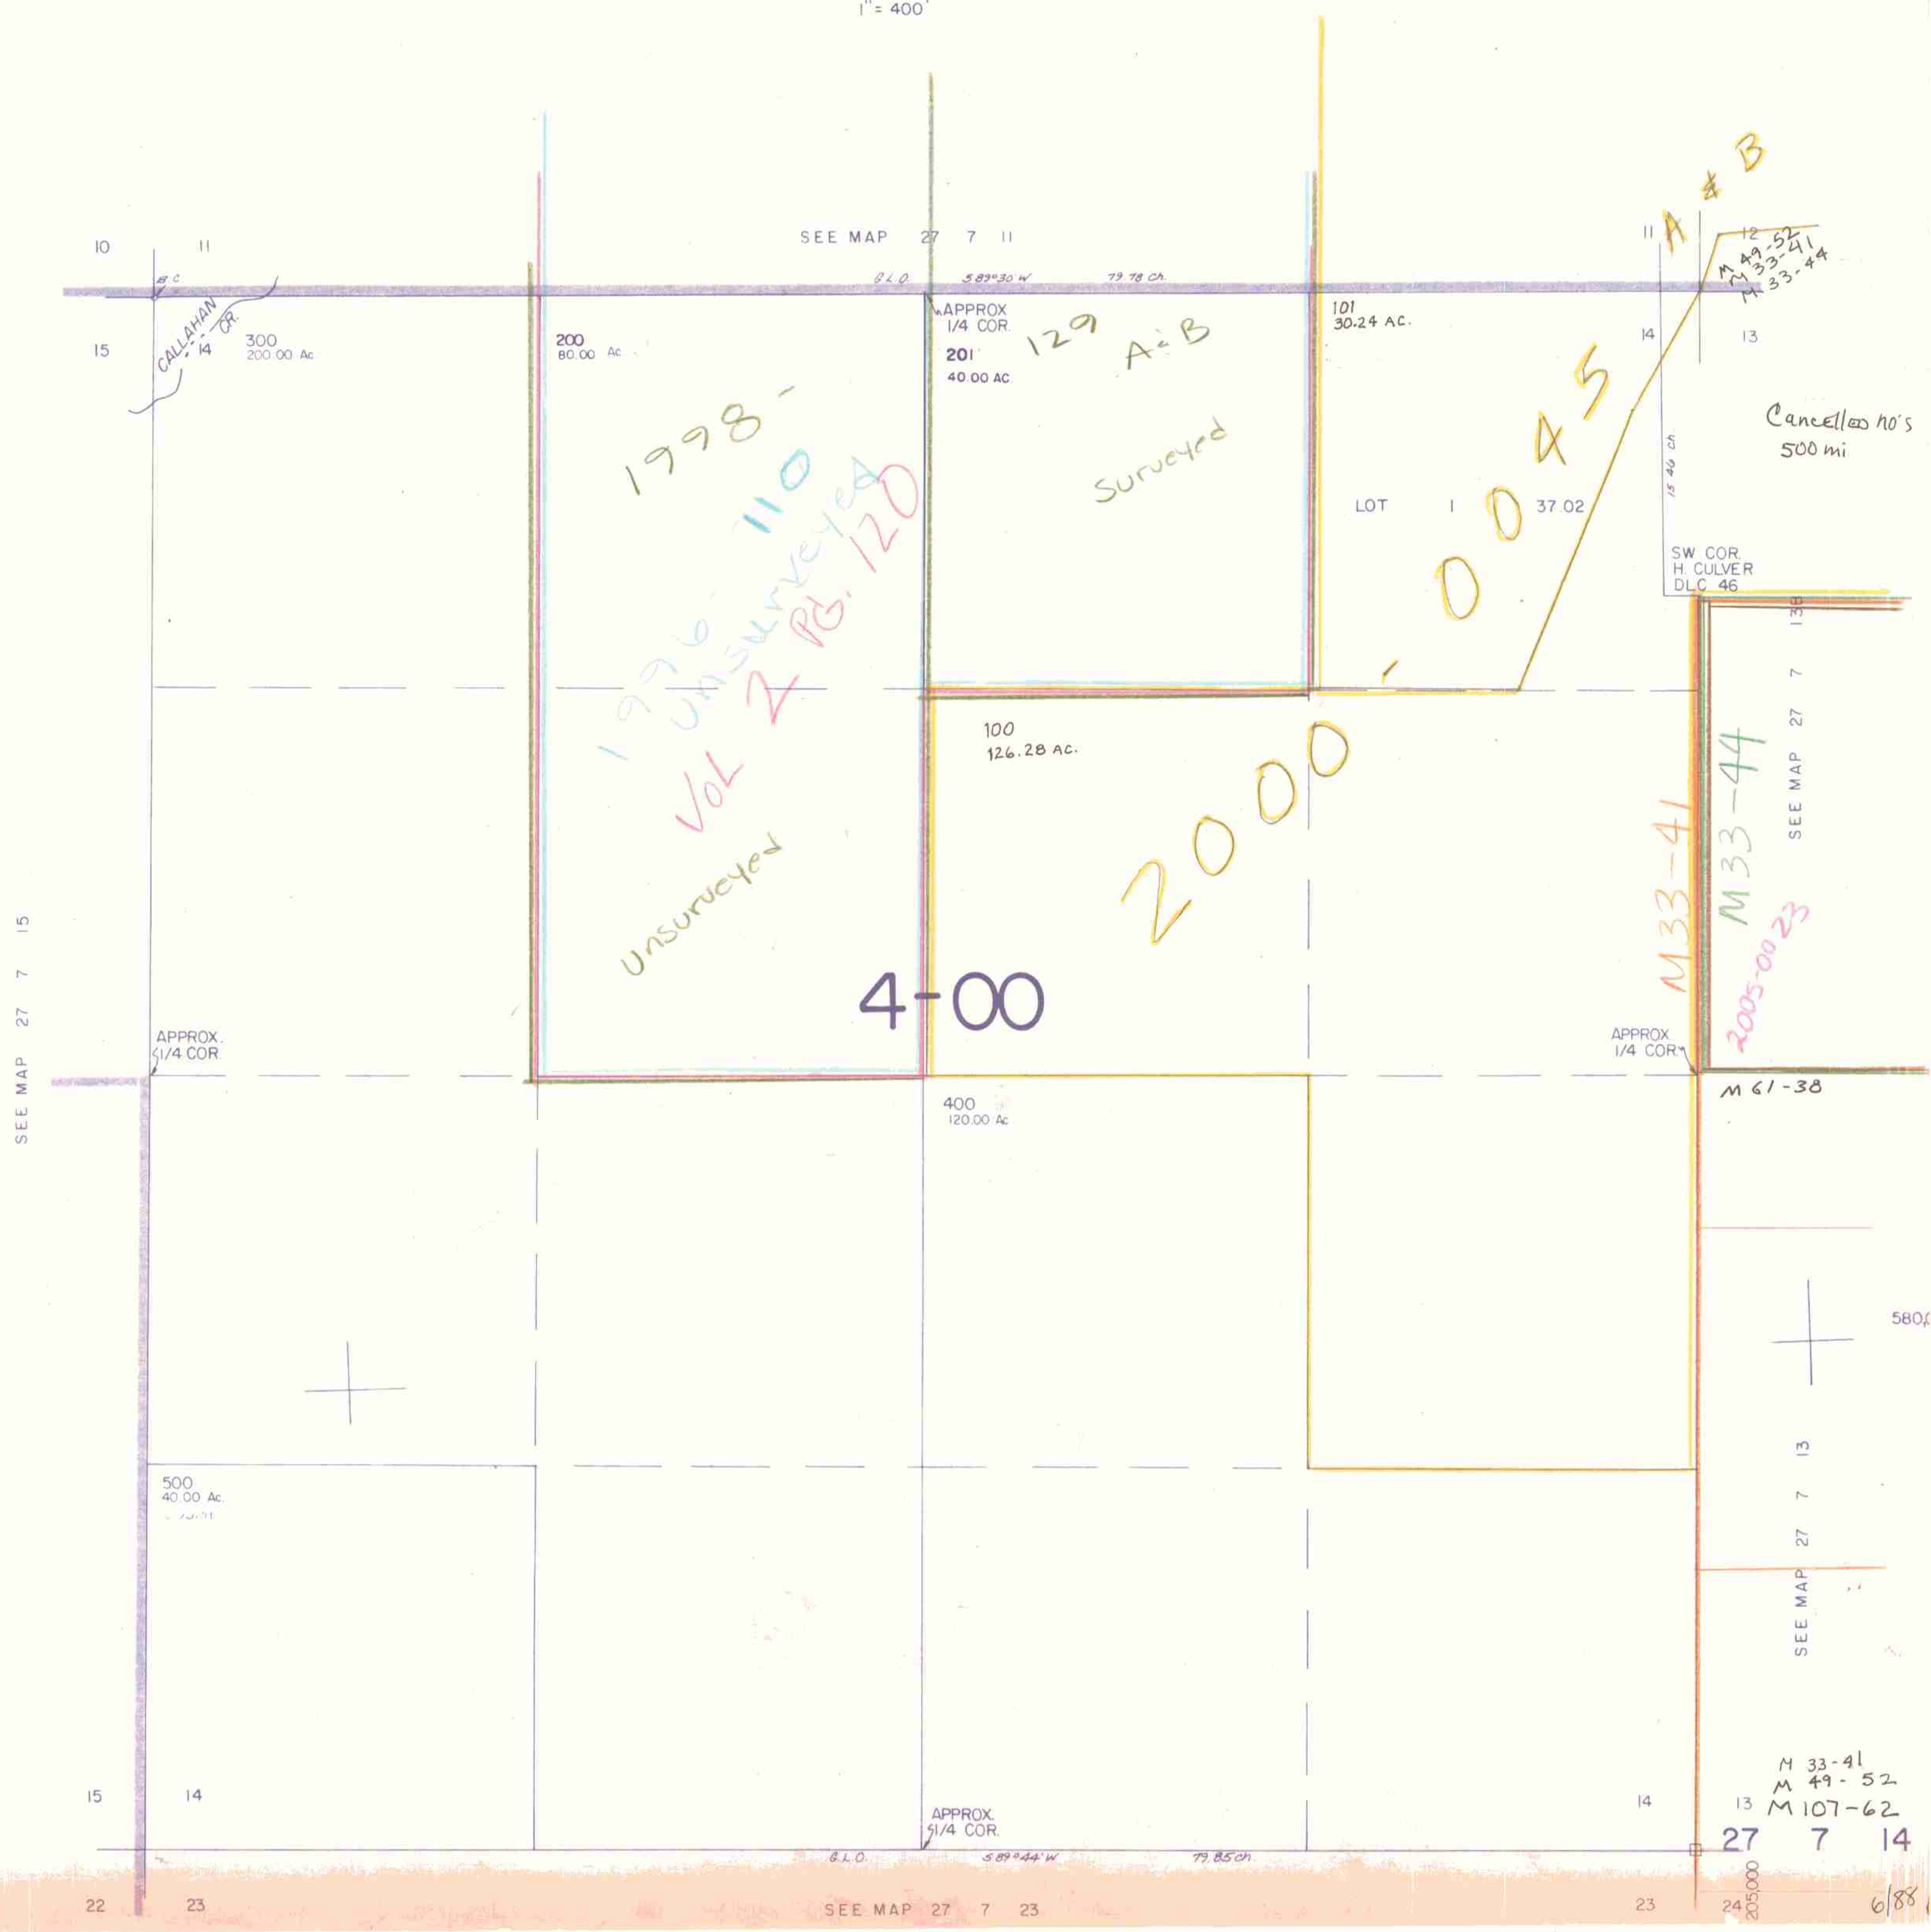

Cancelled no's
500 mi

SW COR.
H. CULVER
DLC 46

M 33-44
2005-0023

M 61-38

M 33-41
M 49-52
M 107-62

27 7 14

205,000
6/88