SECTION 26 T.27S. R.7W. W.M.
DOUGLAS COUNTY
1"=400'

27 7 26
&INDEX

THIS MAP WAS PREPARED FOR ASSESSMENT PURPOSE ONLY.

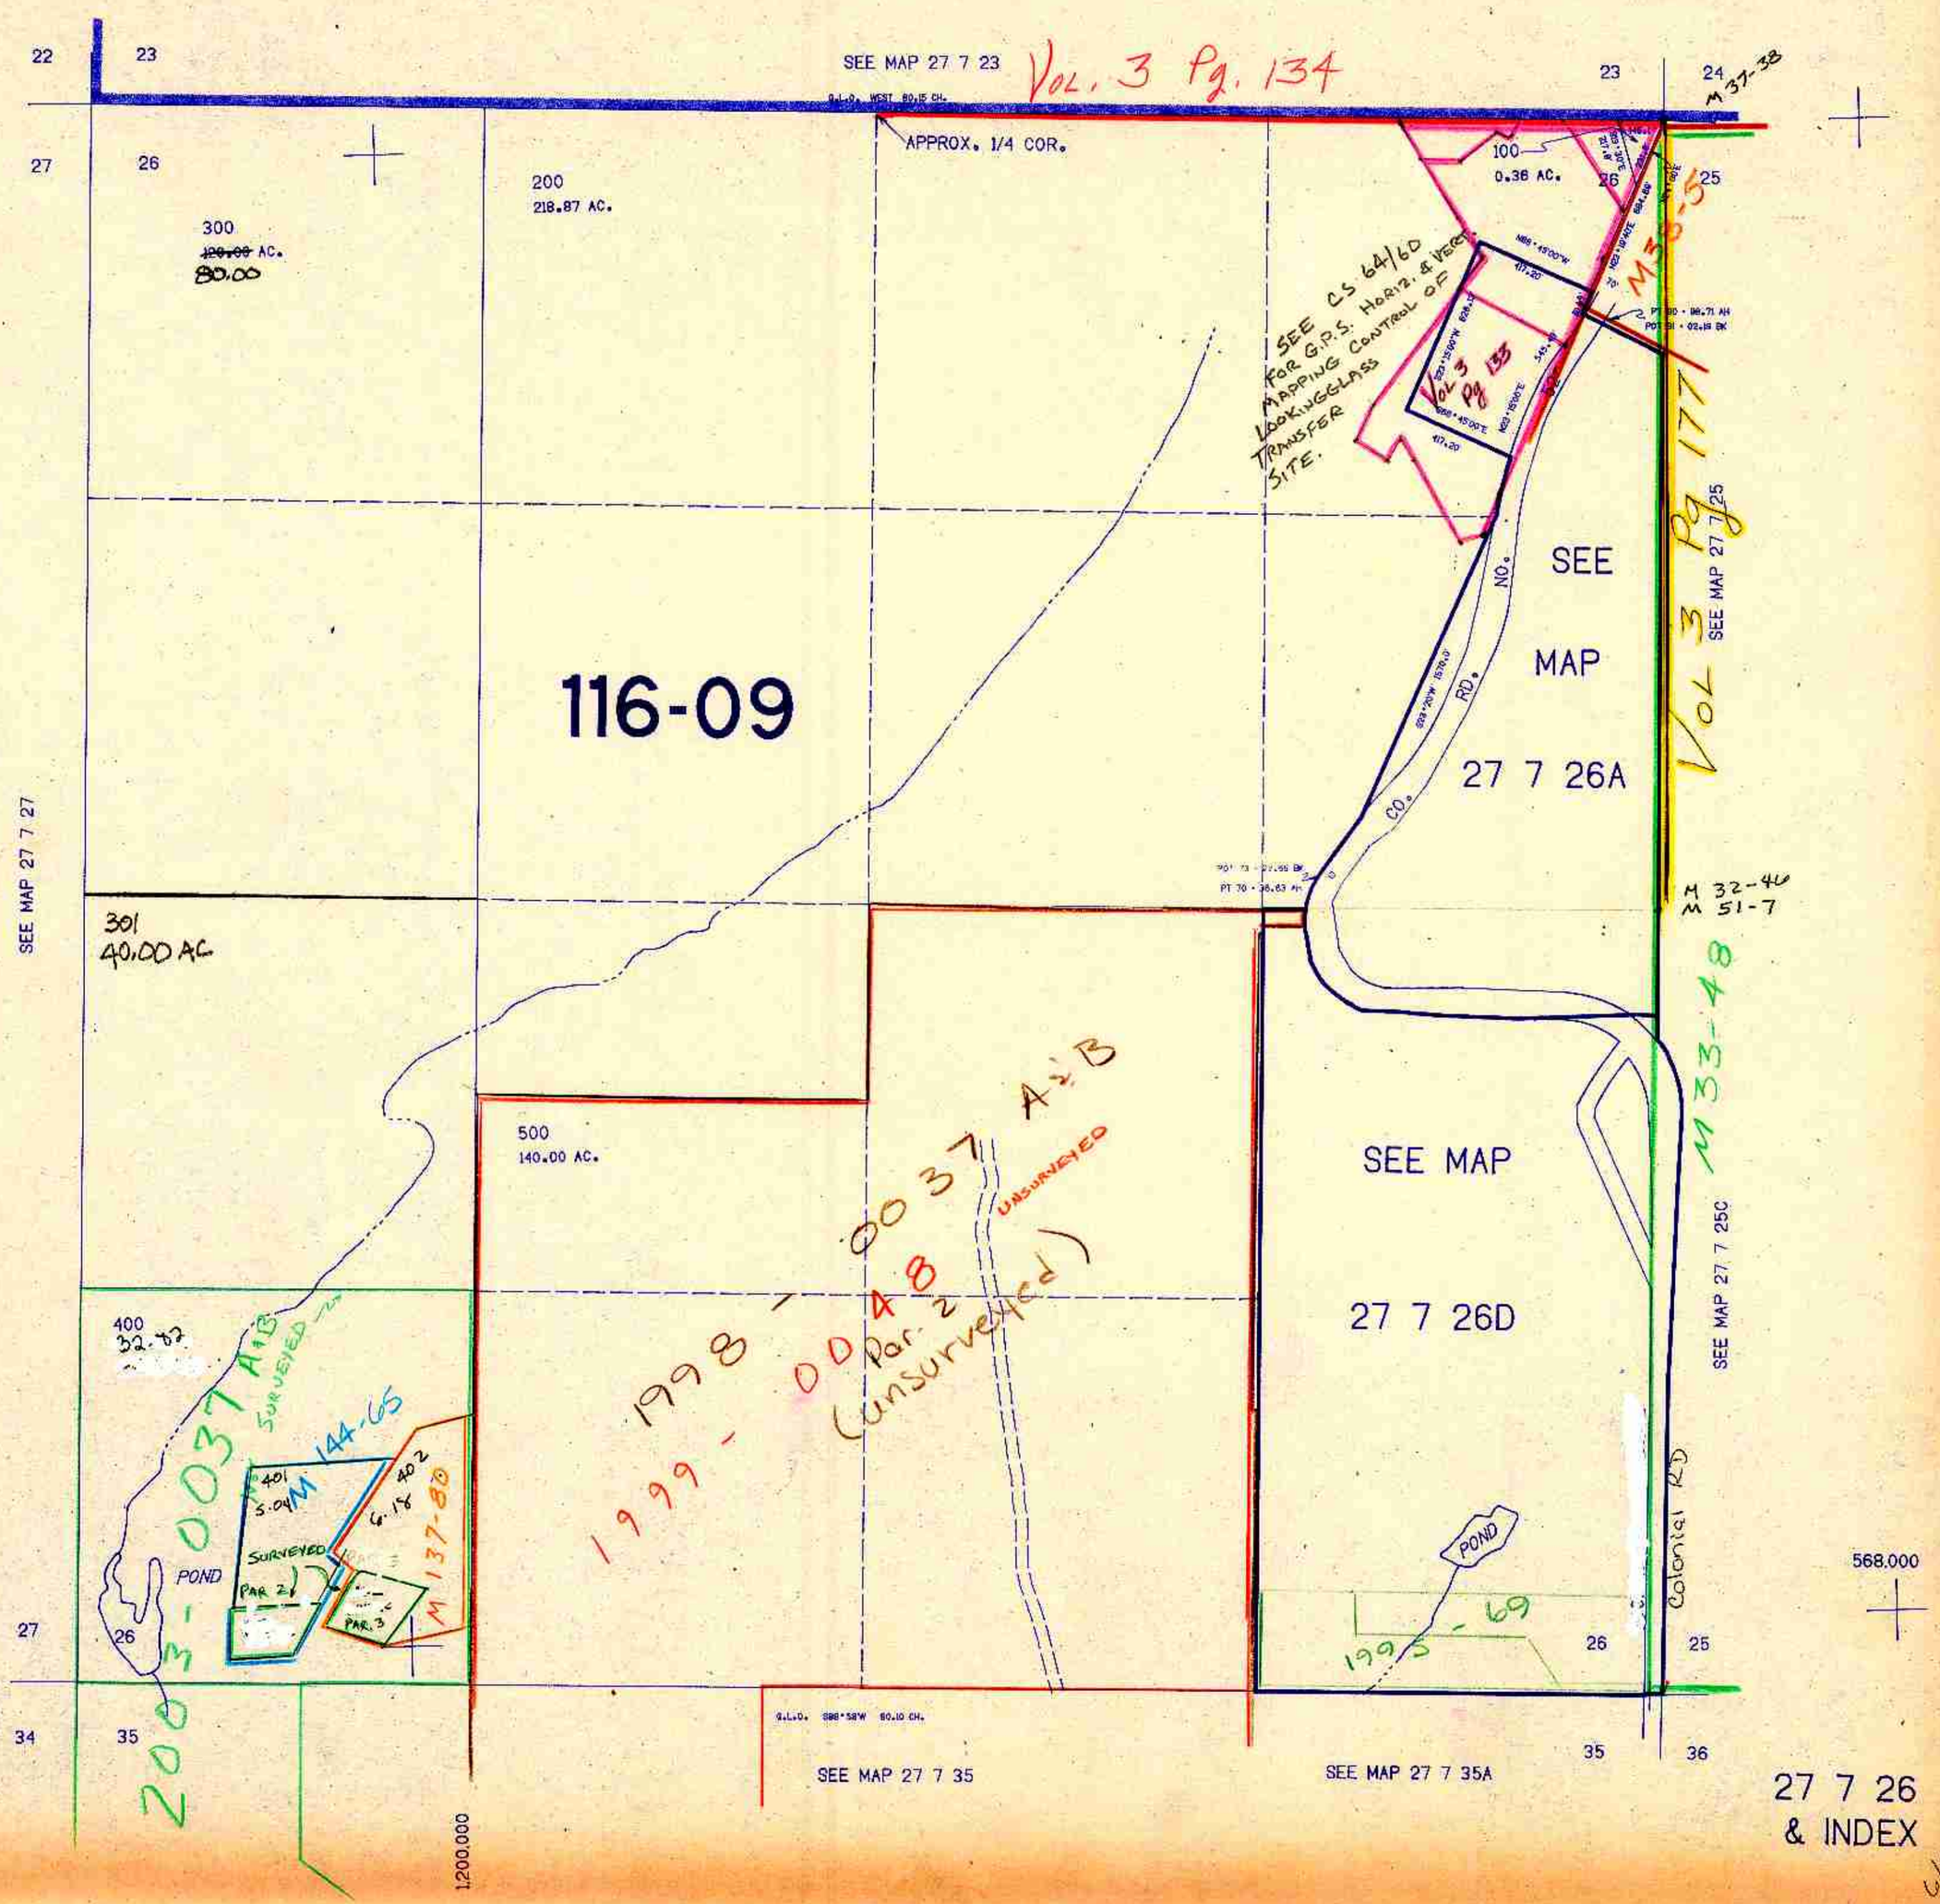

27 7 26
& INDEX