


DONATION LAND CLAIM INDEX
T27S R7W

DLC INDEX
T27S R7W

NOT TO SCALE

THIS MAP WAS PREPARED FOR
ASSESSMENT PURPOSE ONLY.

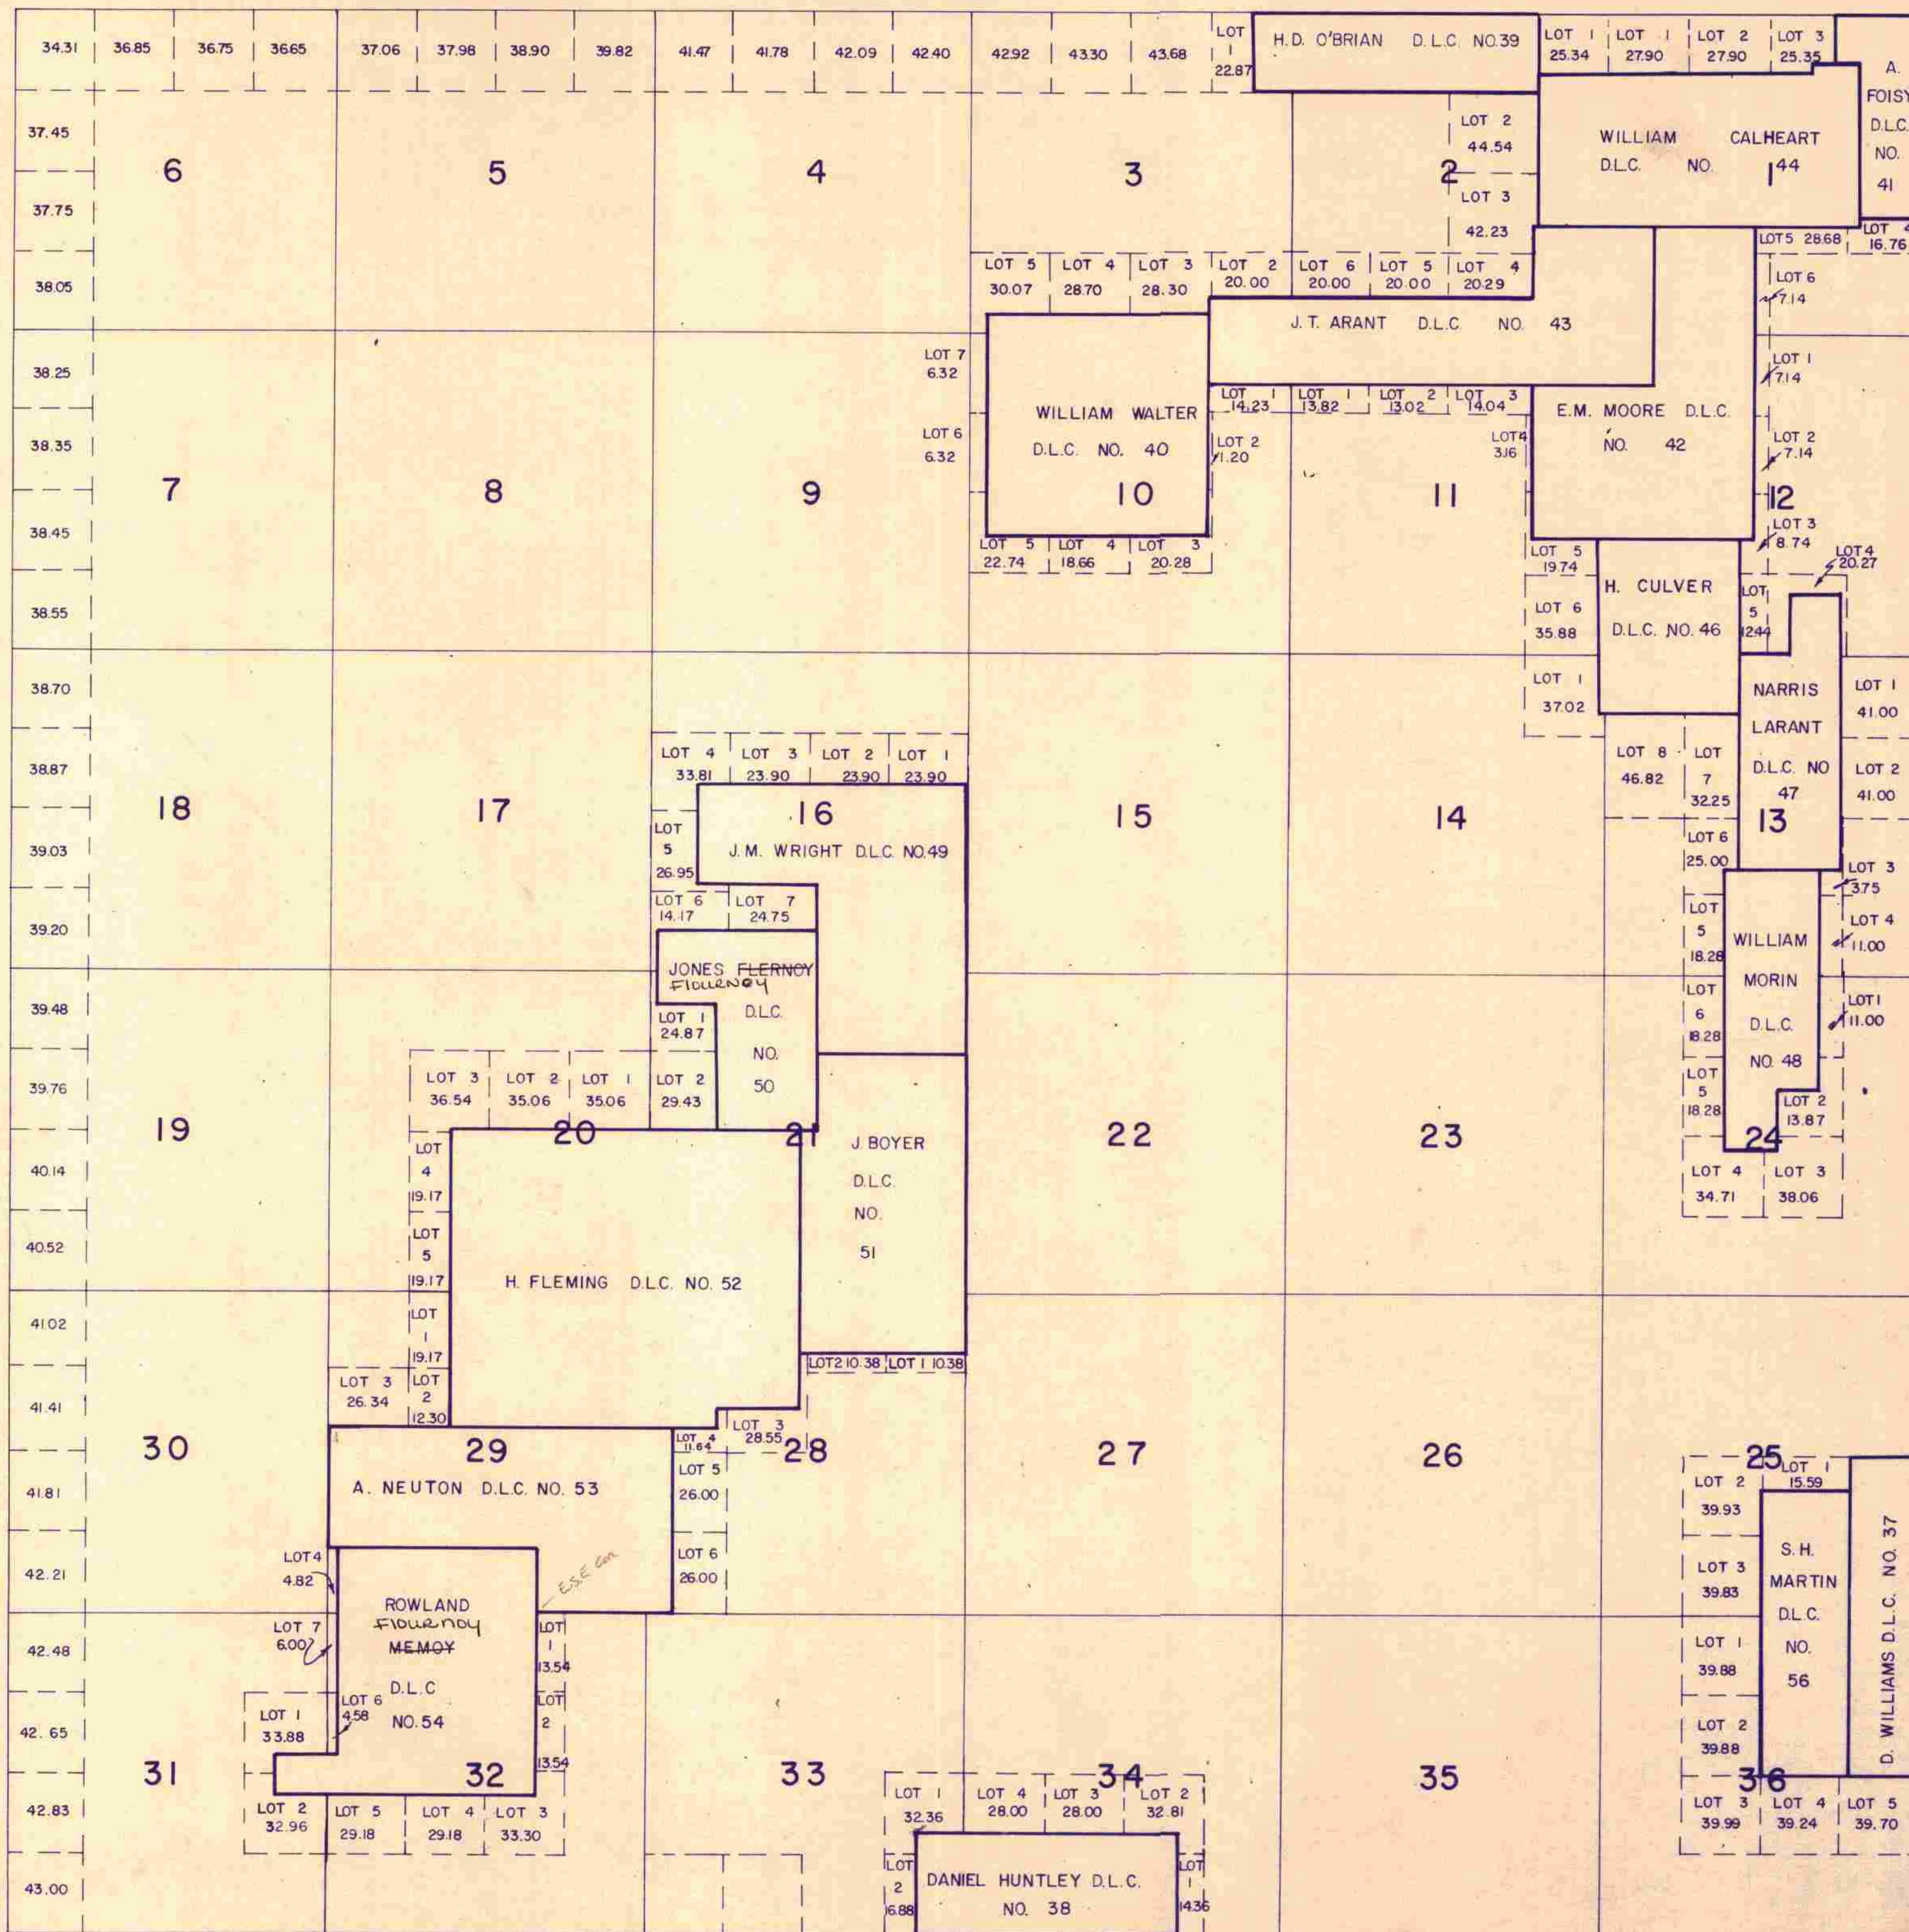

REFER TO ORIGINAL
DONATION LAND CLAIM
PLAY FOR SURVEY
DETAIL AND TO THE
D.L.C. LISTING FOR
SPECIFIC LOCATION
OF CORNERS ON
1" = 100' & 1" = 200'

DLC INDEX
T27S R7W