THIS MAP WAS PREPARED FOR ASSESSMENT PURPOSE ONLY.

SECTION 7 T.28S. R.4 W.W.M.
DOUGLAS COUNTY

1" = 400'

REVISED ON 1-4-96

28 4 7

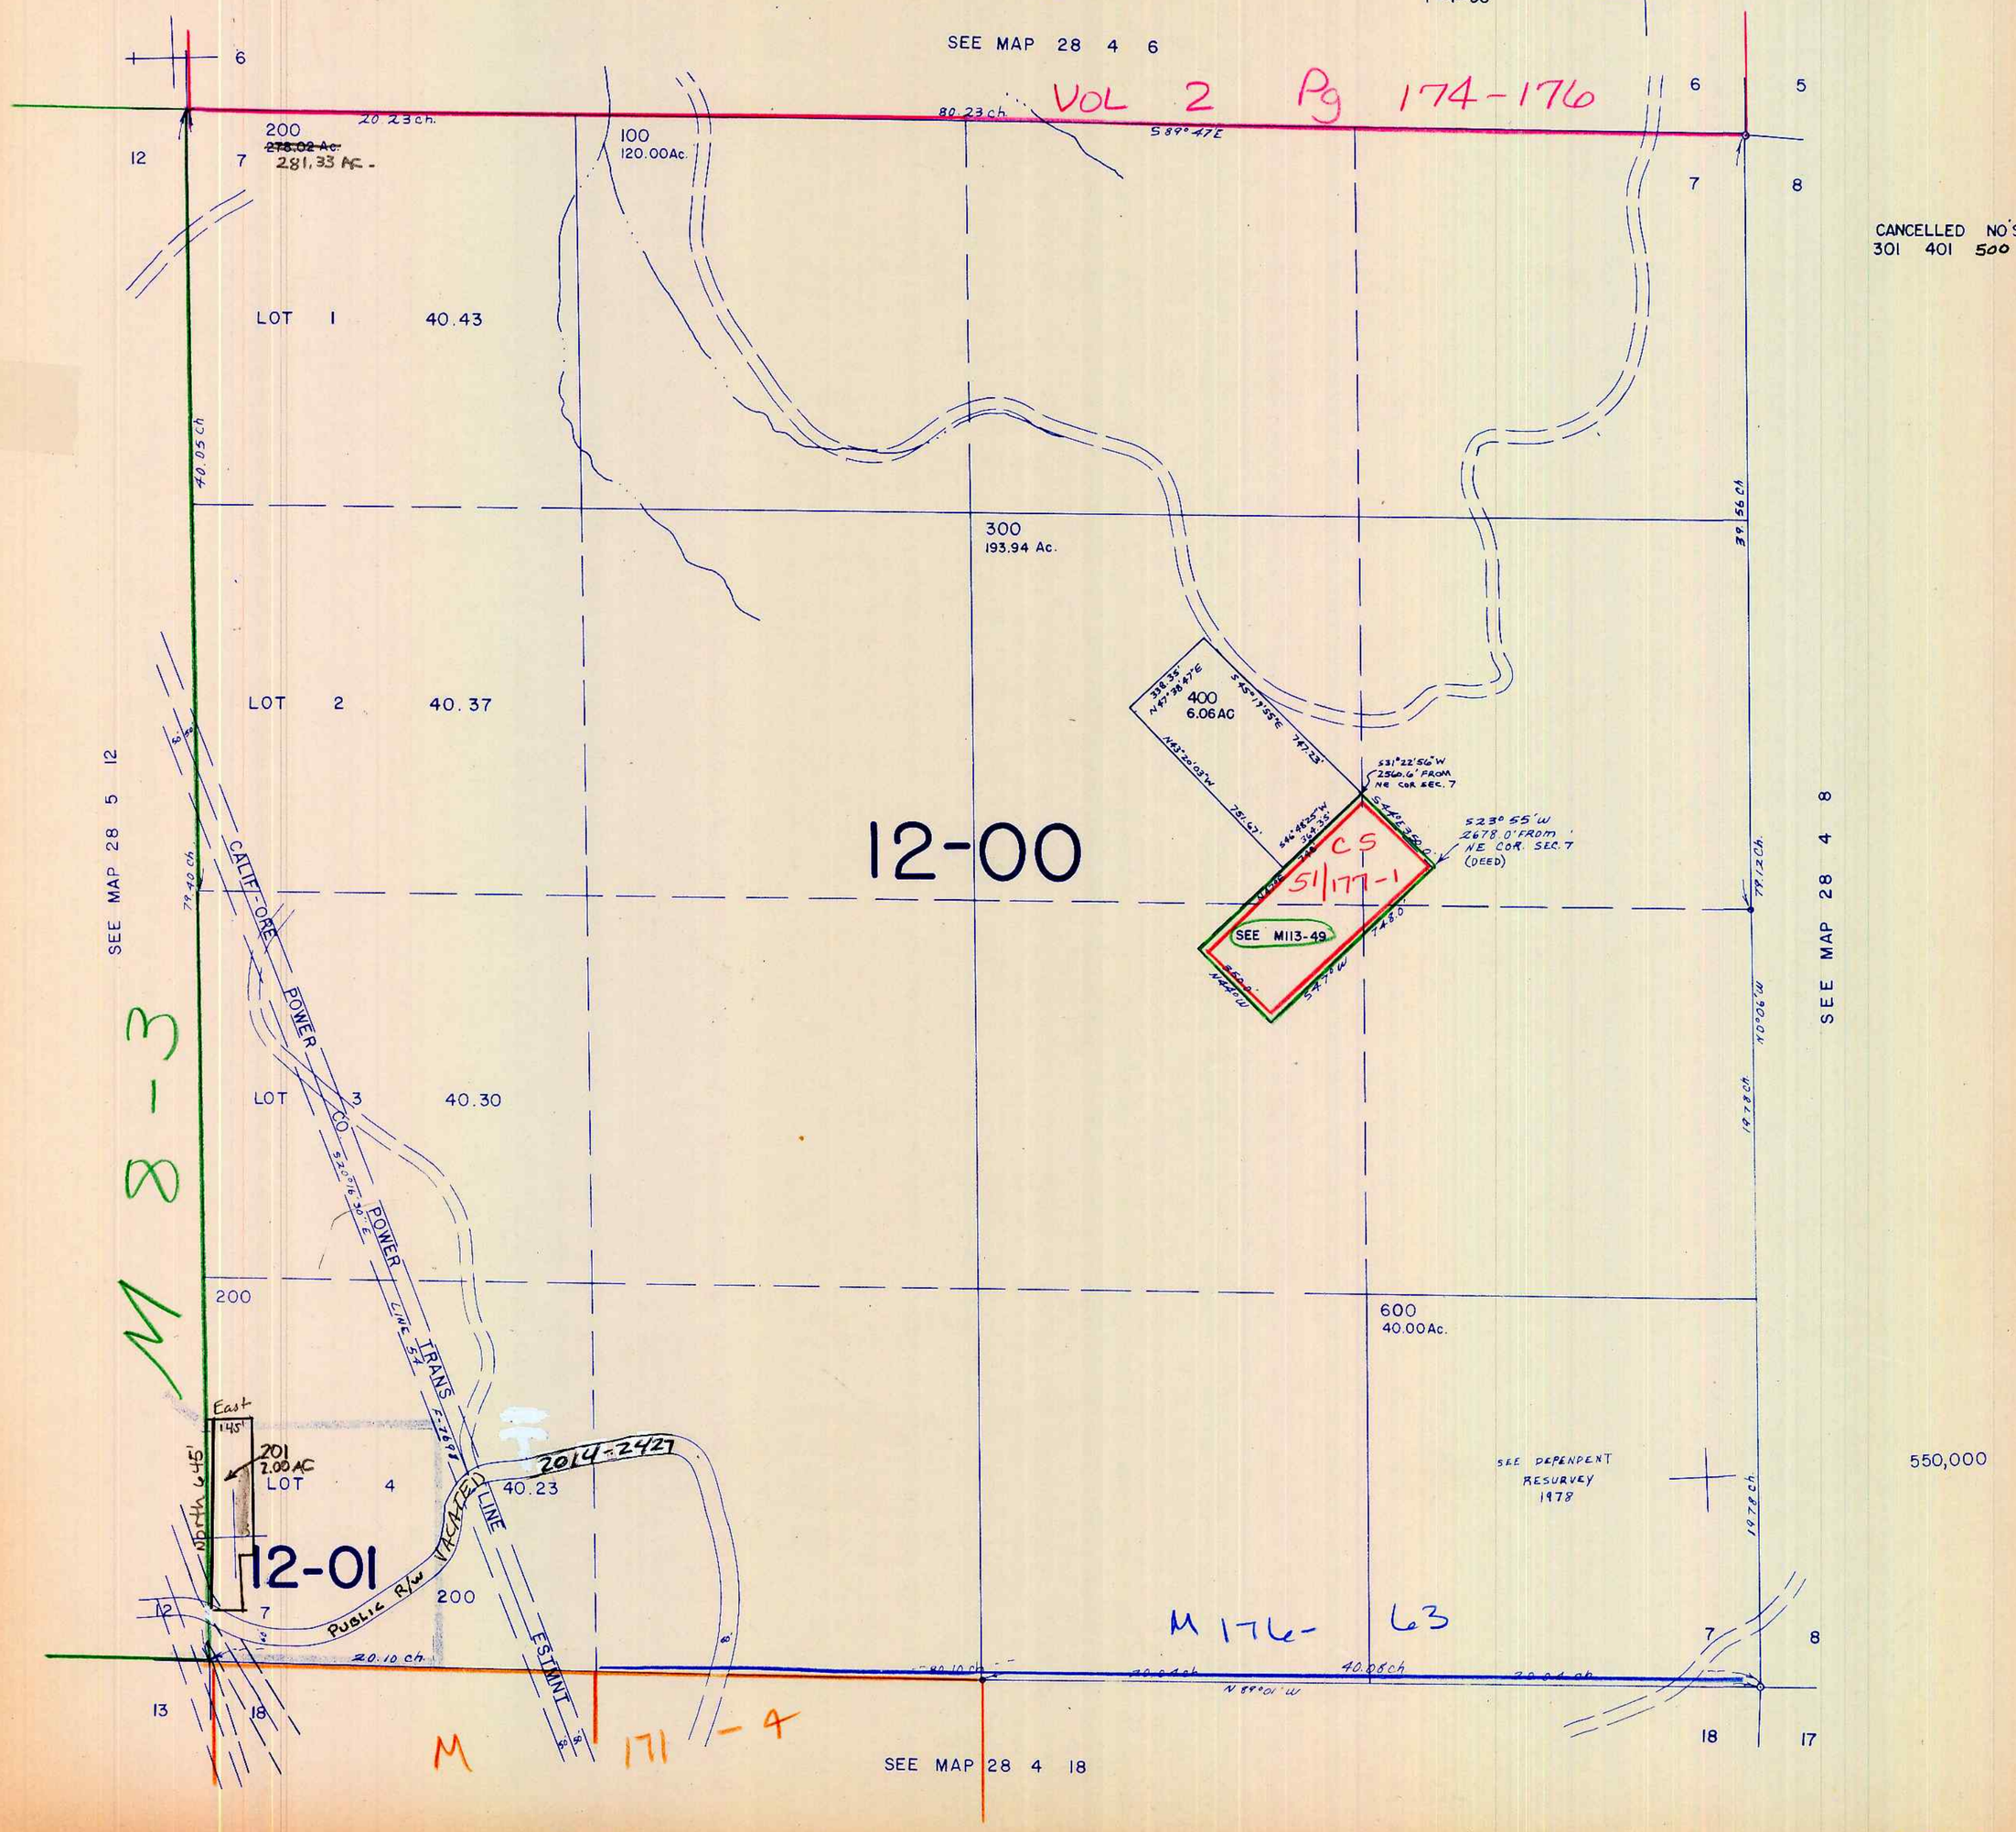

28 4 7

2/96