


THIS MAP WAS PREPARED FOR ASSESSMENT PURPOSE ONLY.

SECTION 8 T.28S. R. 4 W. W.M.  
DOUGLAS COUNTY

28 4 8

1" = 400'

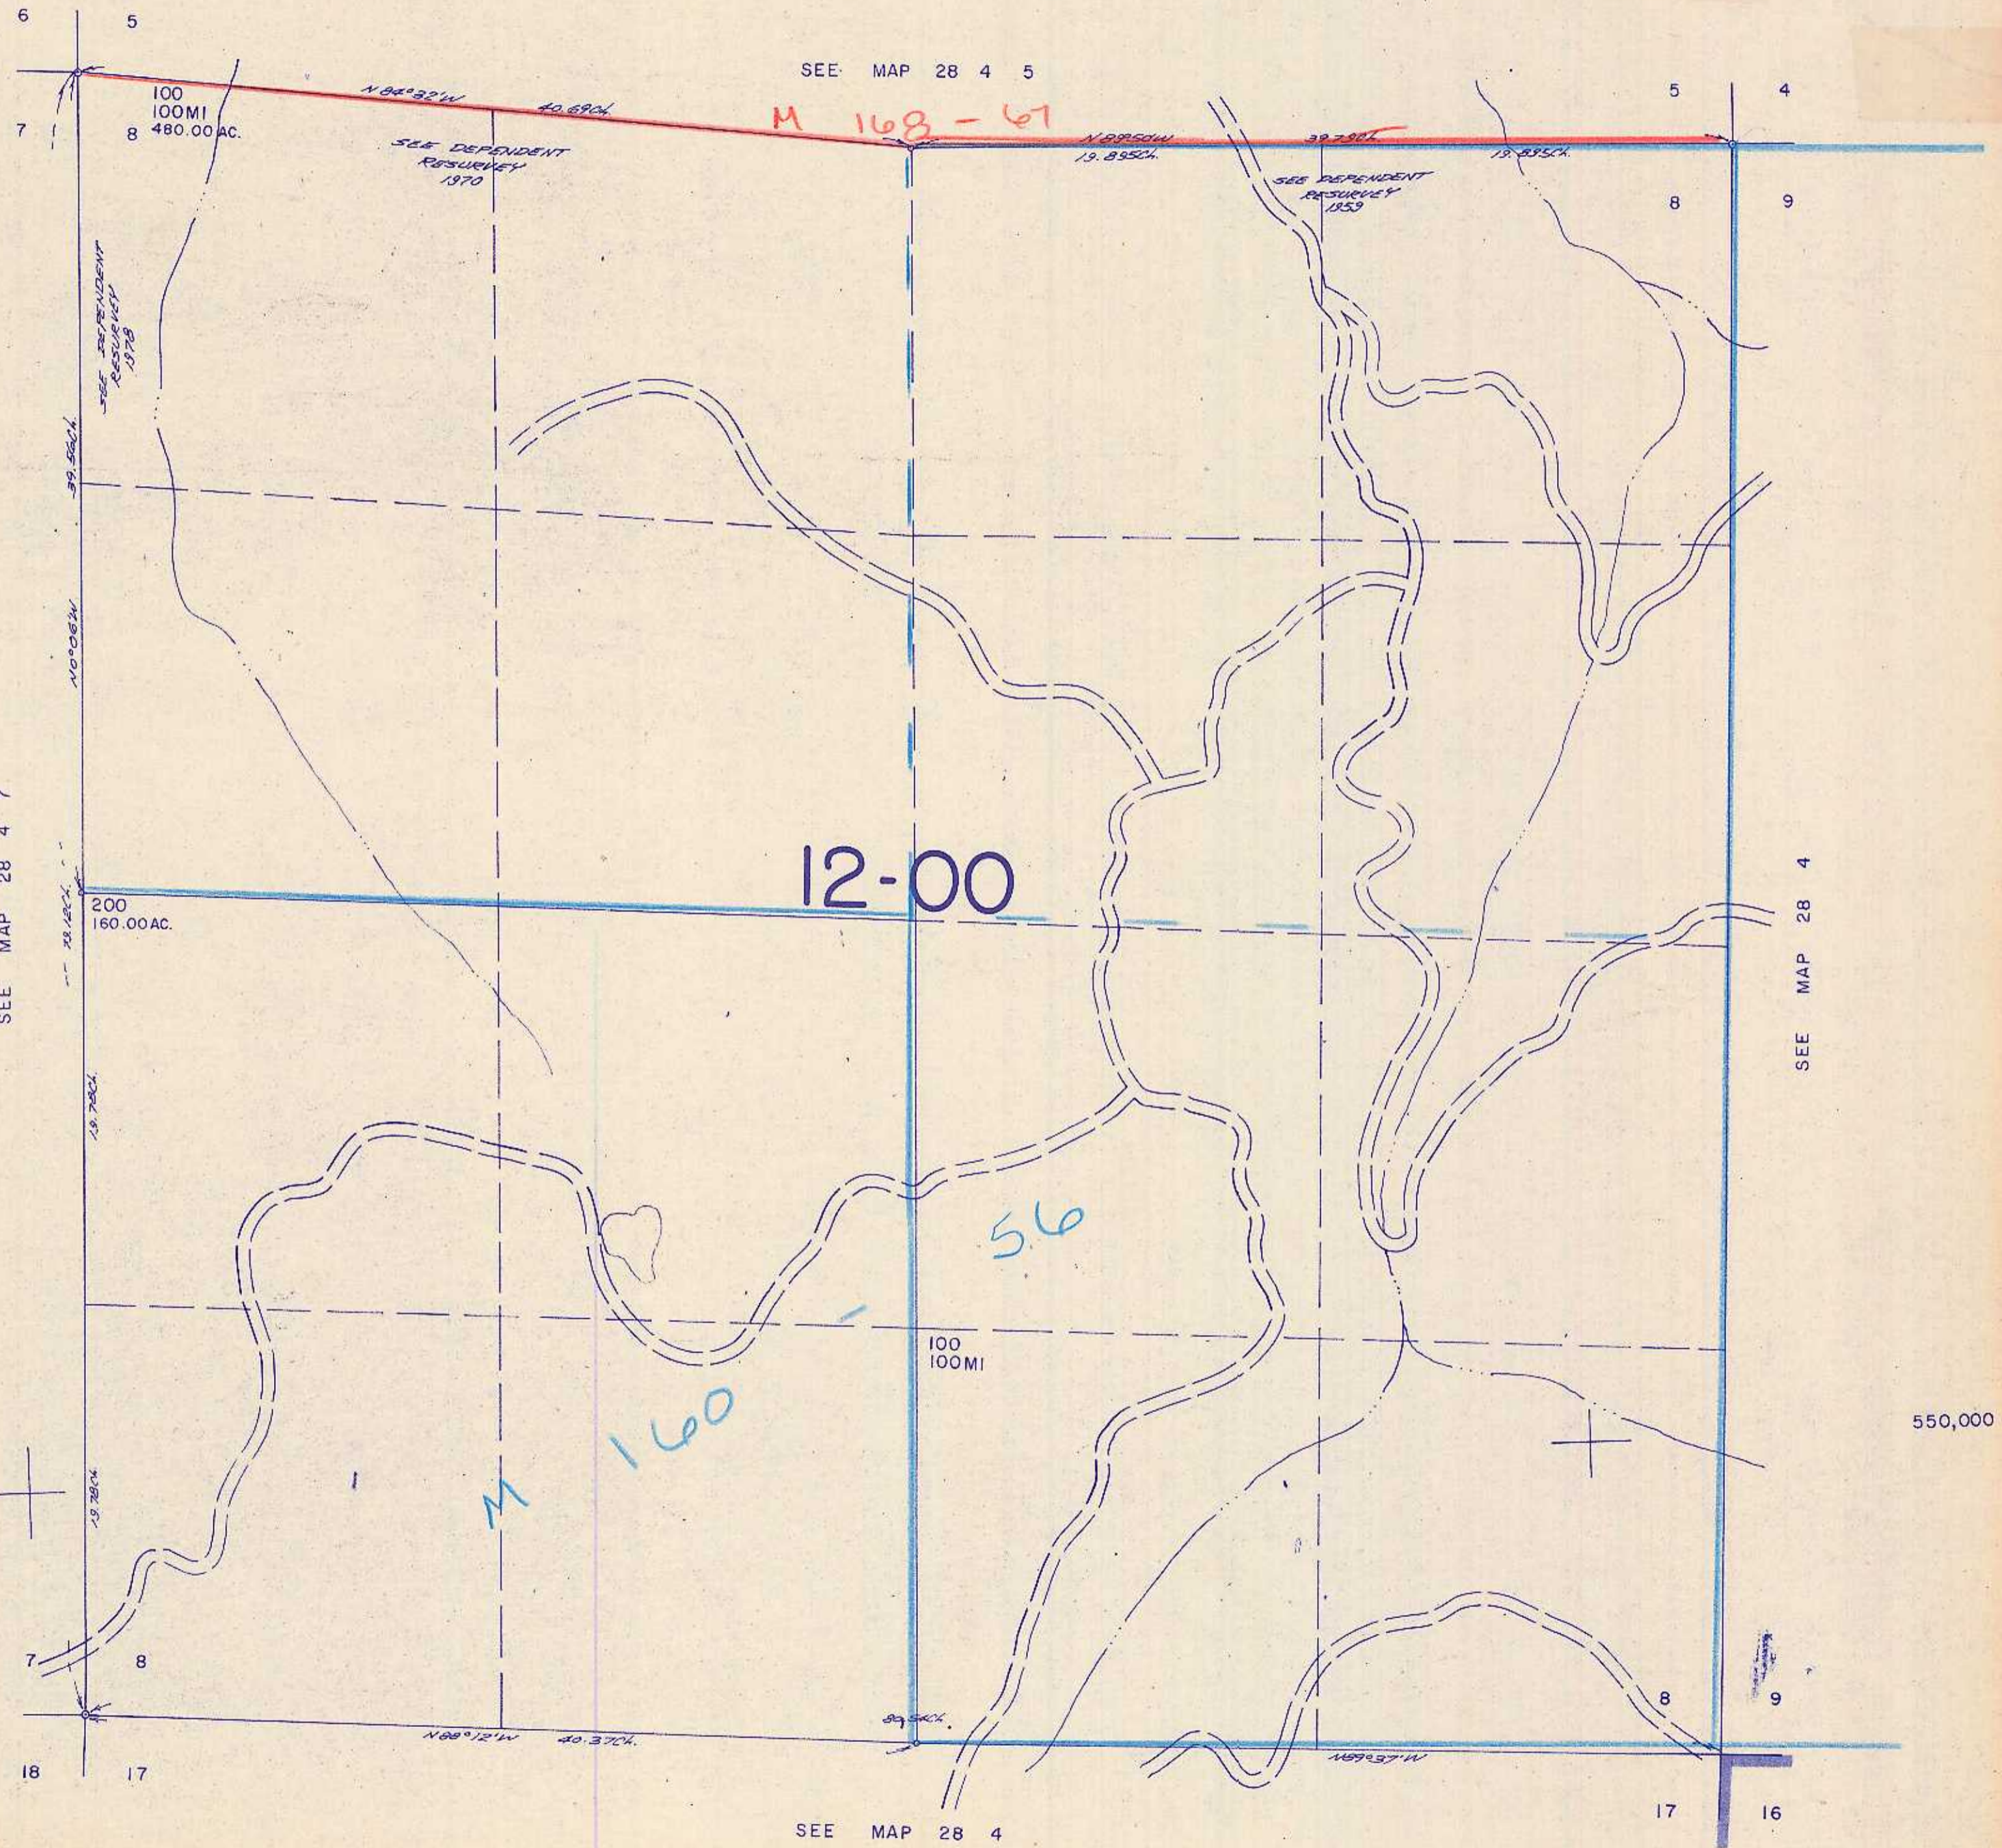

SEE MAP 28 4 7

SEE MAP 28 4

12-00

56

160

550,000

1,278,000

28 4 8

5/85  
C/MC