


THIS MAP WAS PREPARED FOR ASSESSMENT PURPOSE ONLY.

SECTION 31 T.28S. R.4W. W.M.
DOUGLAS COUNTY

28 4 31

1" = 400'

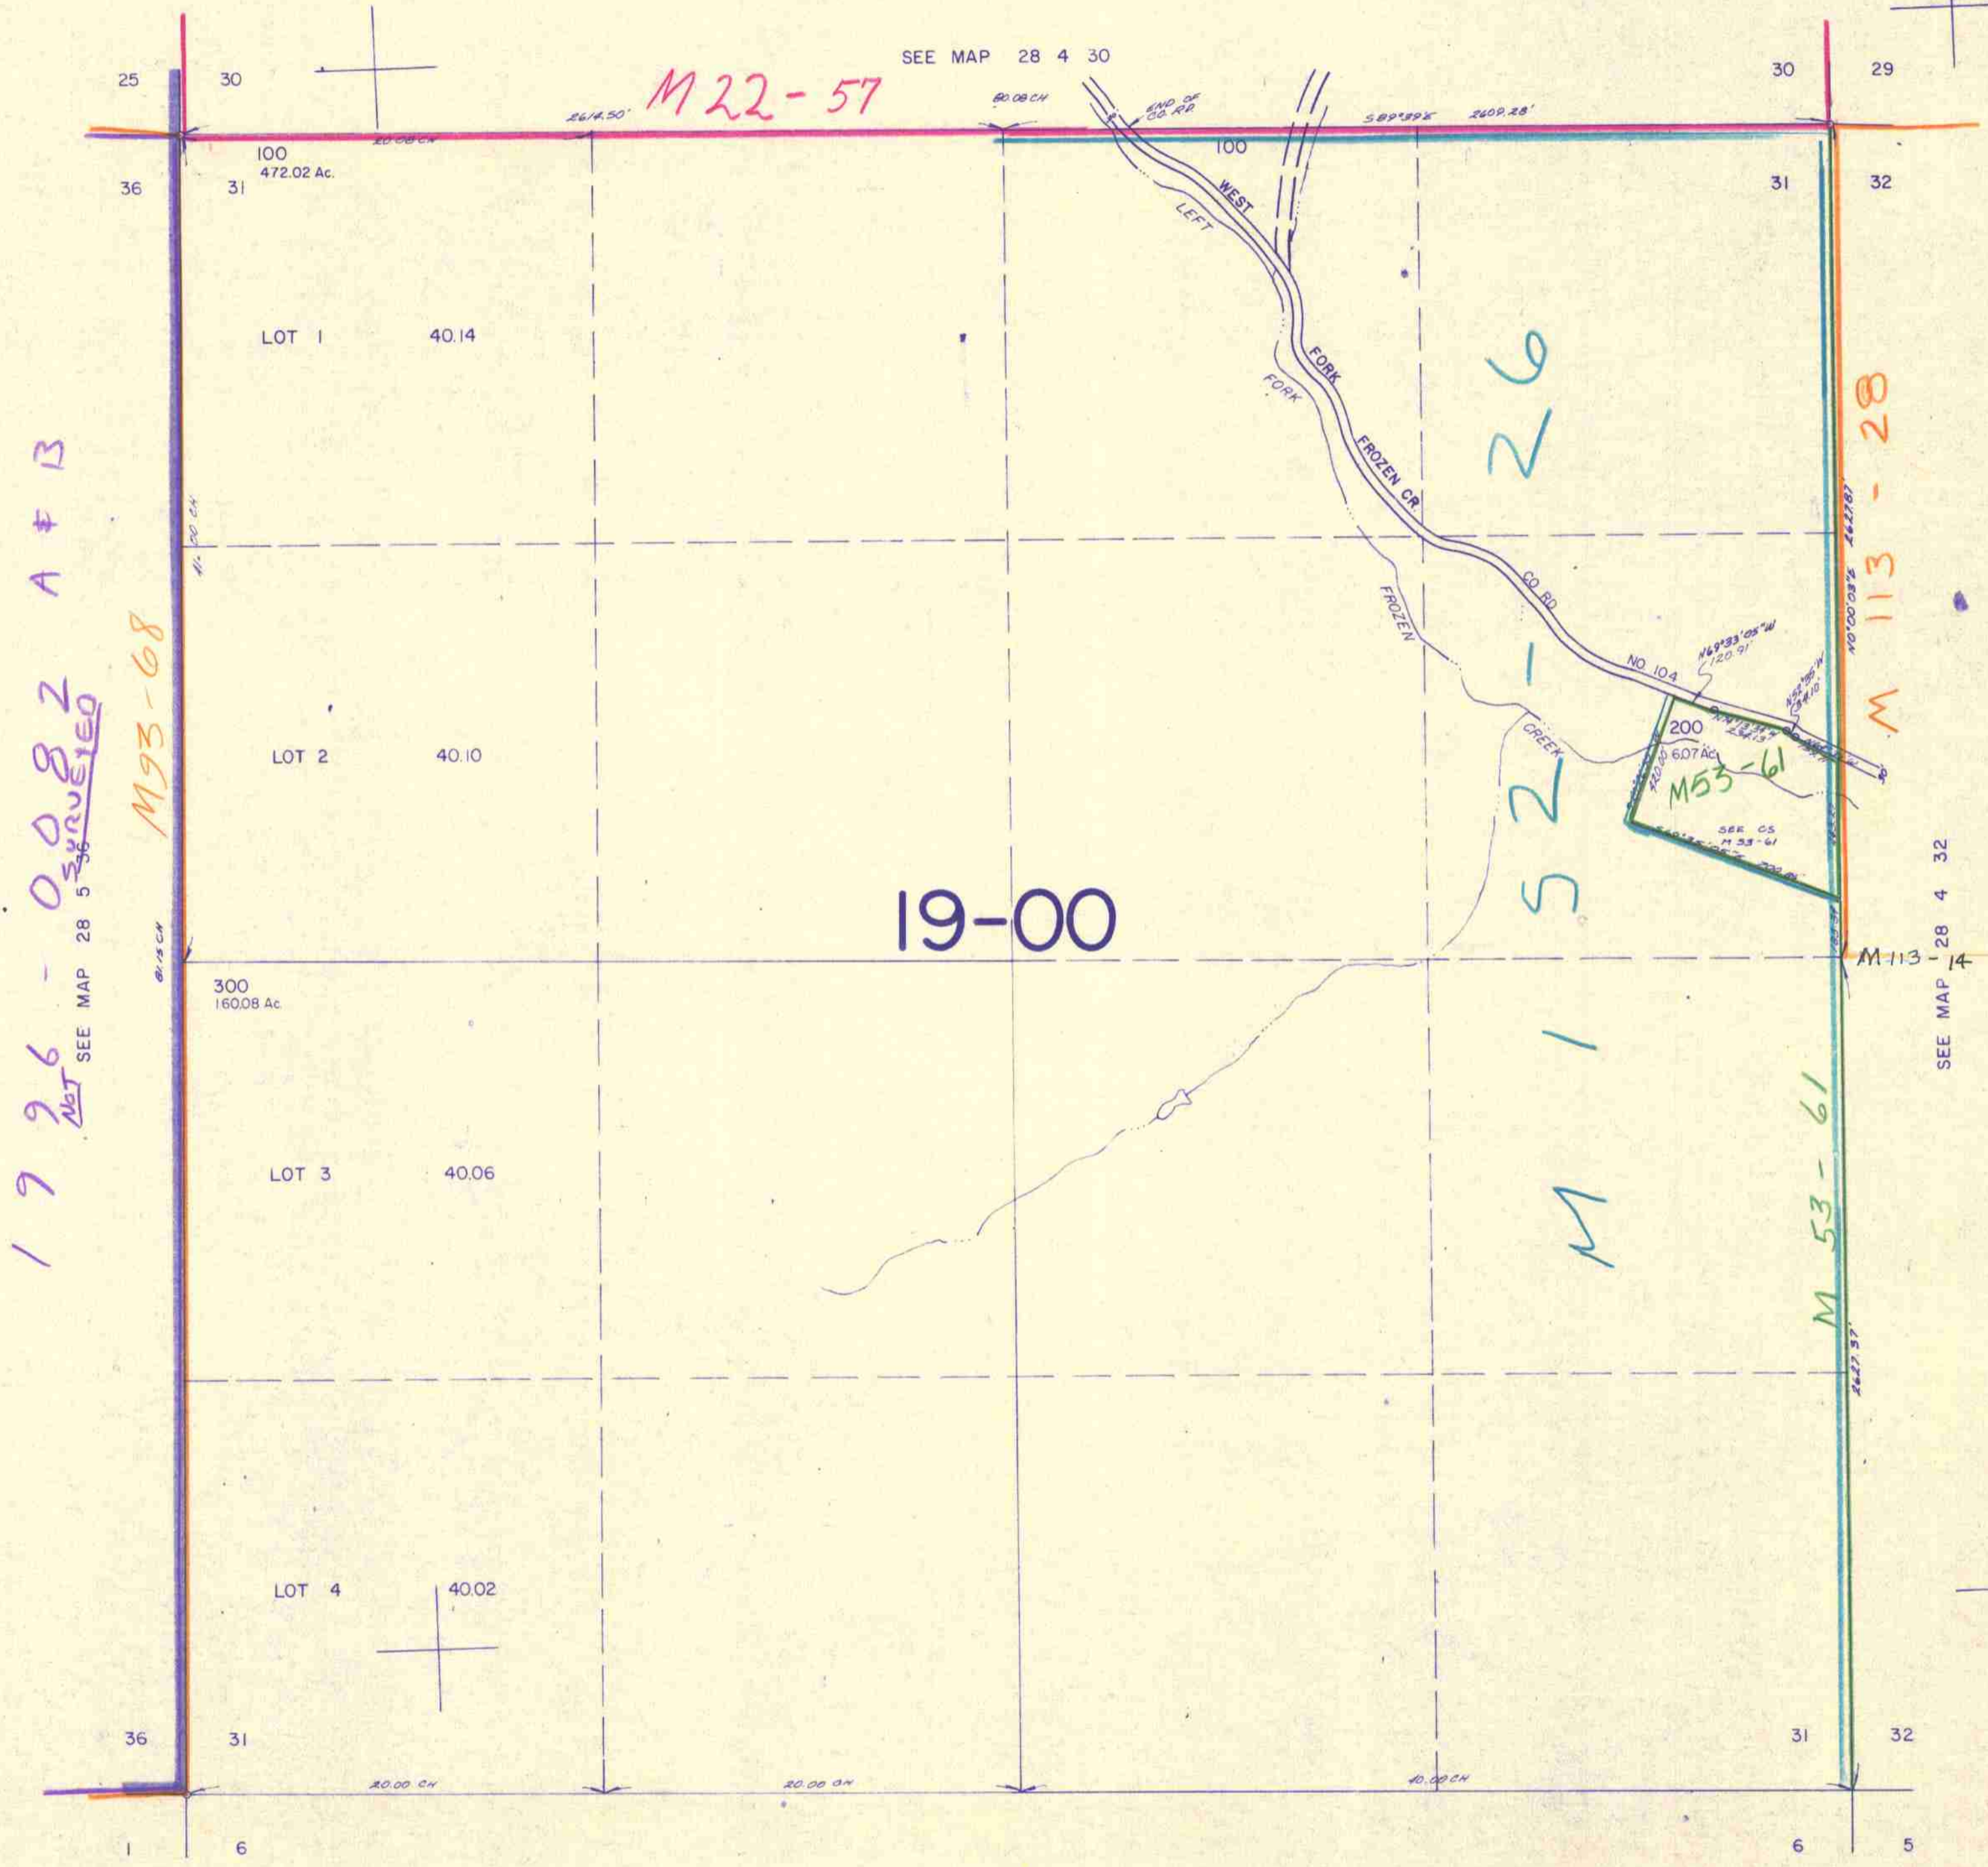

1926 - 0082 A & B
NOT SURVEYED
SEE MAP 28 5 36

M93-68

M22-57

19-00

26

52-1

M1

M113-28

M53-61

SEE MAP 29 4 6

28 4 31

5/86
CMT