


SECTION 7 T.28S. R.5W. W.M.
DOUGLAS COUNTY

REVISED ON
3-26-97

28 5 7

THIS MAP WAS PREPARED FOR
ASSESSMENT PURPOSE ONLY.

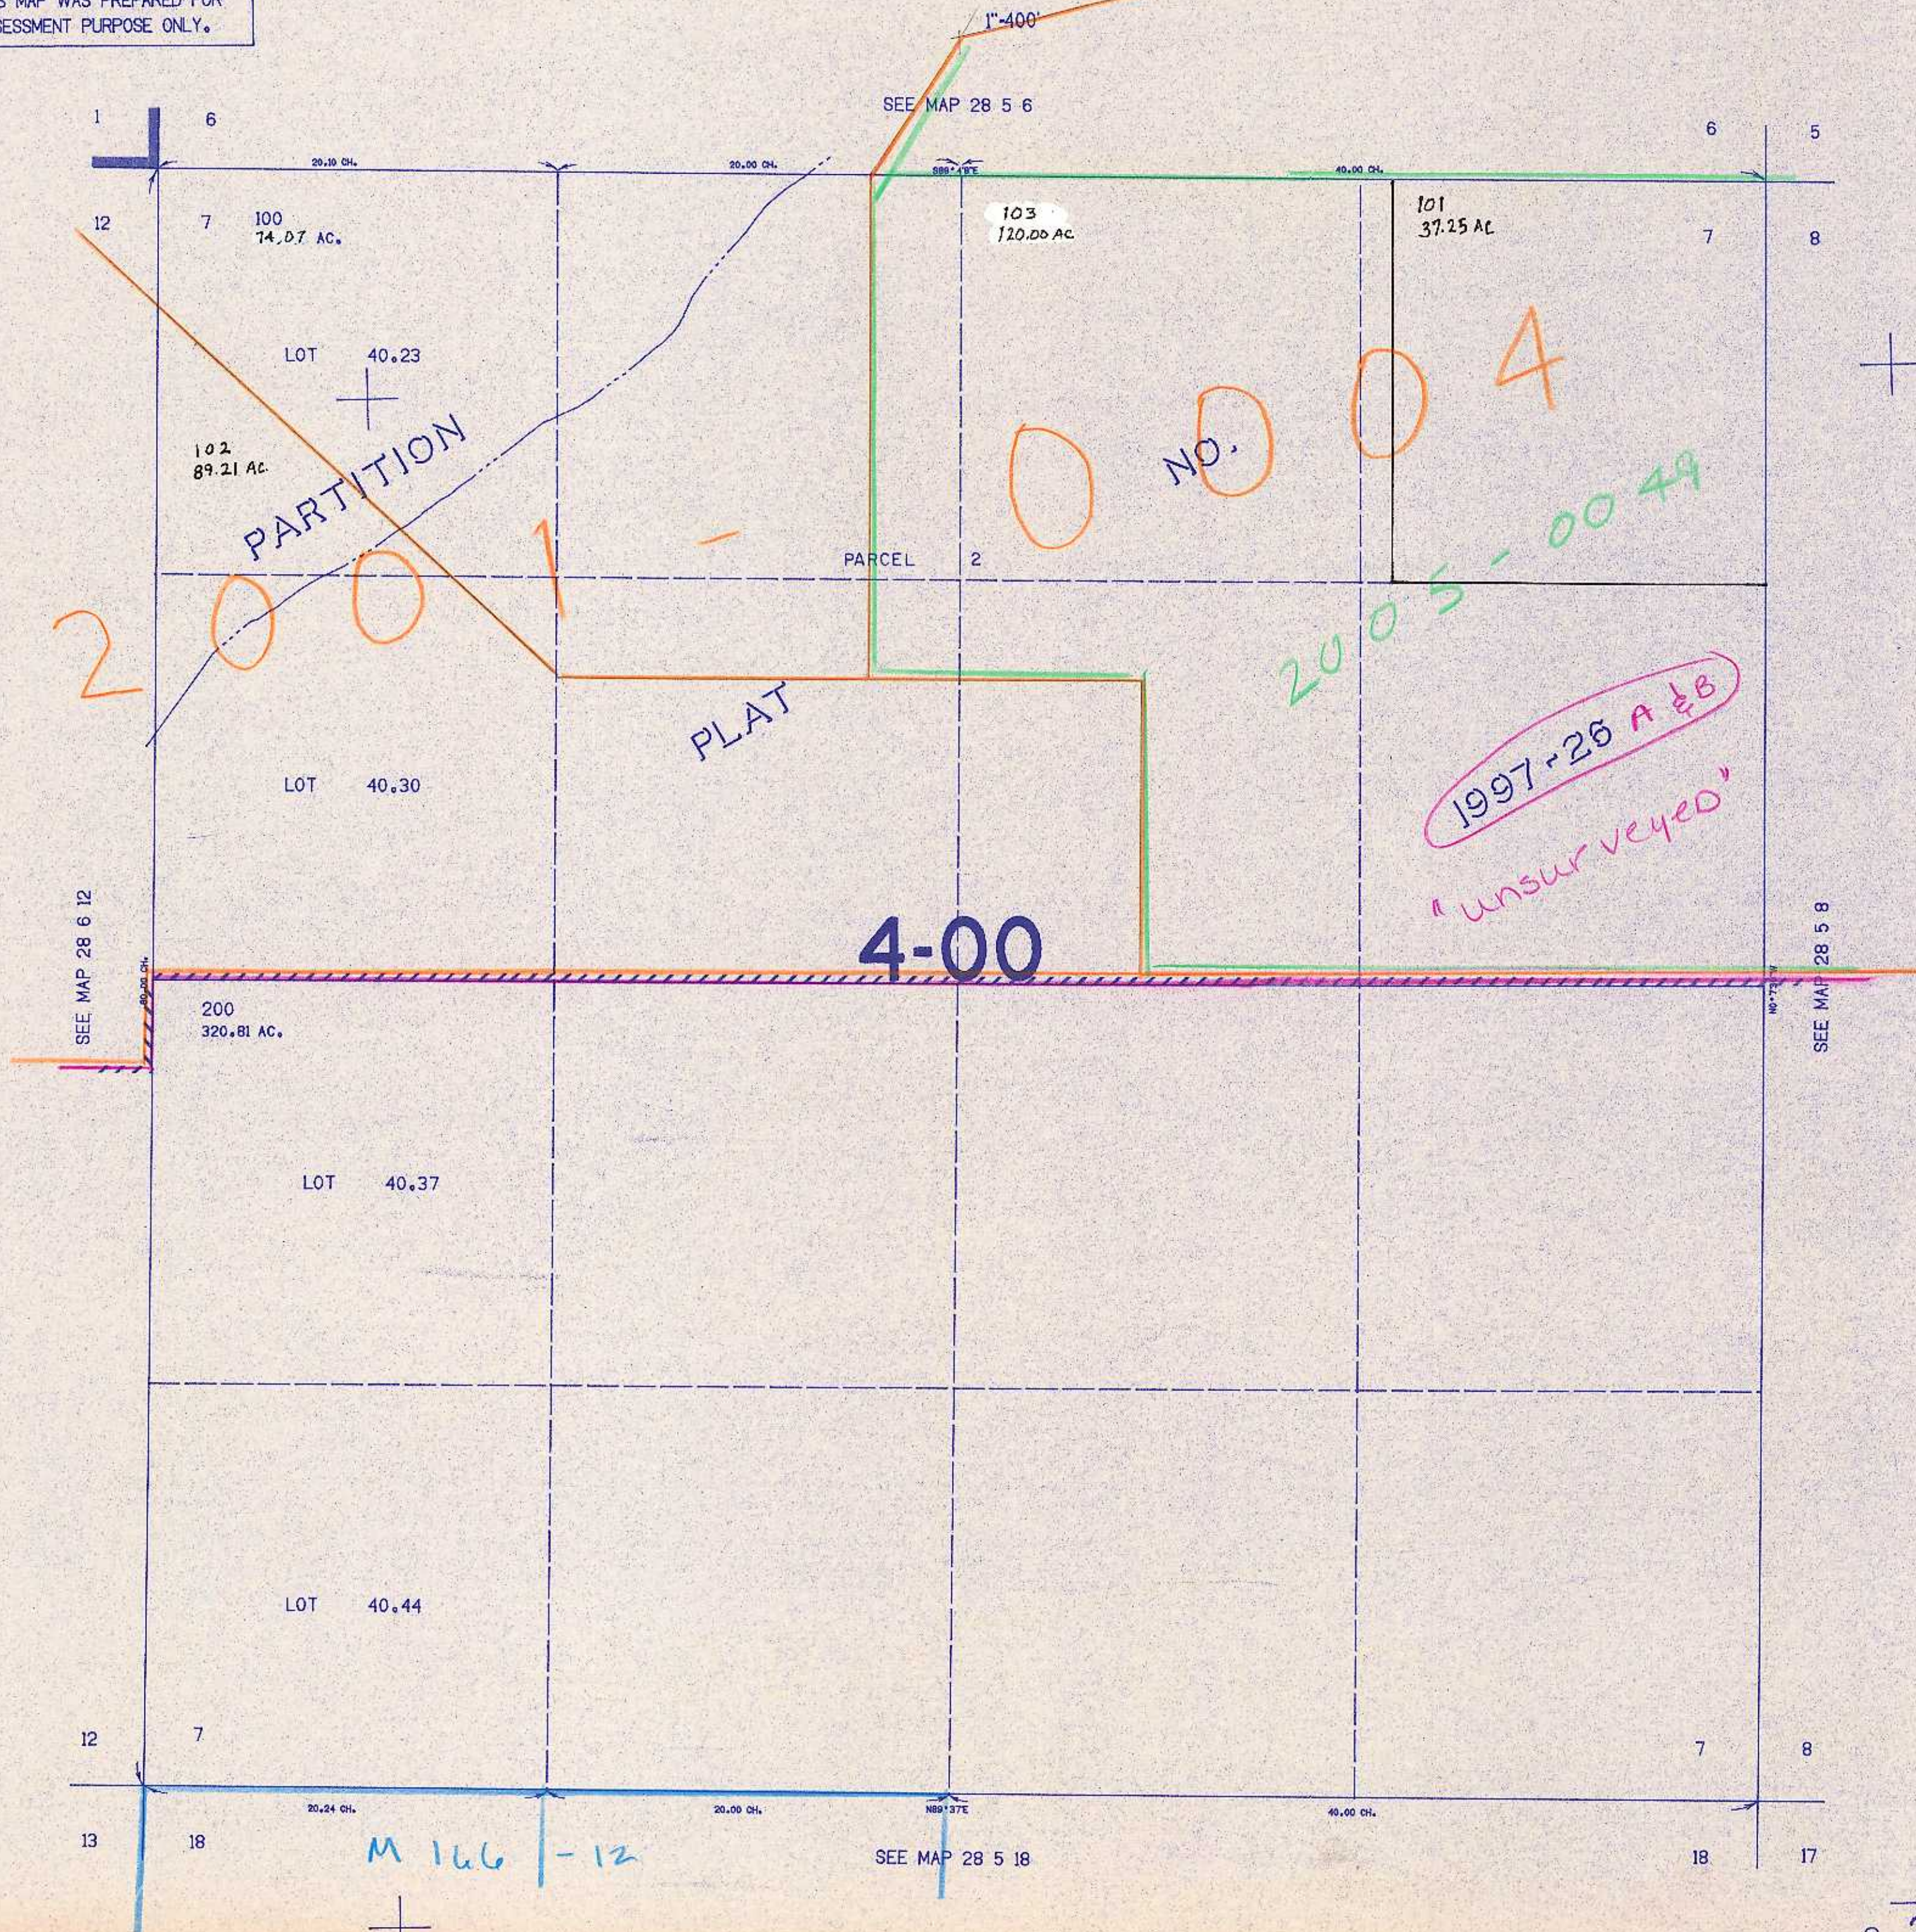

1247,000
555,000
28 5 7
JF 0197
BC