

SECTION 27 T.28S. R.5W. W.M.
DOUGLAS COUNTY

28 5 27


THIS MAP WAS PREPARED FOR
ASSESSMENT PURPOSE ONLY.

1"=400'

SEE MAP 28 5 22

M126-10
M136-68

1991 - 0011

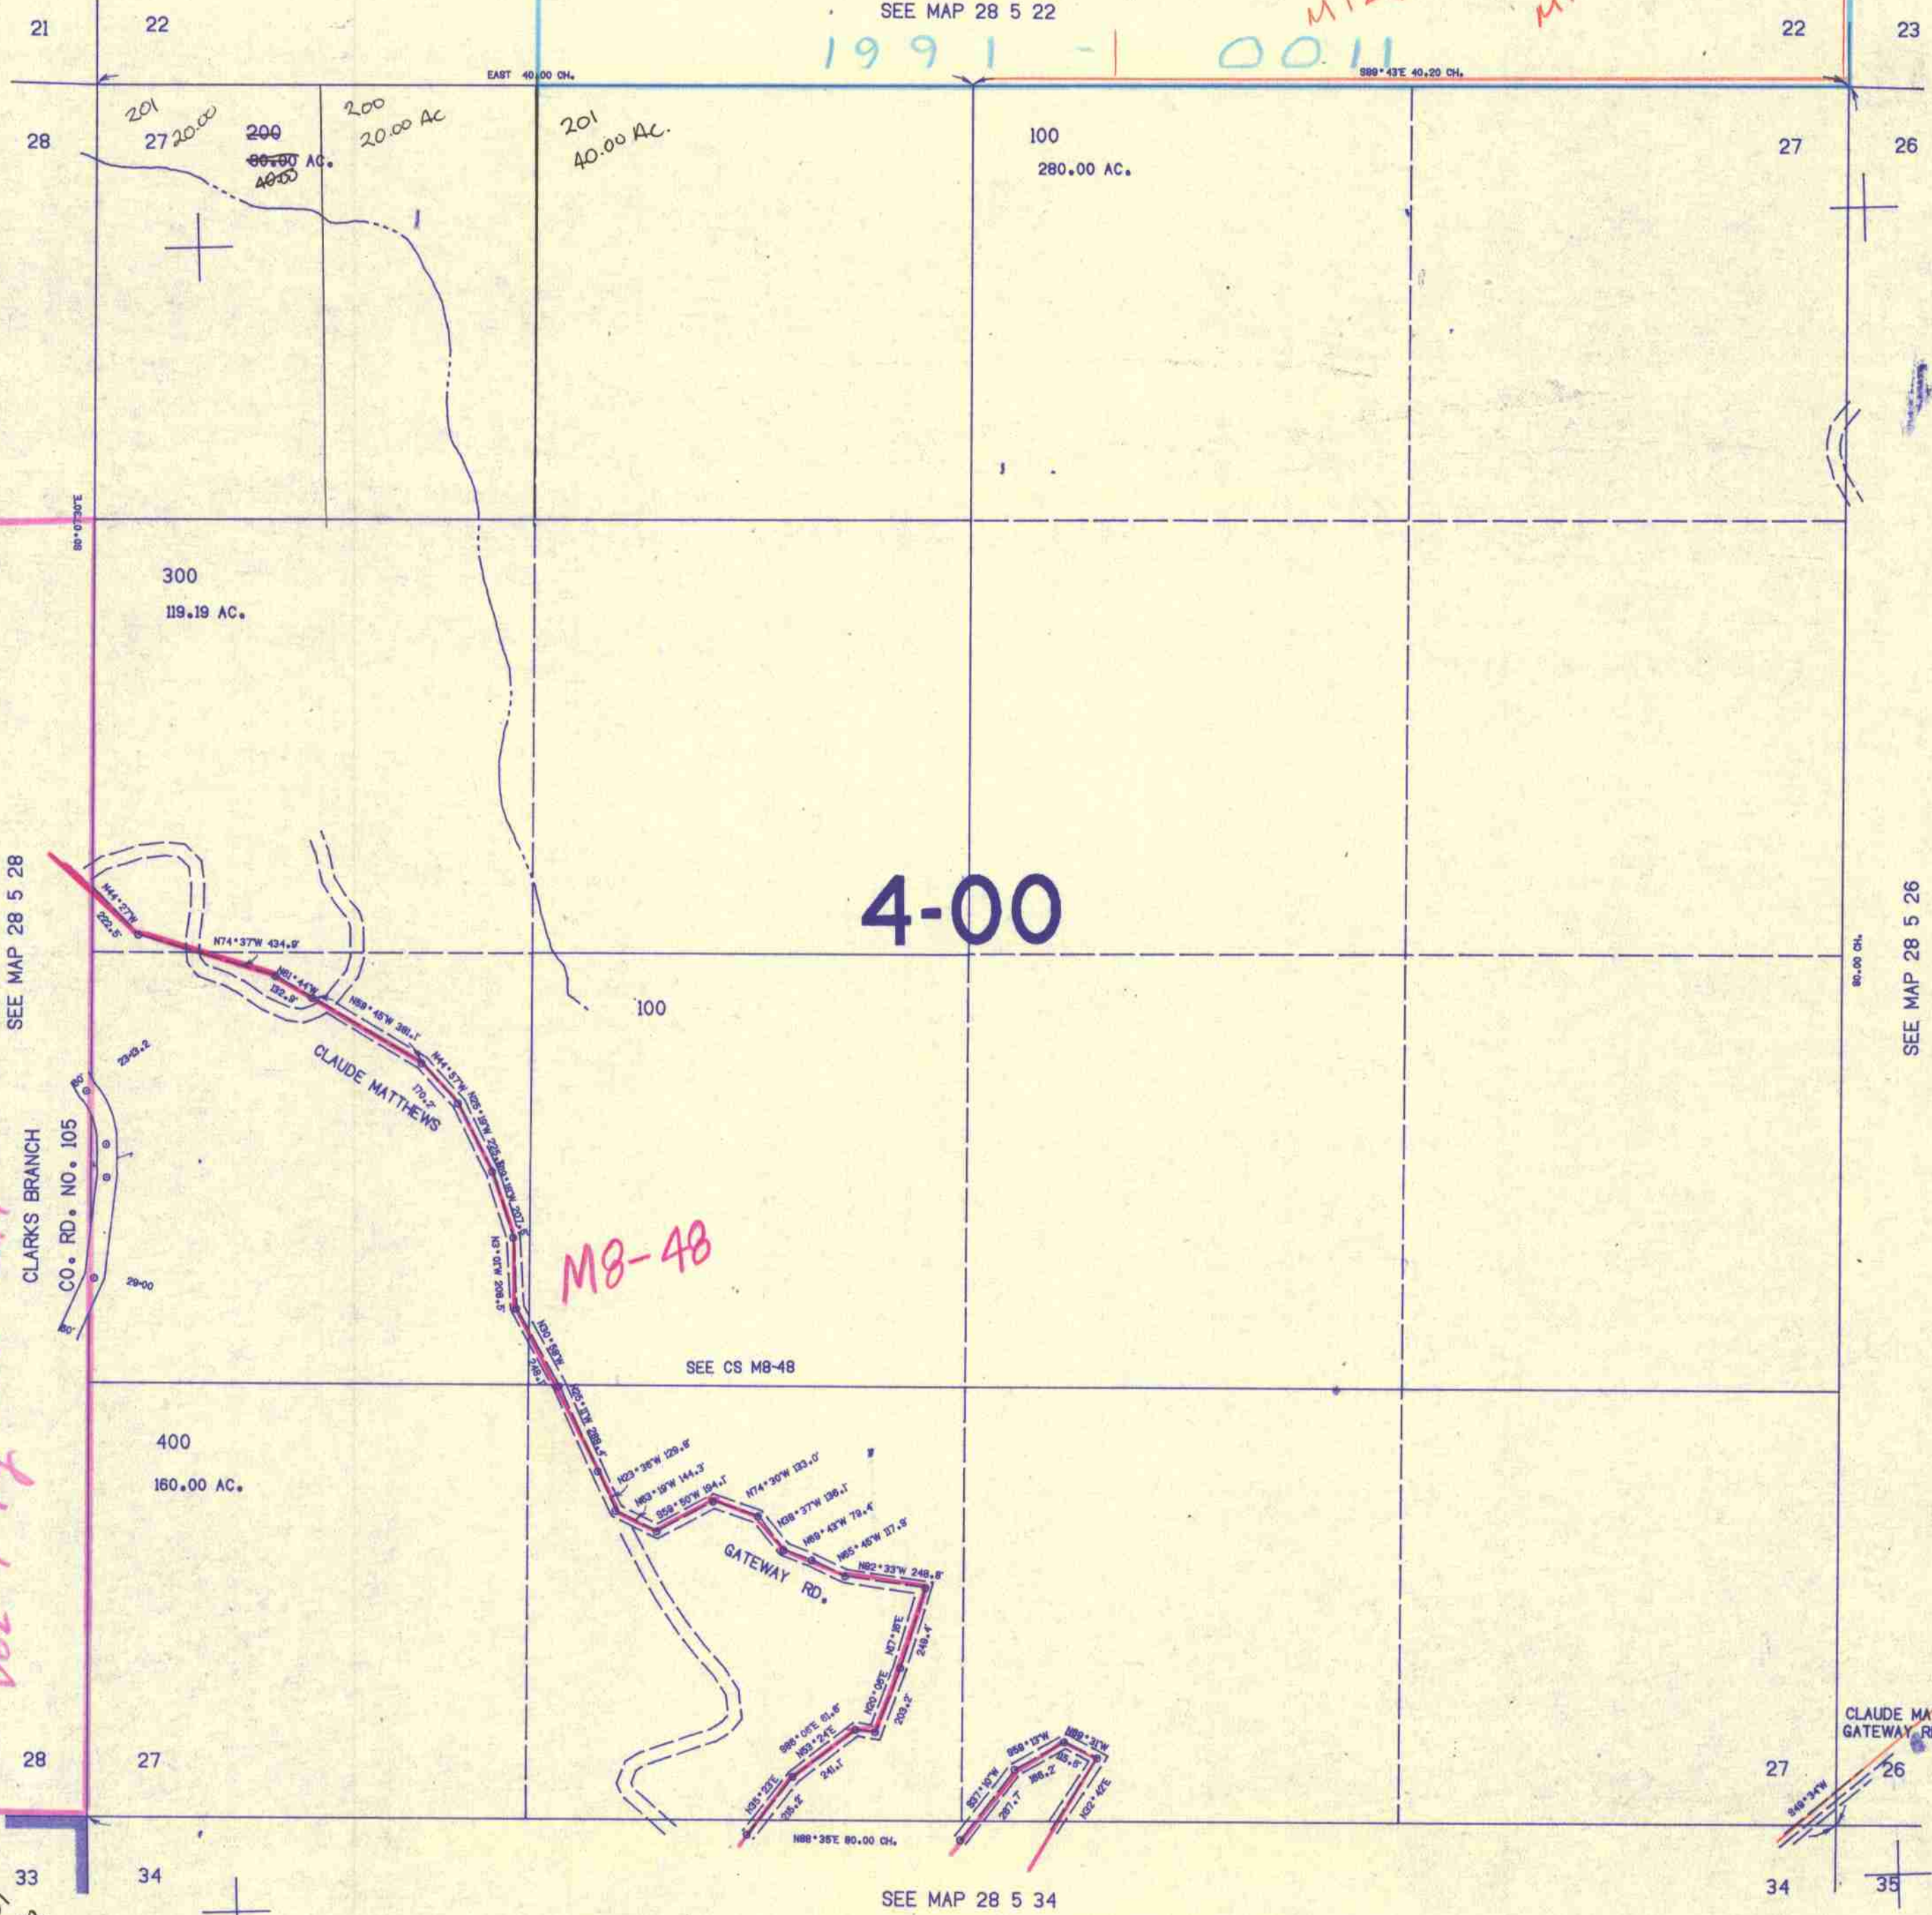

SEE MAP 28 5 28

Vol 1 Pg 239-241

M 61-80
M 61-67
M 61-52

4-00

M8-48

SEE CS M8-48

SEE MAP 28 5 26

SEE MAP 28 5 34

534.000

28 5 27

1.262.000

5/85
CNO