SECTION 30 T.28S. R.5W. W.M.
DOUGLAS COUNTY

THIS MAP WAS PREPARED FOR ASSESSMENT PURPOSE ONLY.

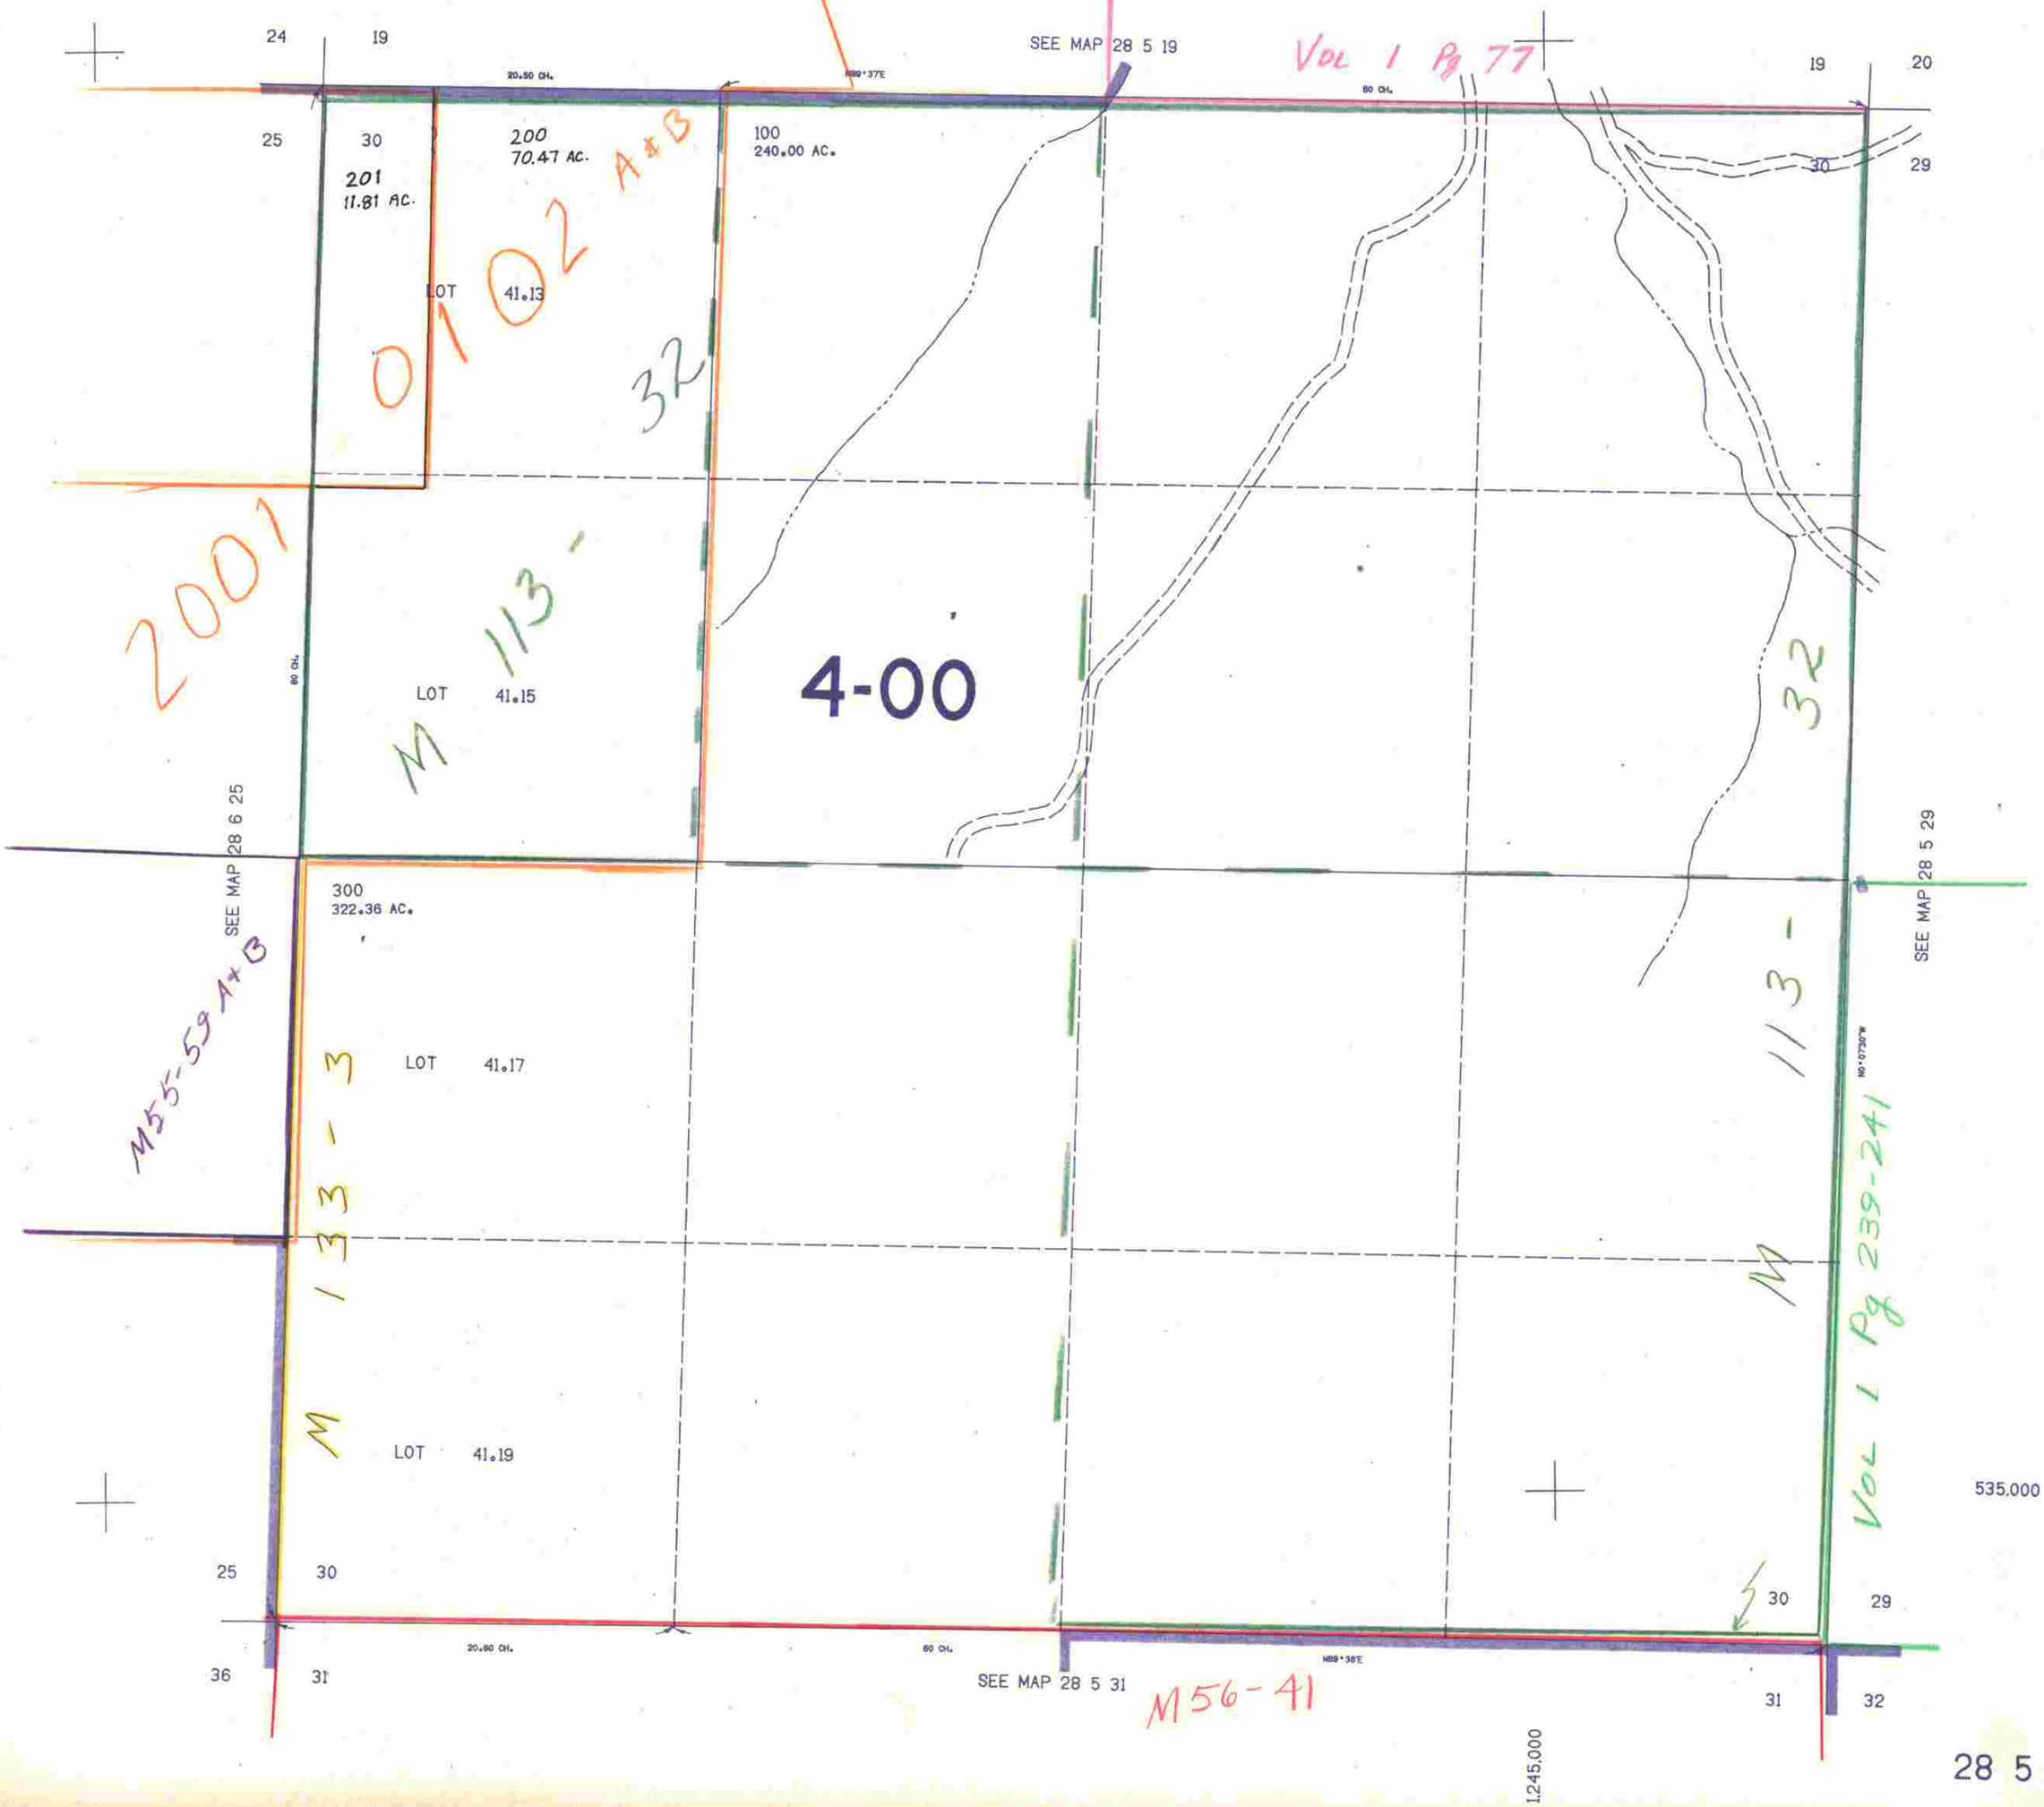

5185 CMO