SECTION 32 T.28S. R.6W. W.M.
DOUGLAS COUNTY

1"-400'

REVISED ON 9-22-95

28 6 32 & INDEX

THIS MAP WAS PREPARED FOR ASSESSMENT PURPOSE ONLY.

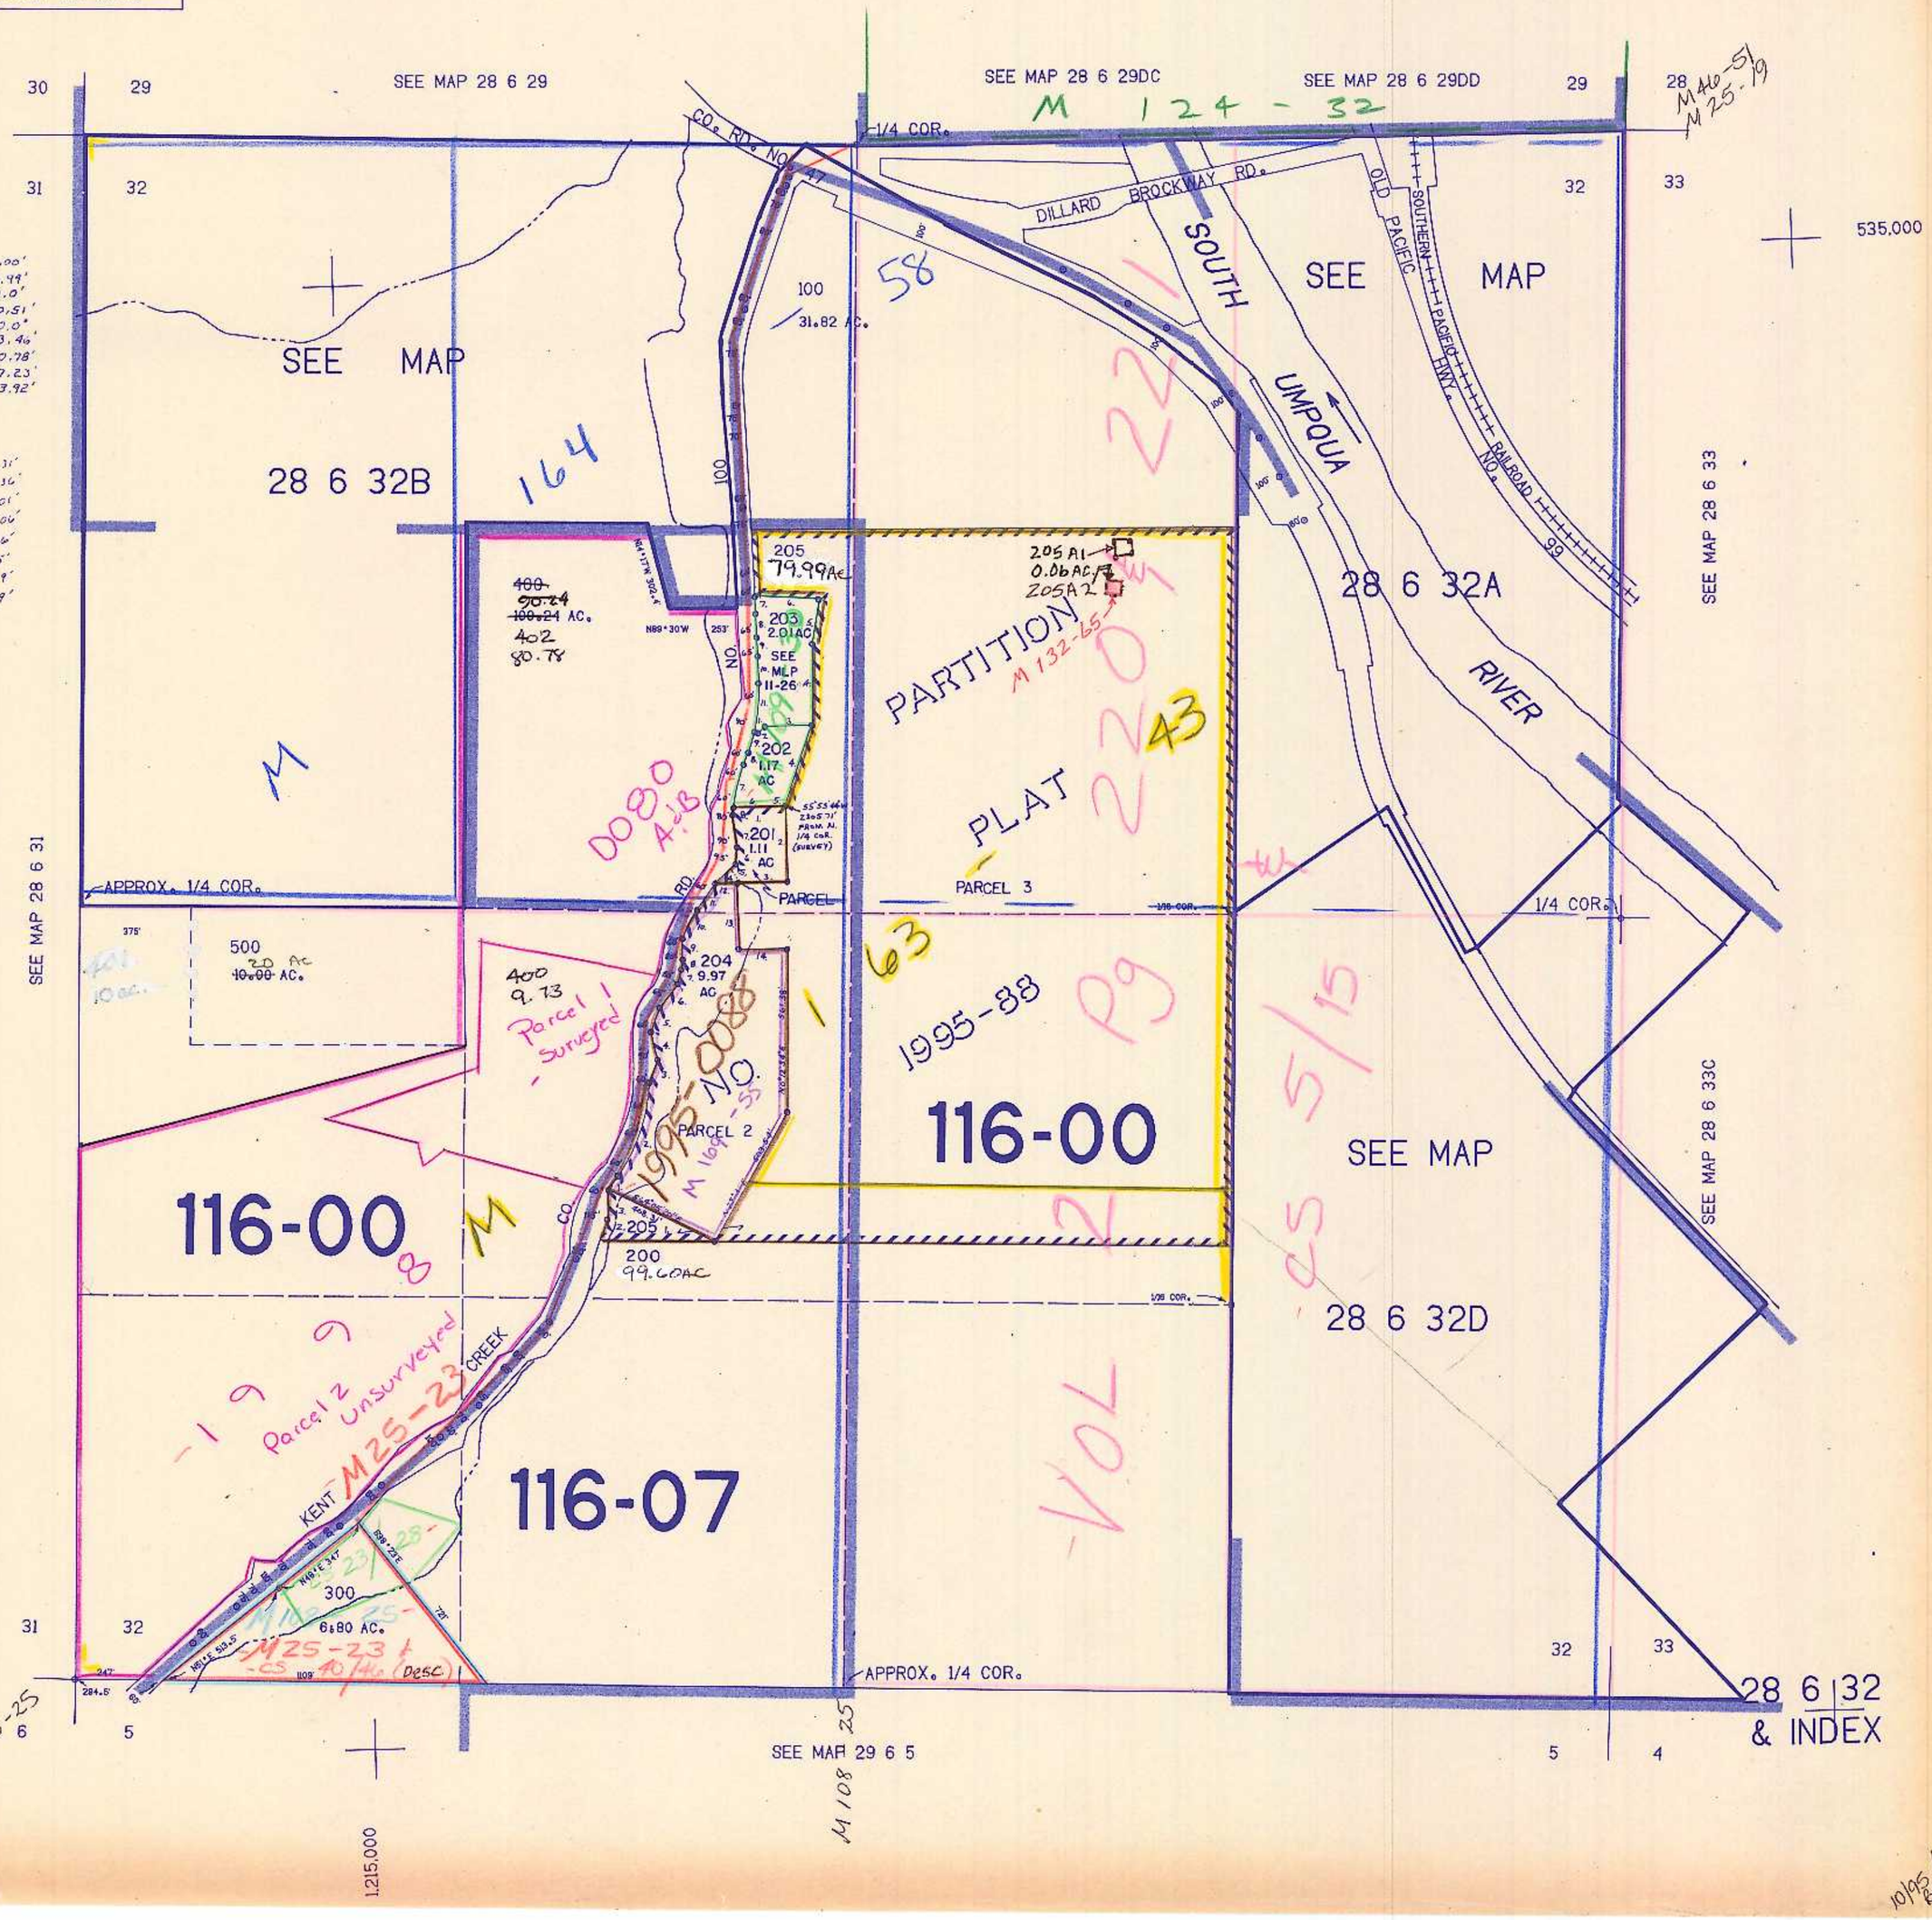

PARCEL 202

1. S 65°00'30"E	15.00'
2. N 43°17'30"S	32.49'
3. EAST	170.0'
4. S 80°37'10"W	280.51'
5. S 88°16'50"W	50.0'
6. S 88°16'50"W	133.46'
7. LC=N14°42'45"E	150.78'
8. N 21°49'12"E	47.23'
9. N 18°22'04"E	63.92'

PARCEL 203

1,2,3. SAME AS ABOVE

4. N 0°33'43"W.	278.31'
5. N 10°10'54"E.	157.36'
6. N 87°01'14"W.	225.01'
7. S 0°53'00"E.	55.06'
8. S 4°24'56"E.	81.06'
9. S 2°13'35"E.	67.35'
10. S 0°13'42"E.	90.59'
11. S 5°38'17"W.	169.59'

PARCEL 201

1. S86°16'50"W	183.52'
2. N1°43'10"W	257.68'
3. N88°16'50"W	174.74'
4. N88°16'50"W	77'
5. S47°11'39"W	95.14'
6. S6°33'39"W	60.54'
7. S7°30'50"E	114.06'
8. S6°35'W	22.46'

PARCEL 205

1. N87°53'45"E	394.88'
2. S21°29'41"W	79.62'
3. S0°51'11"E	105.07'

PARCEL 204

1. S38°28'28"W	56.27'	
2. LC=S19°15'50"W	333.96'	A=340.3'
3. S21°05'51"W	83.5'	
4. S14°38'10"E	98.91'	
5. S20°27'46"W	87.74'	
6. S37°11'12"W	107.24'	
7. S12°25'16"W	47.54'	
8. S7°16'51"W	33.18'	
9. S2°10'47"E	72.8'	
10. LC=S25°51'31"W	108.38'	A=108.75'
11. S34°50'02"W	108.02'	
12. N88°16'50"E	77'	
13. N1°43'10"W	22.5'	
14. S88°16'50"W	167.16'	

10/95 AP BC