

SW1/4 NE1/4 SEC. 2 T.28S. R.6W. W.M.
DOUGLAS COUNTY


28 6 2AC

THIS MAP WAS PREPARED FOR
ASSESSMENT PURPOSE ONLY.

SEE MAP 28 6 2

1"=100'

Cancelled
301
700
401
1001

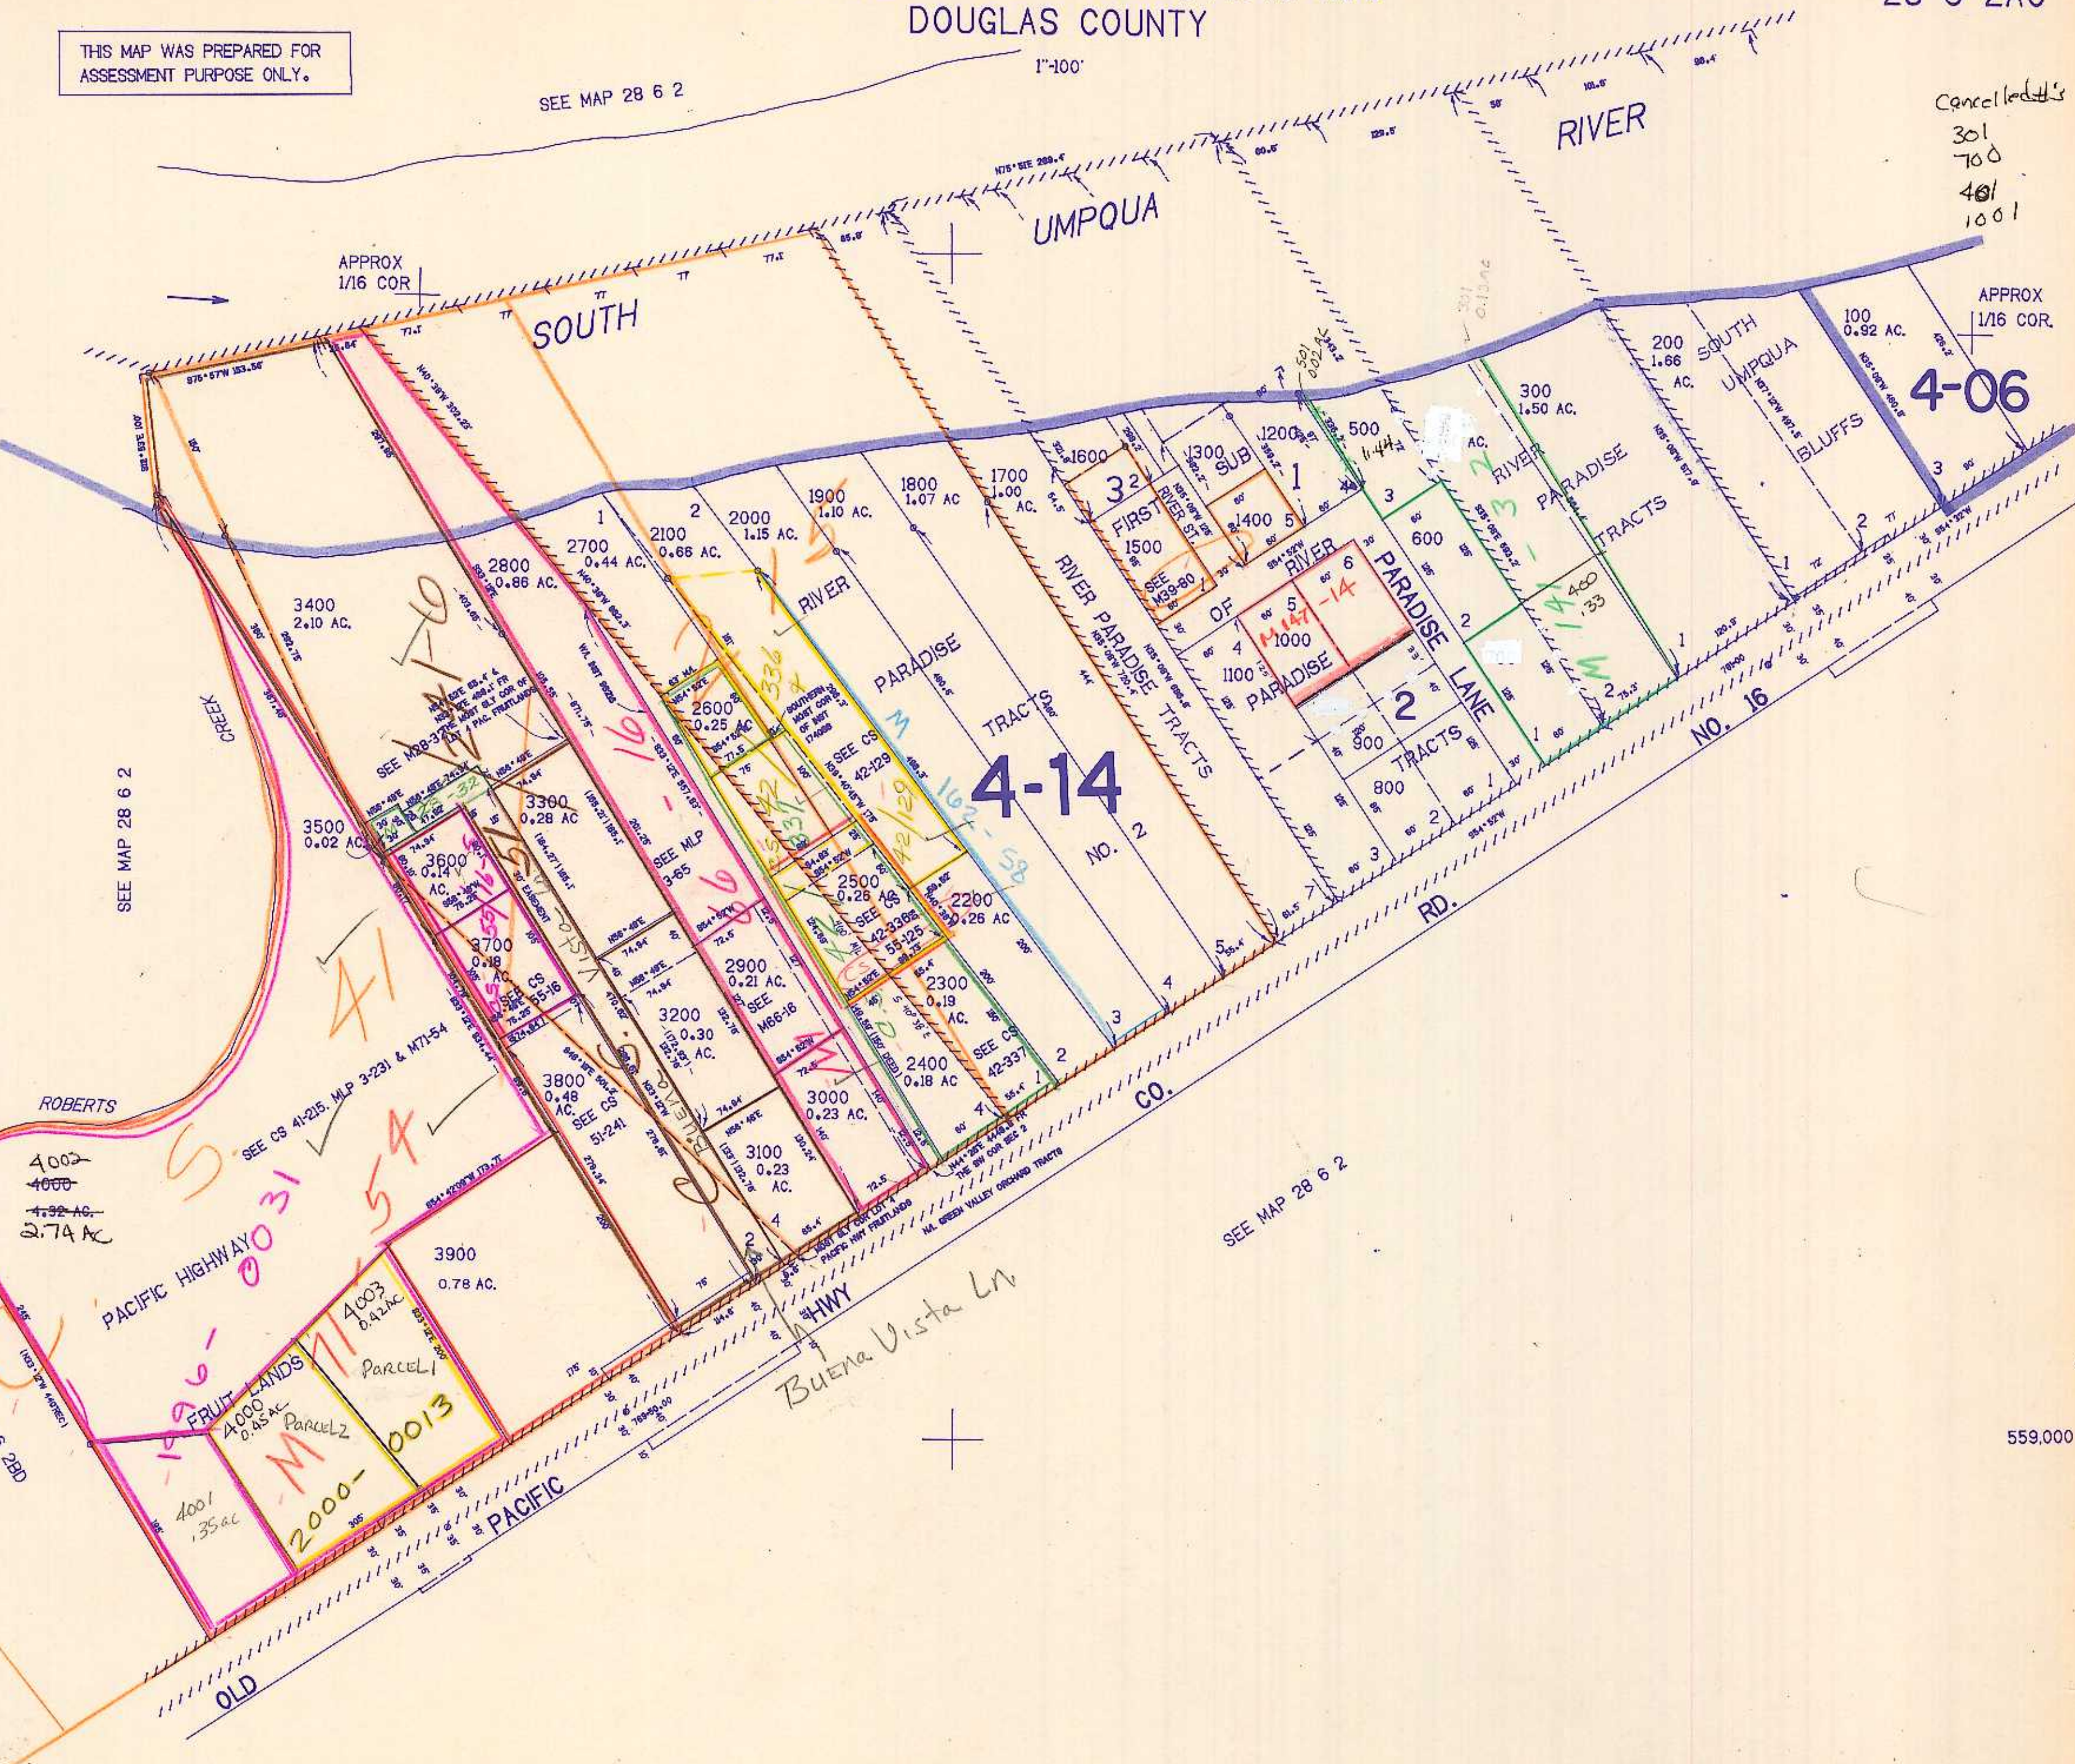

4-06

4-14

4002
4000
4.92 AC.
2.74 AC.

FRUIT LANDS
Parcel 1
Parcel 2
2000-0013

Buena Vista Ln

APPROX
GEN. SEC.

APPROX
1/16 COR.

28 6 2AC

559,000

1,234,000

5/10/21