THIS MAP WAS PREPARED FOR ASSESSMENT PURPOSE ONLY.

NE1/4 SE1/4 SEC.2 T.28S. R.6W. W.M.
DOUGLAS COUNTY
1" = 100'

REVISED ON 12-28-05

28 6 2DA

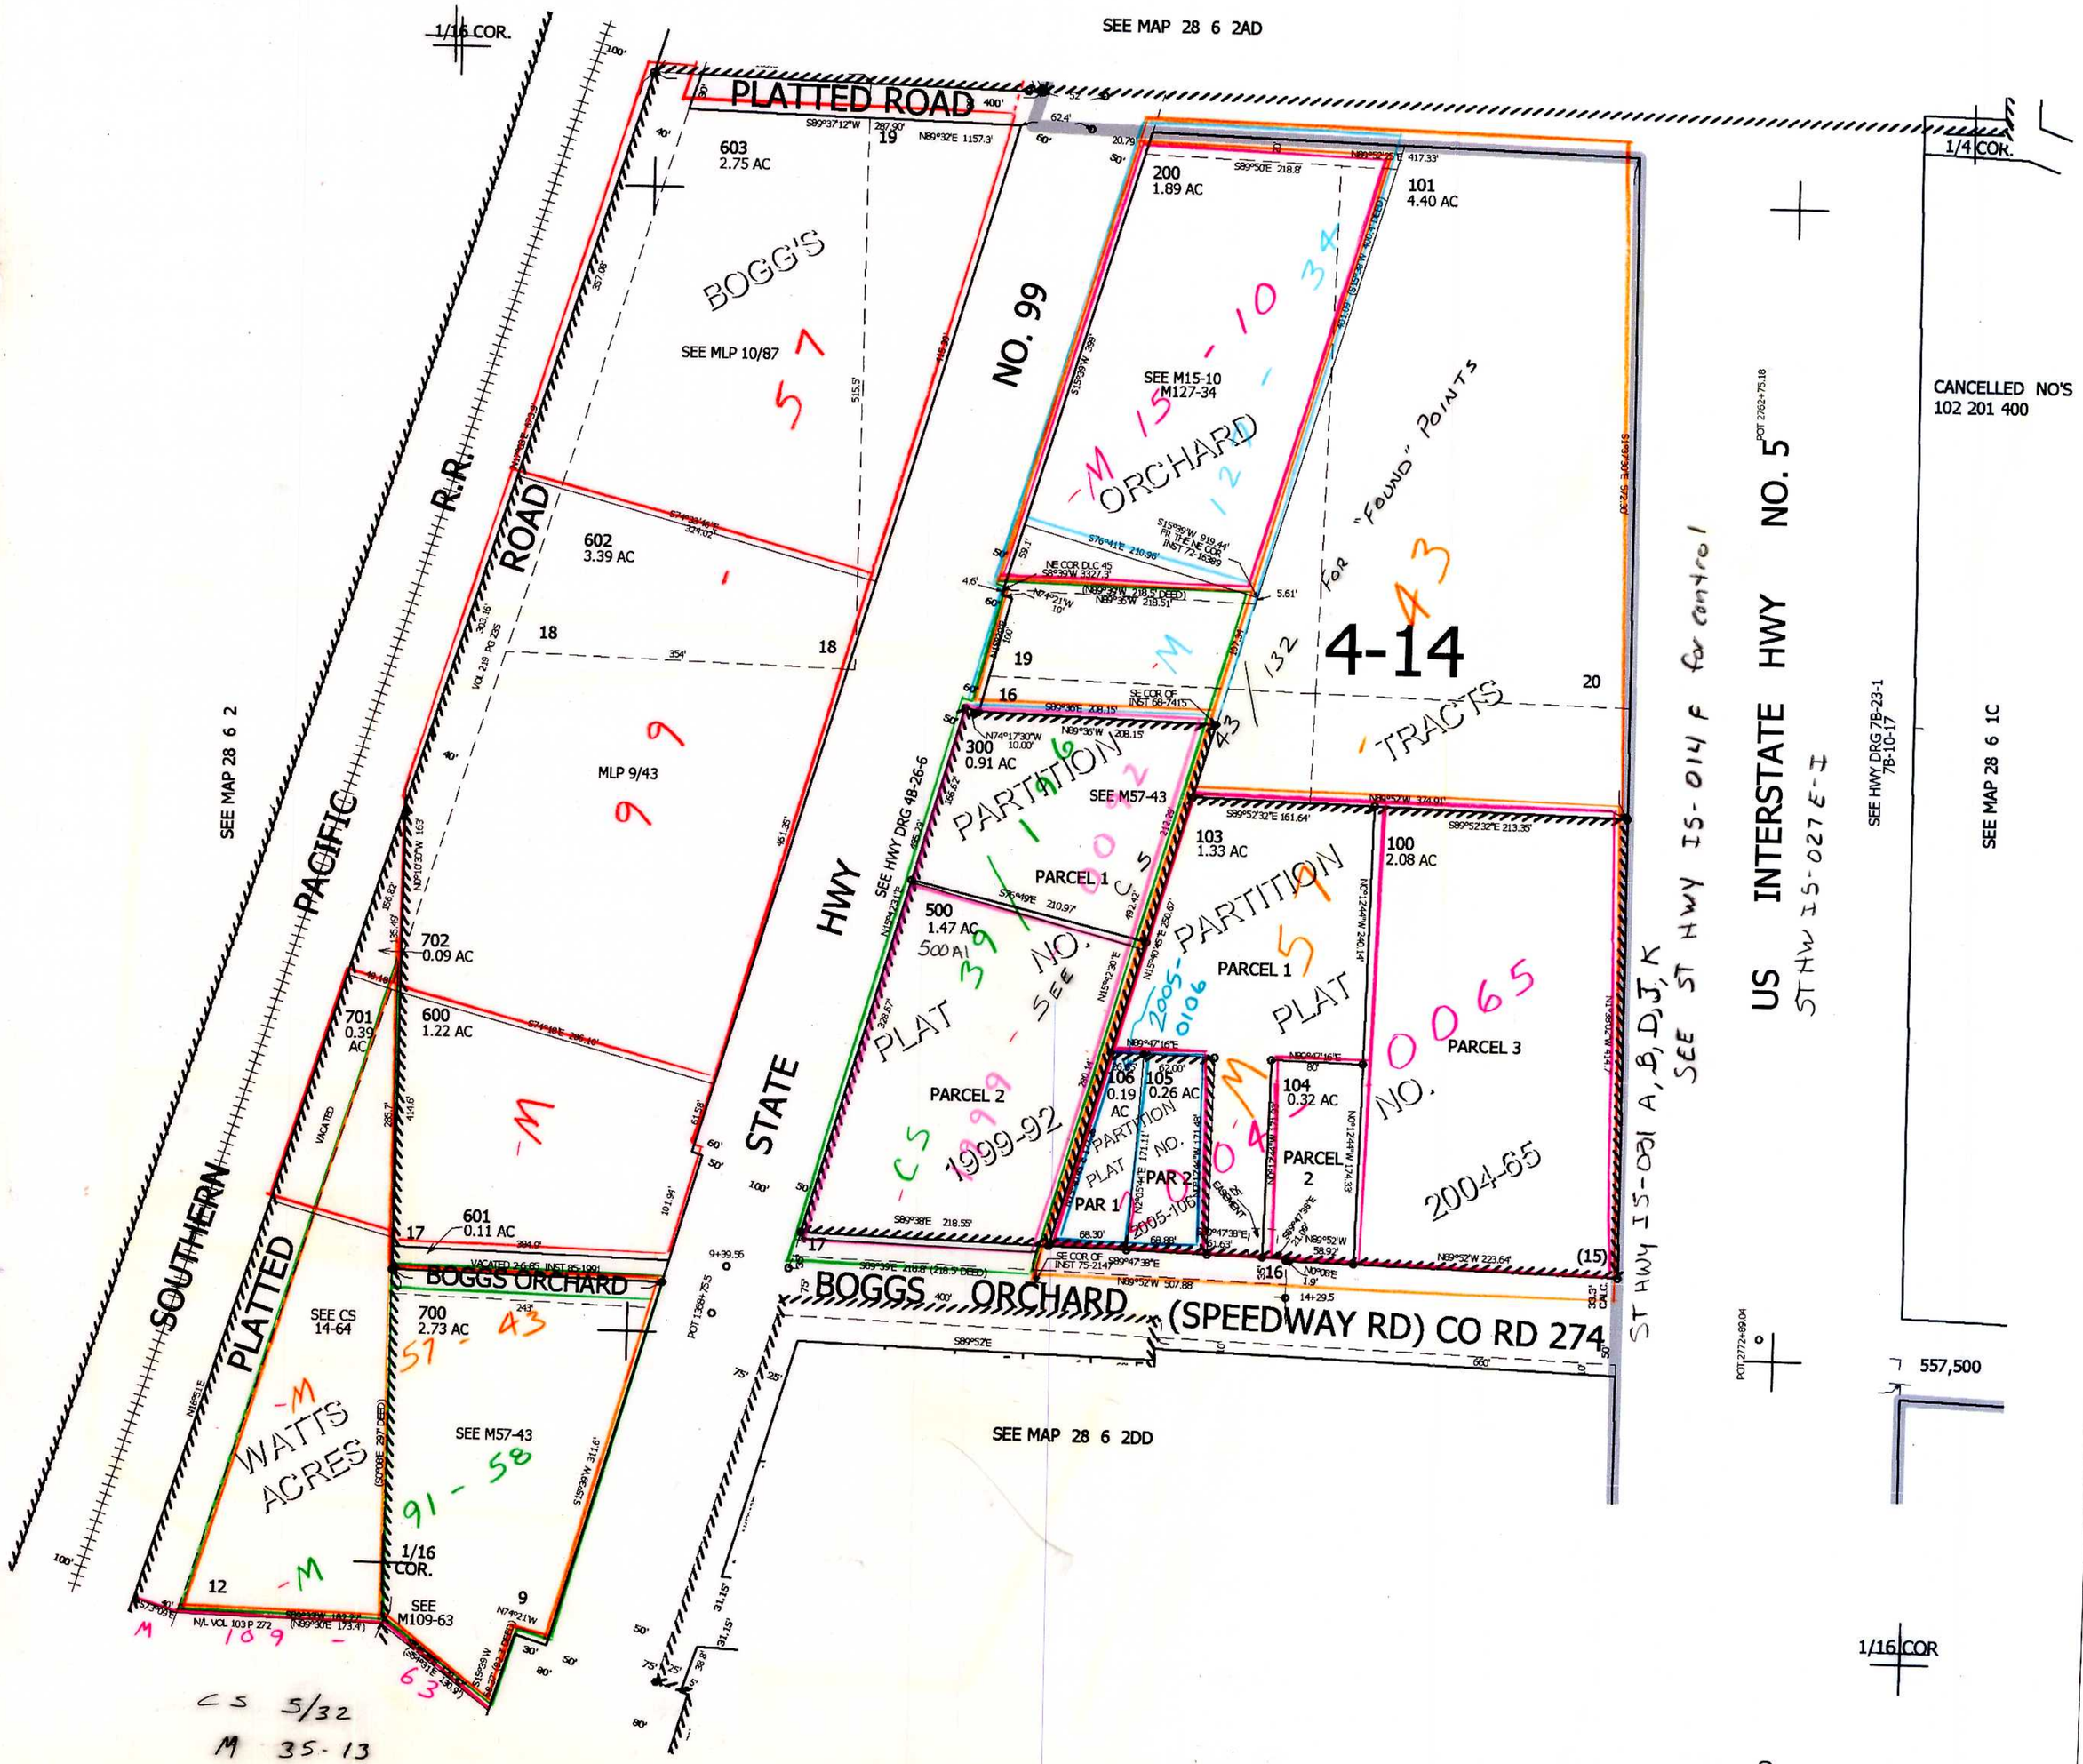

28 6 2DA