THIS MAP WAS PREPARED FOR ASSESSMENT PURPOSE ONLY.

SW1/4 SEC.3 T.28S. R.6W. W.M.
DOUGLAS COUNTY

1" = 200'

REVISED ON 3-12-20

28 6 3C

CANCELLED NO'S
1002 601 1001
1301 1201

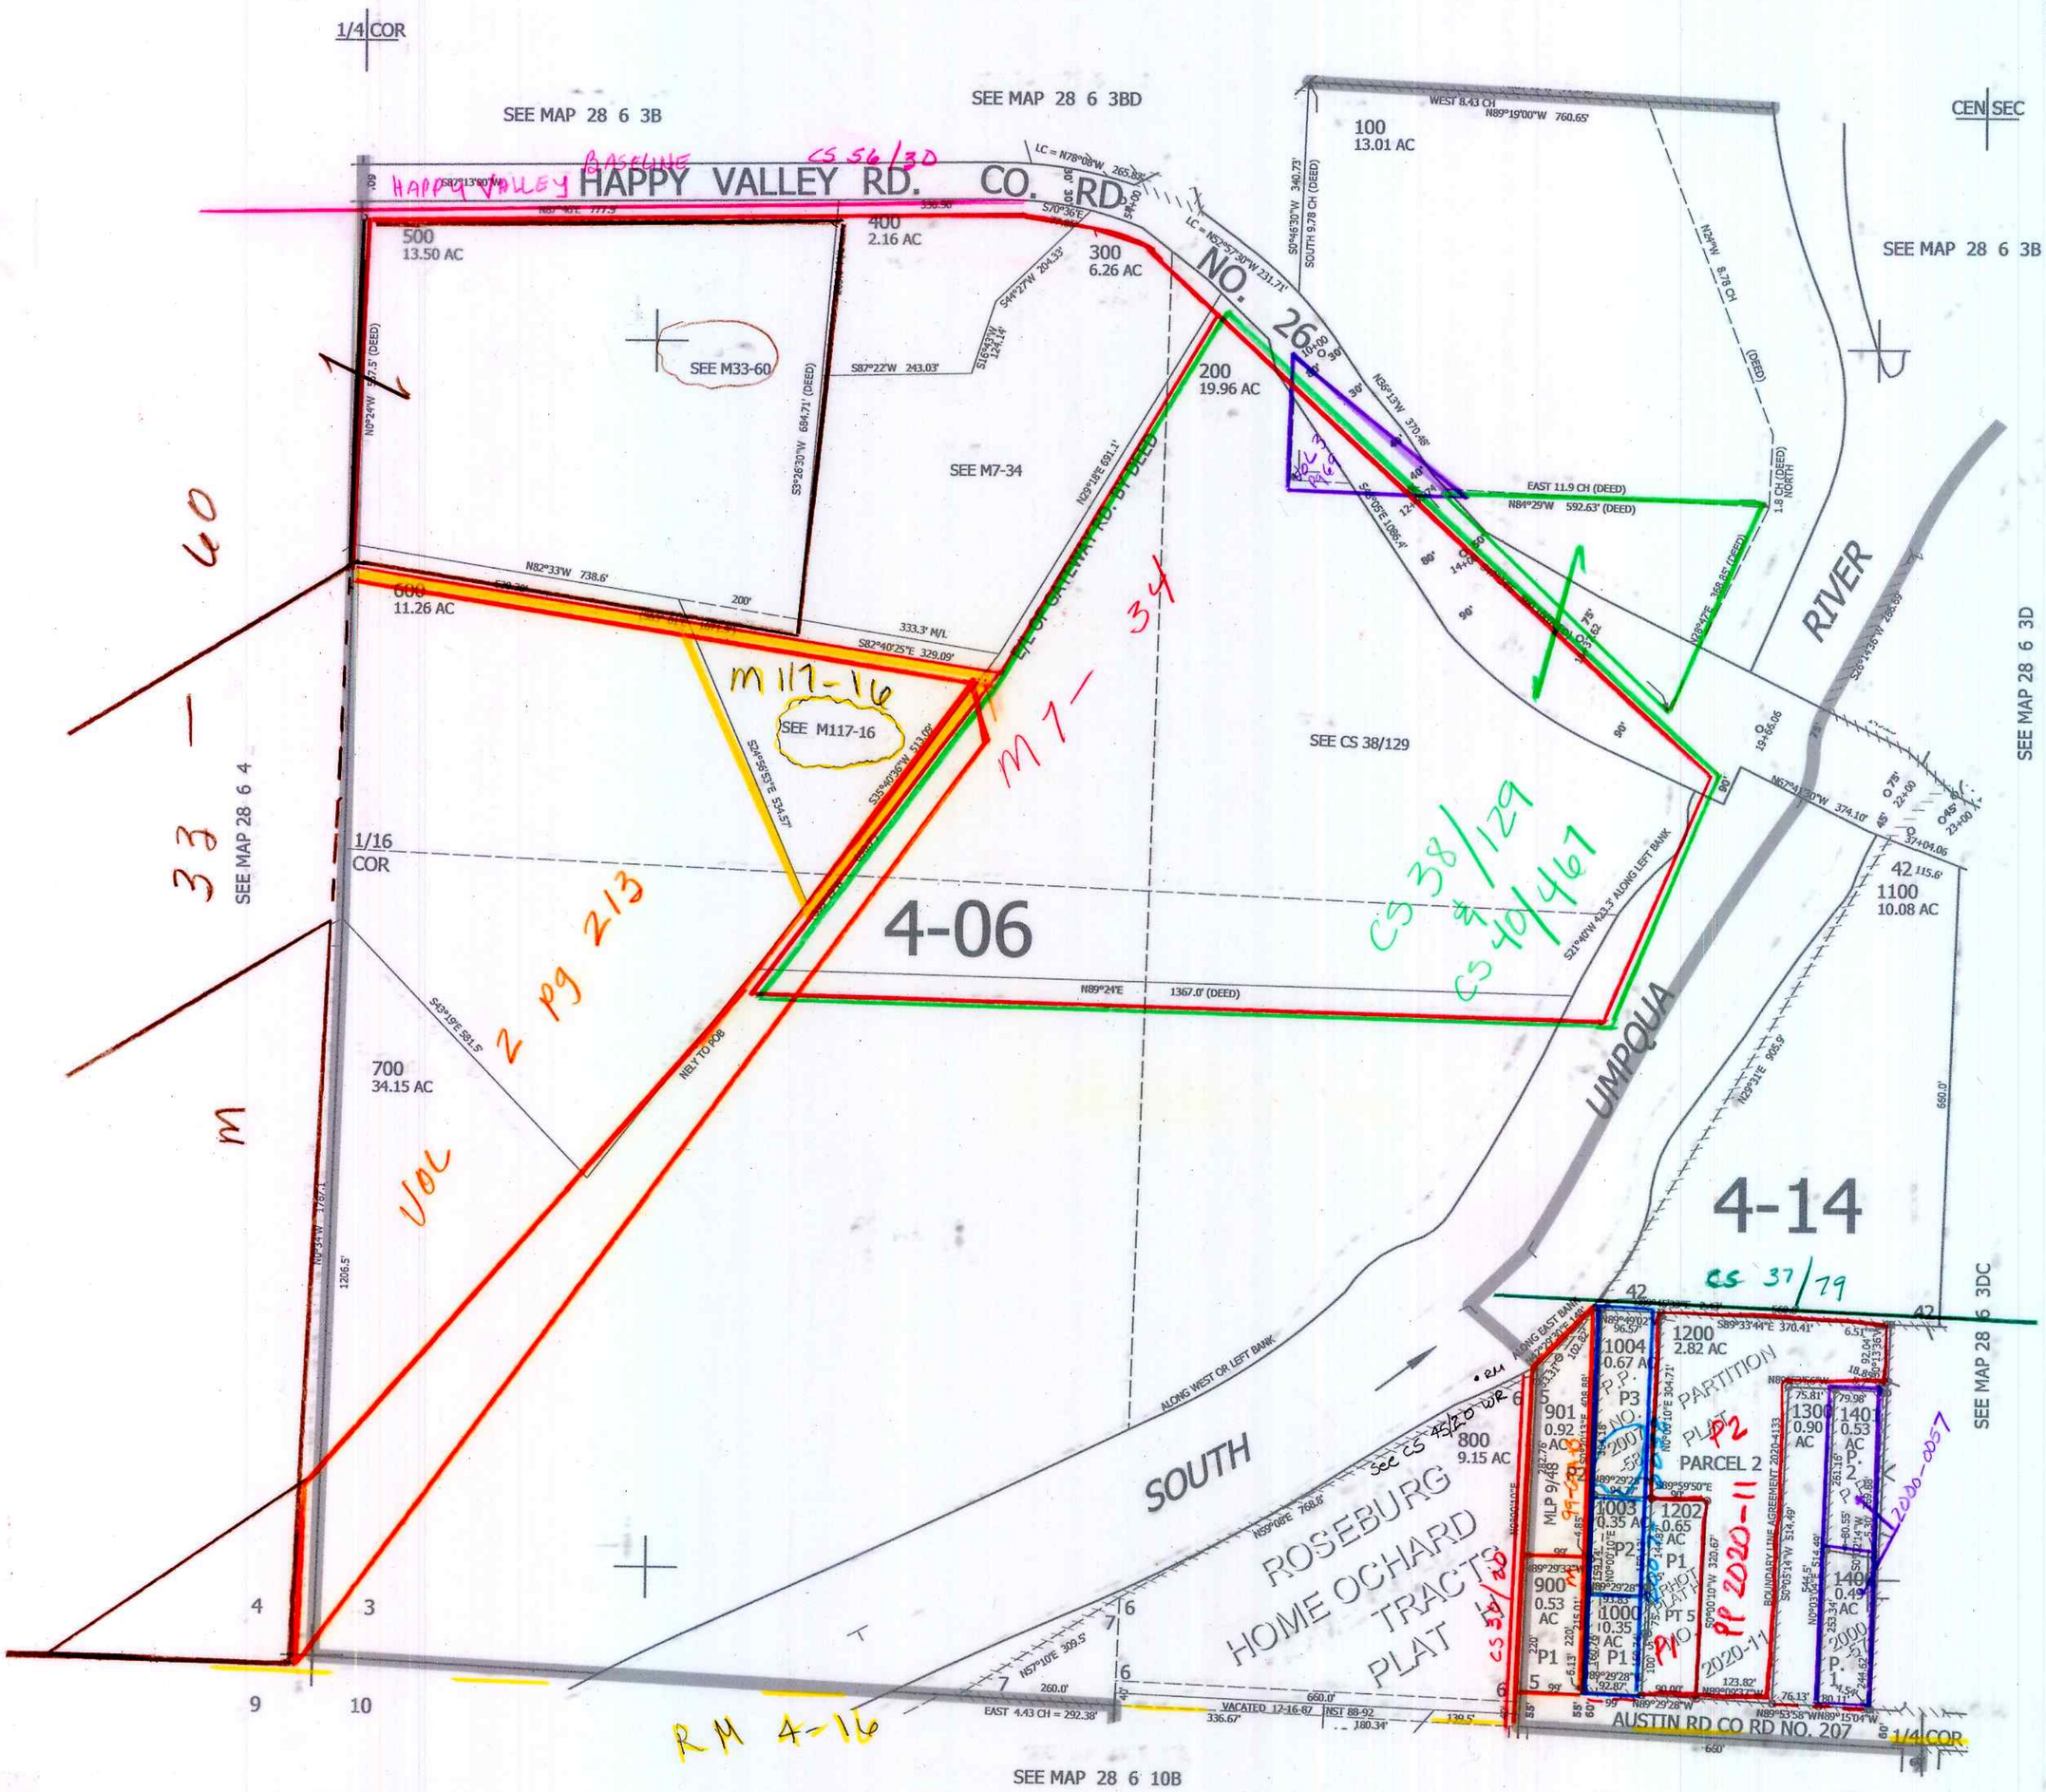

28 6 3C