


THIS MAP WAS PREPARED FOR ASSESSMENT PURPOSE ONLY.

SEC.11 T.28S. R.6W. W.M. DOUGLAS COUNTY

28 6 11 & INDEX

REVISED ON 11-23-09 SEE MAP 28 6 2DD

1" = 400'

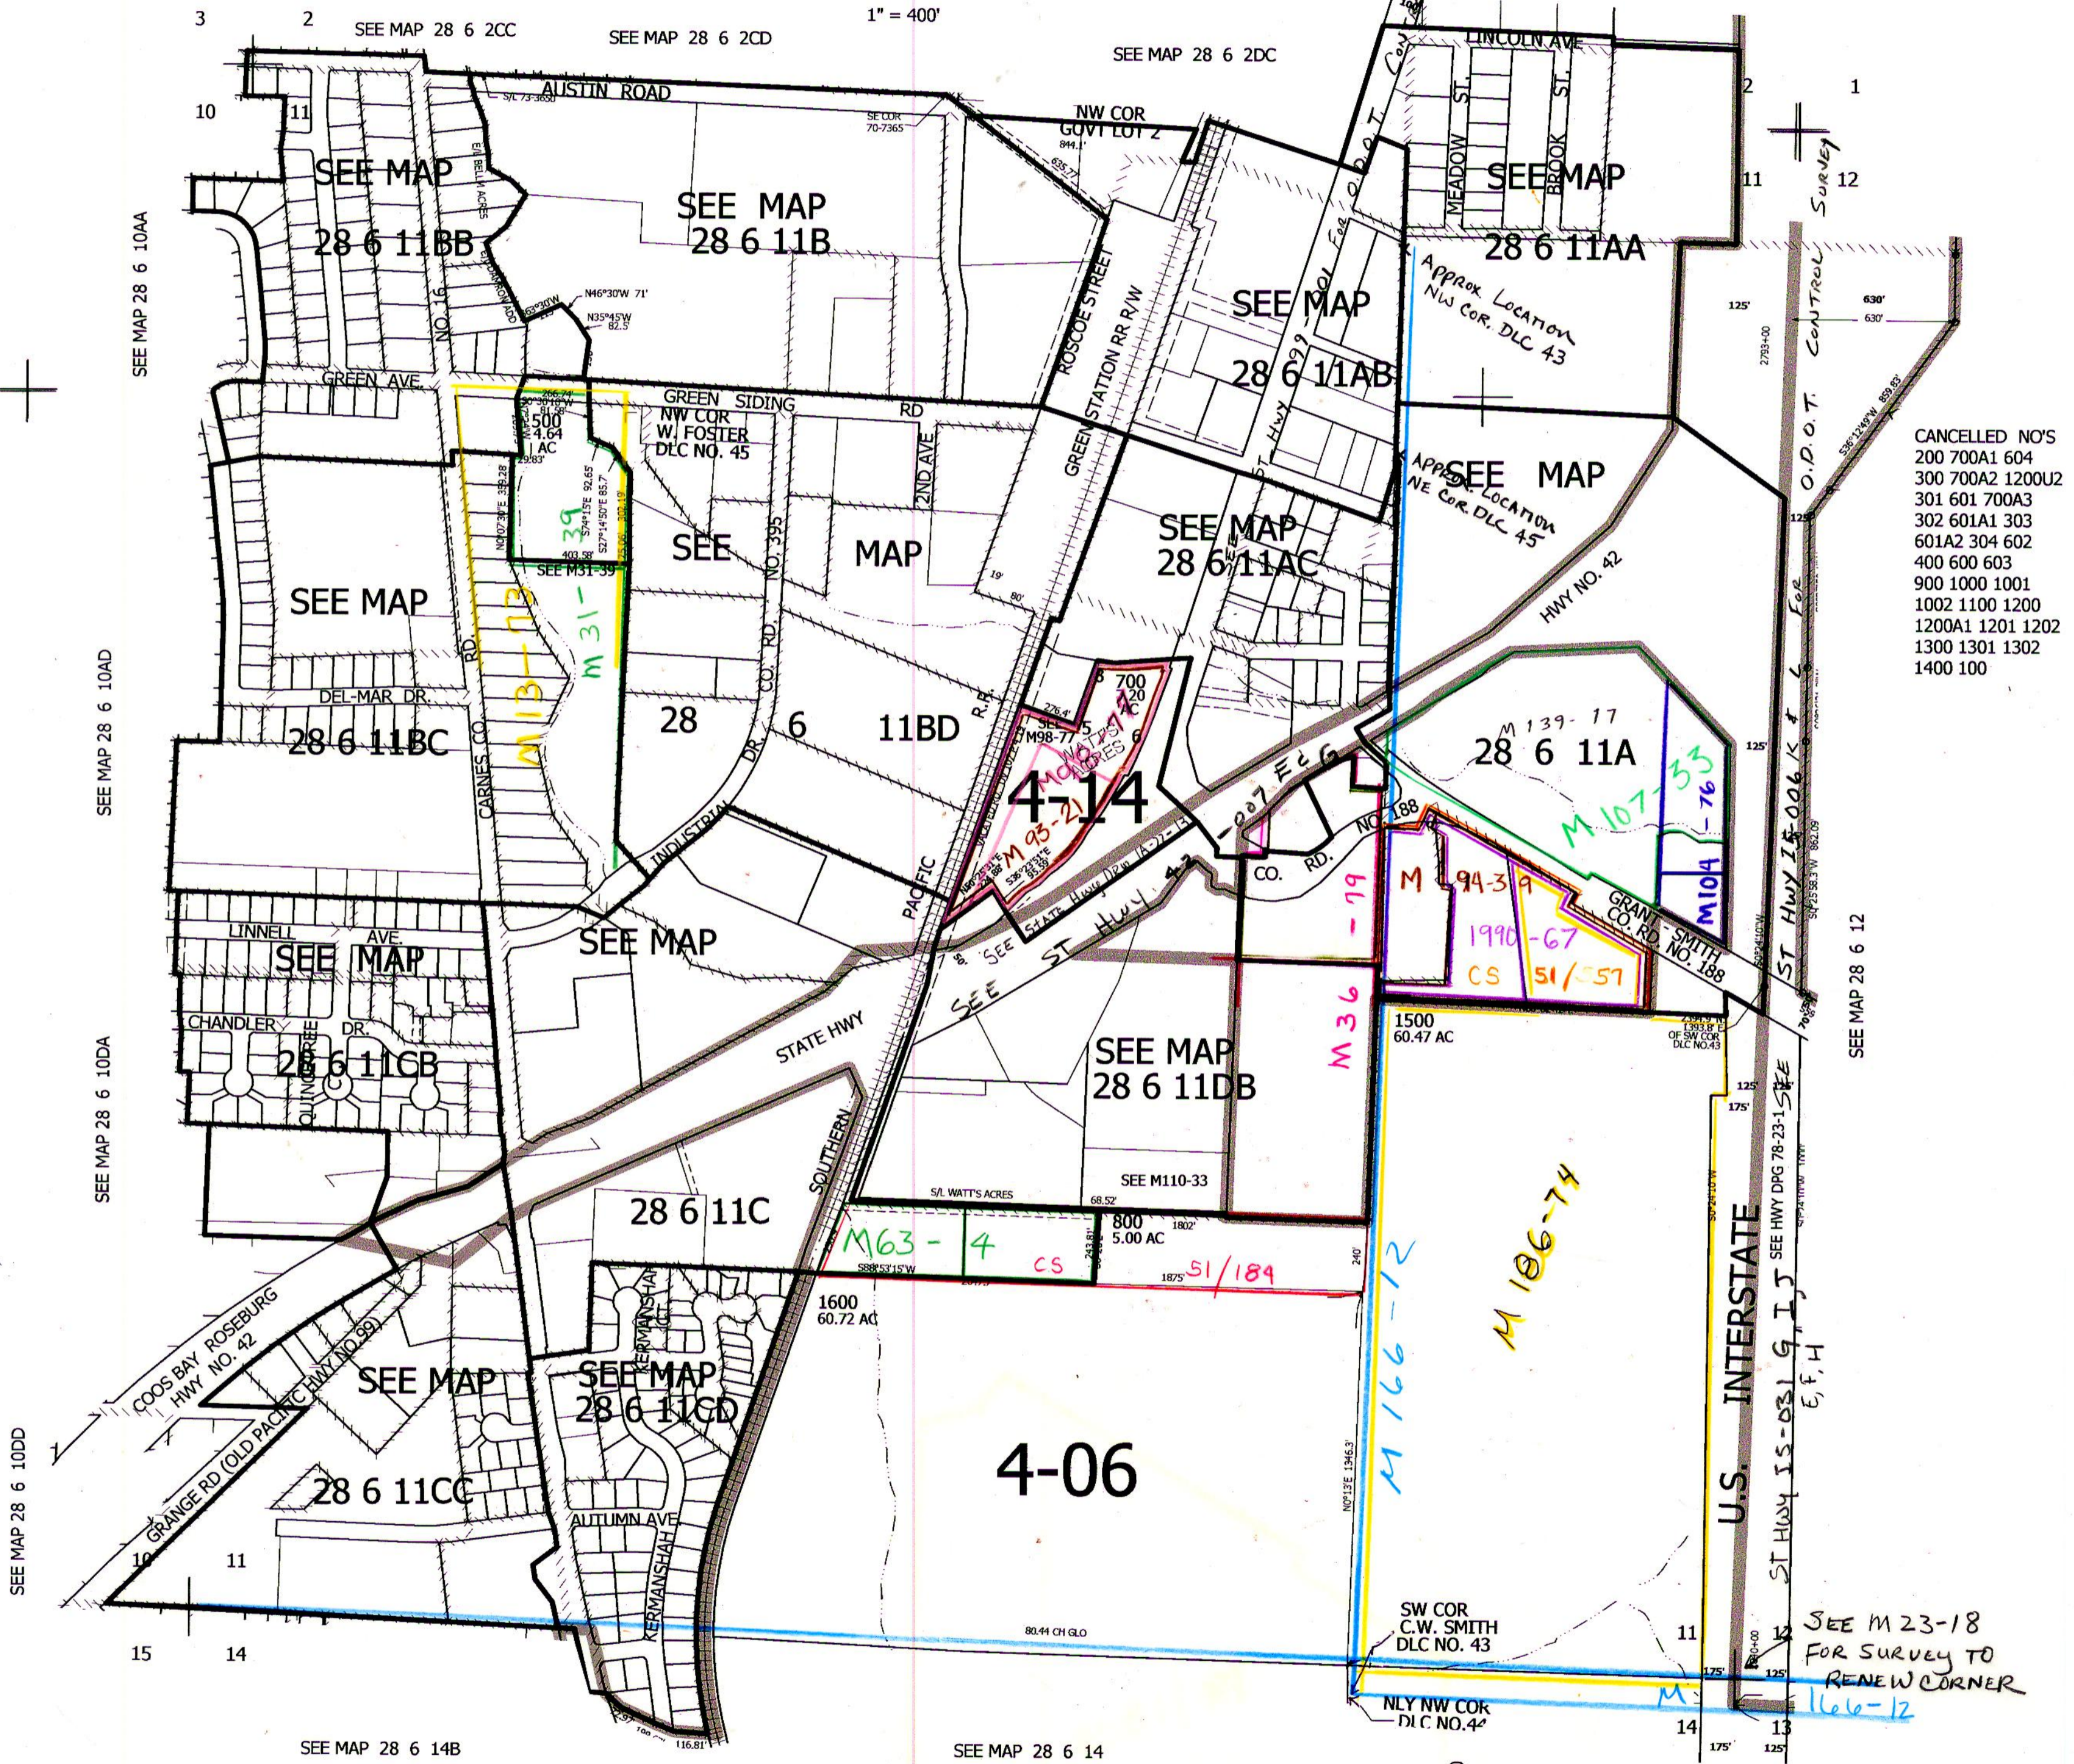

- CANCELLED NO'S
- 200 700A1 604
  - 300 700A2 1200U2
  - 301 601 700A3
  - 302 601A1 303
  - 601A2 304 602
  - 400 600 603
  - 900 1000 1001
  - 1002 1100 1200
  - 1200A1 1201 1202
  - 1300 1301 1302
  - 1400 100

SEE MAP 28 6 12

SEE HWY IS-081 G, I, J SEE HWY DPG 78-23-1 SEE E, F, H

SEE M 23-18 FOR SURVEY TO RENEW CORNER 106-12

28 6 11 & INDEX

4,156,000 550,000

BF nw 3/4