


THIS MAP WAS PREPARED FOR ASSESSMENT PURPOSE ONLY.

SEC.14 T.28S. R.6W. W.M.
DOUGLAS COUNTY

REVISED ON
2-16-07

28 6 14
& INDEX

1" = 400'

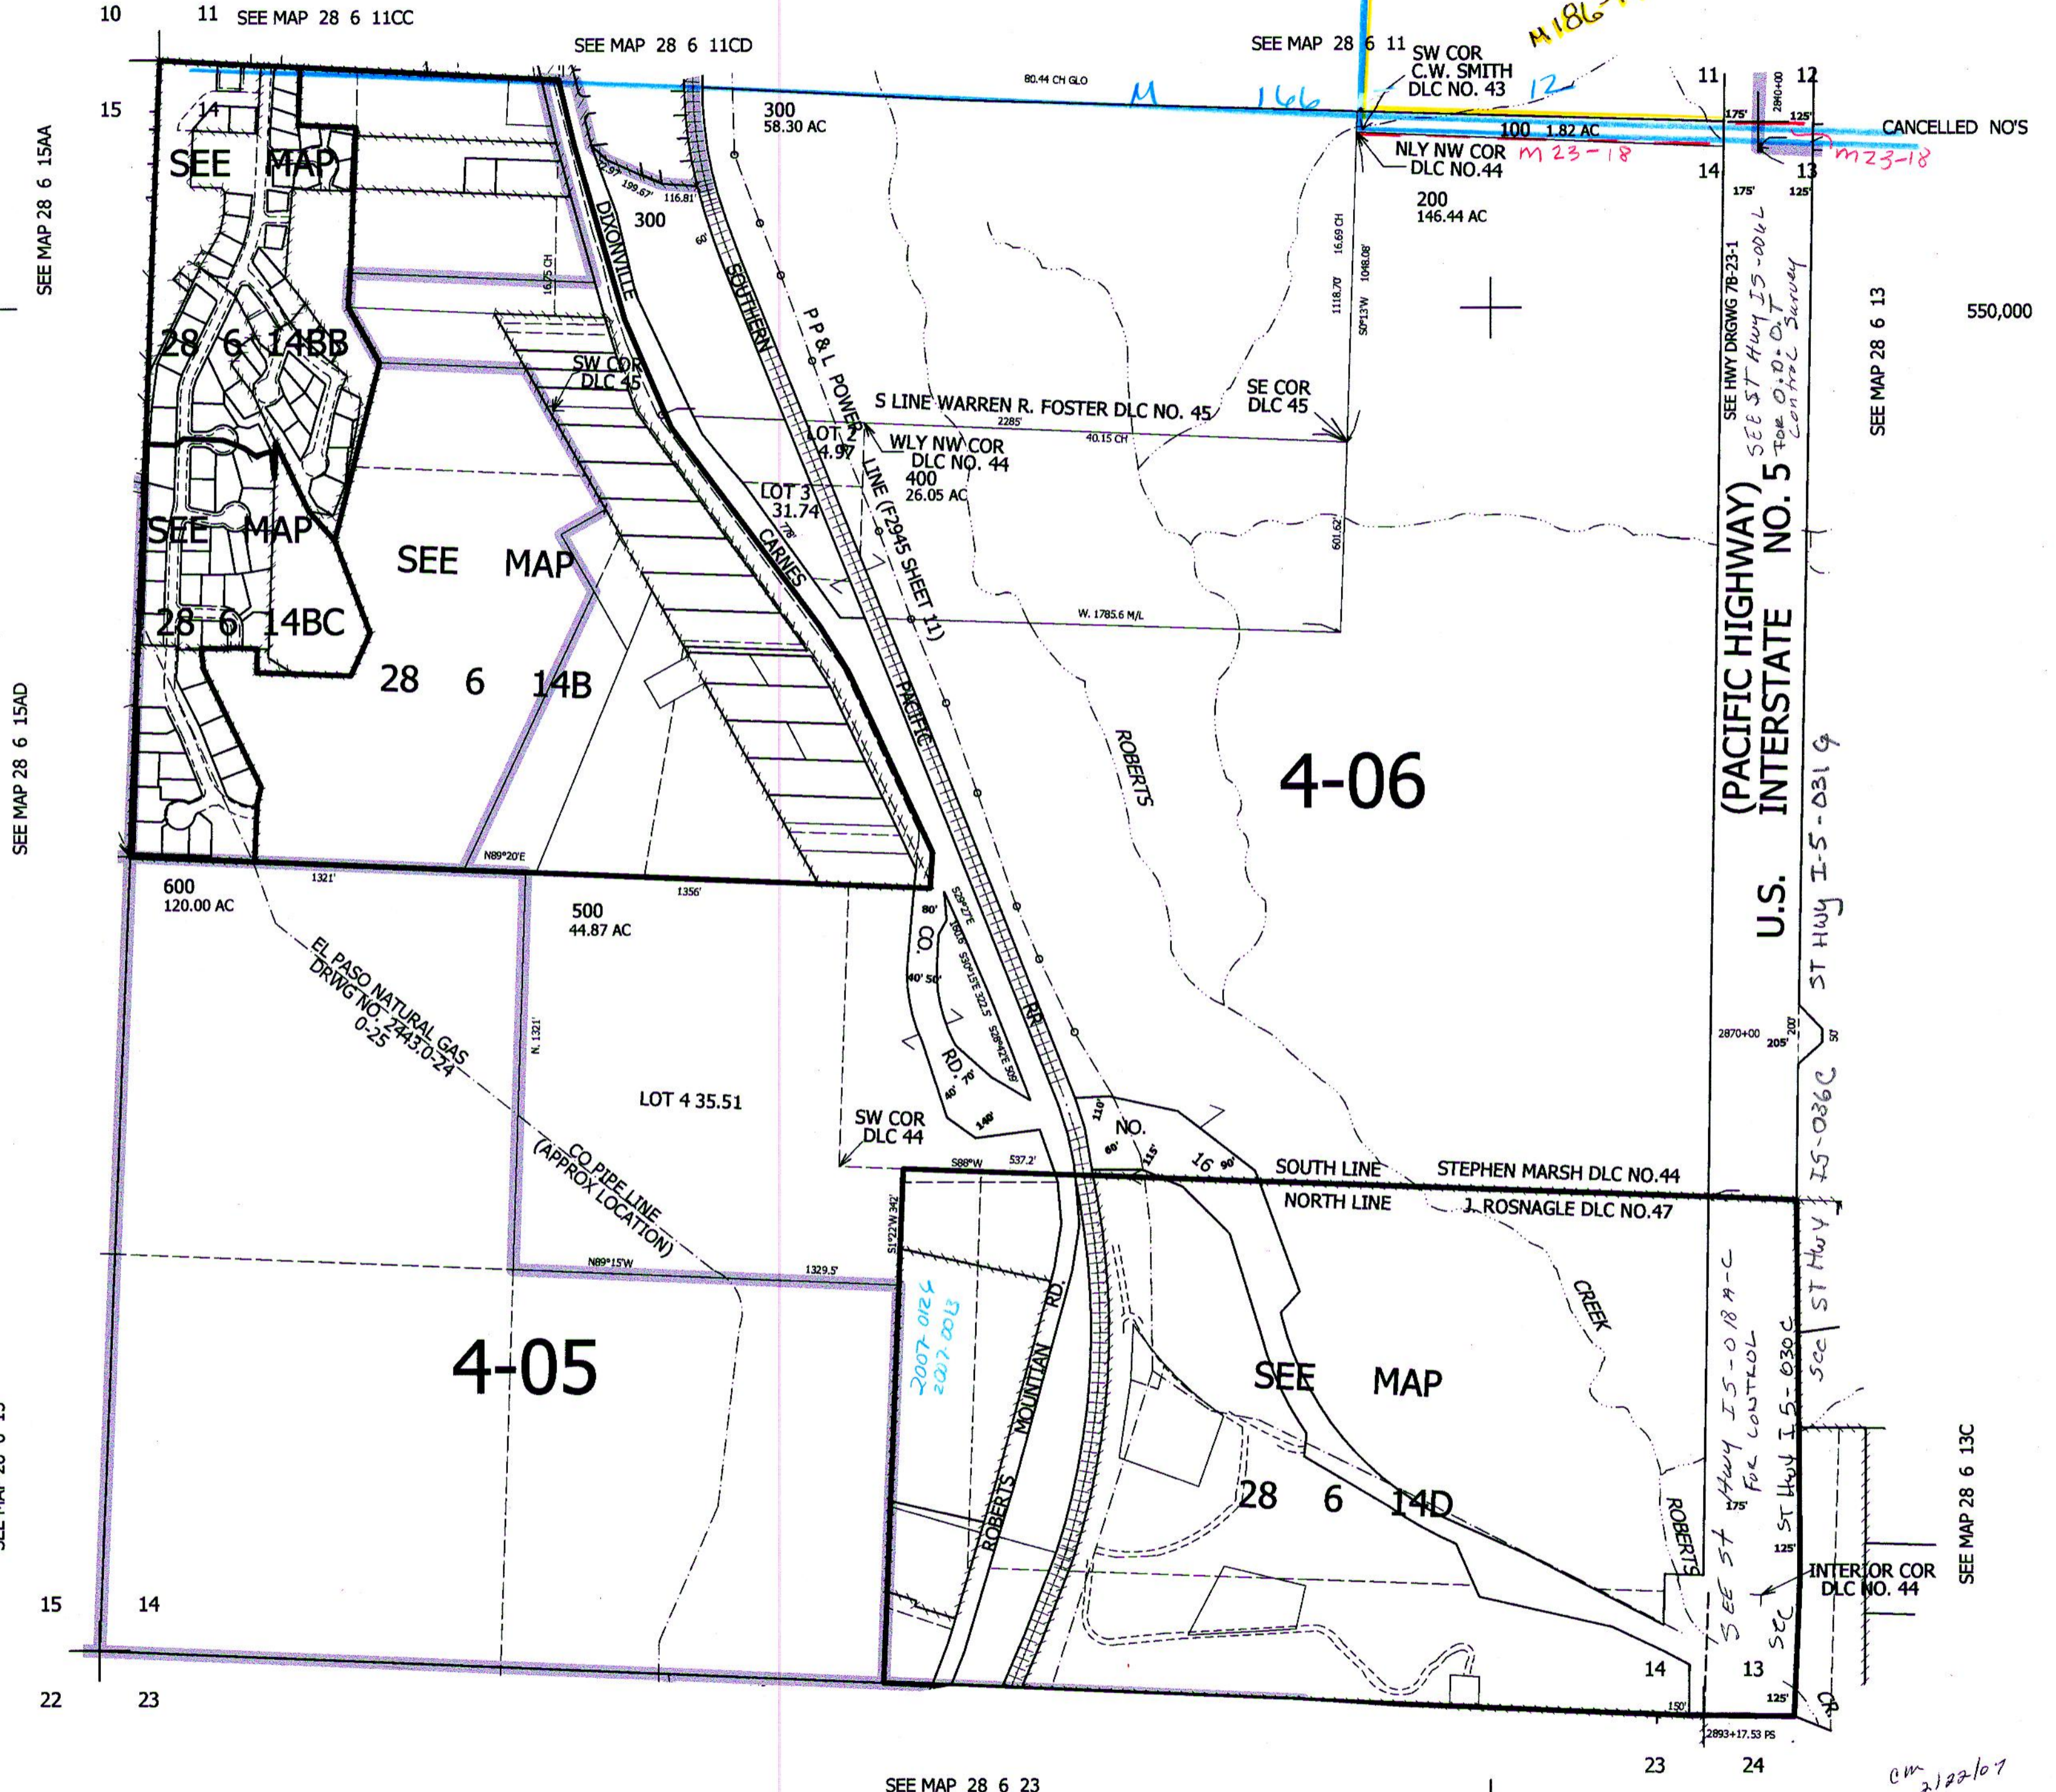

SEE MAP 28 6 15AA

SEE MAP 28 6 15AD

SEE MAP 28 6 15

SEE MAP 28 6 23

4,156,000

SEE MAP 28 6 13

550,000

SEE MAP 28 6 13C

28 6 14
& INDEX

cm 2/22/07

rw