

THIS MAP WAS PREPARED FOR ASSESSMENT PURPOSE ONLY.

SW1/4 SEC.20 T.28S. R.6W. W.M. DOUGLAS COUNTY

REVISED ON 10-16-17

28 6 20C WINSTON

SEE MAP 28 6 20BC

1" = 200'

SEE MAP 28 6 20BD

CANCELLED NO'S 804 809 201 1100 THRU 1500

CEN/SEC


CEN/SEC

SEE MAP 28 6 20D

CEN/SEC

4,138,000

28 6 20C A/98 JP WINSTON

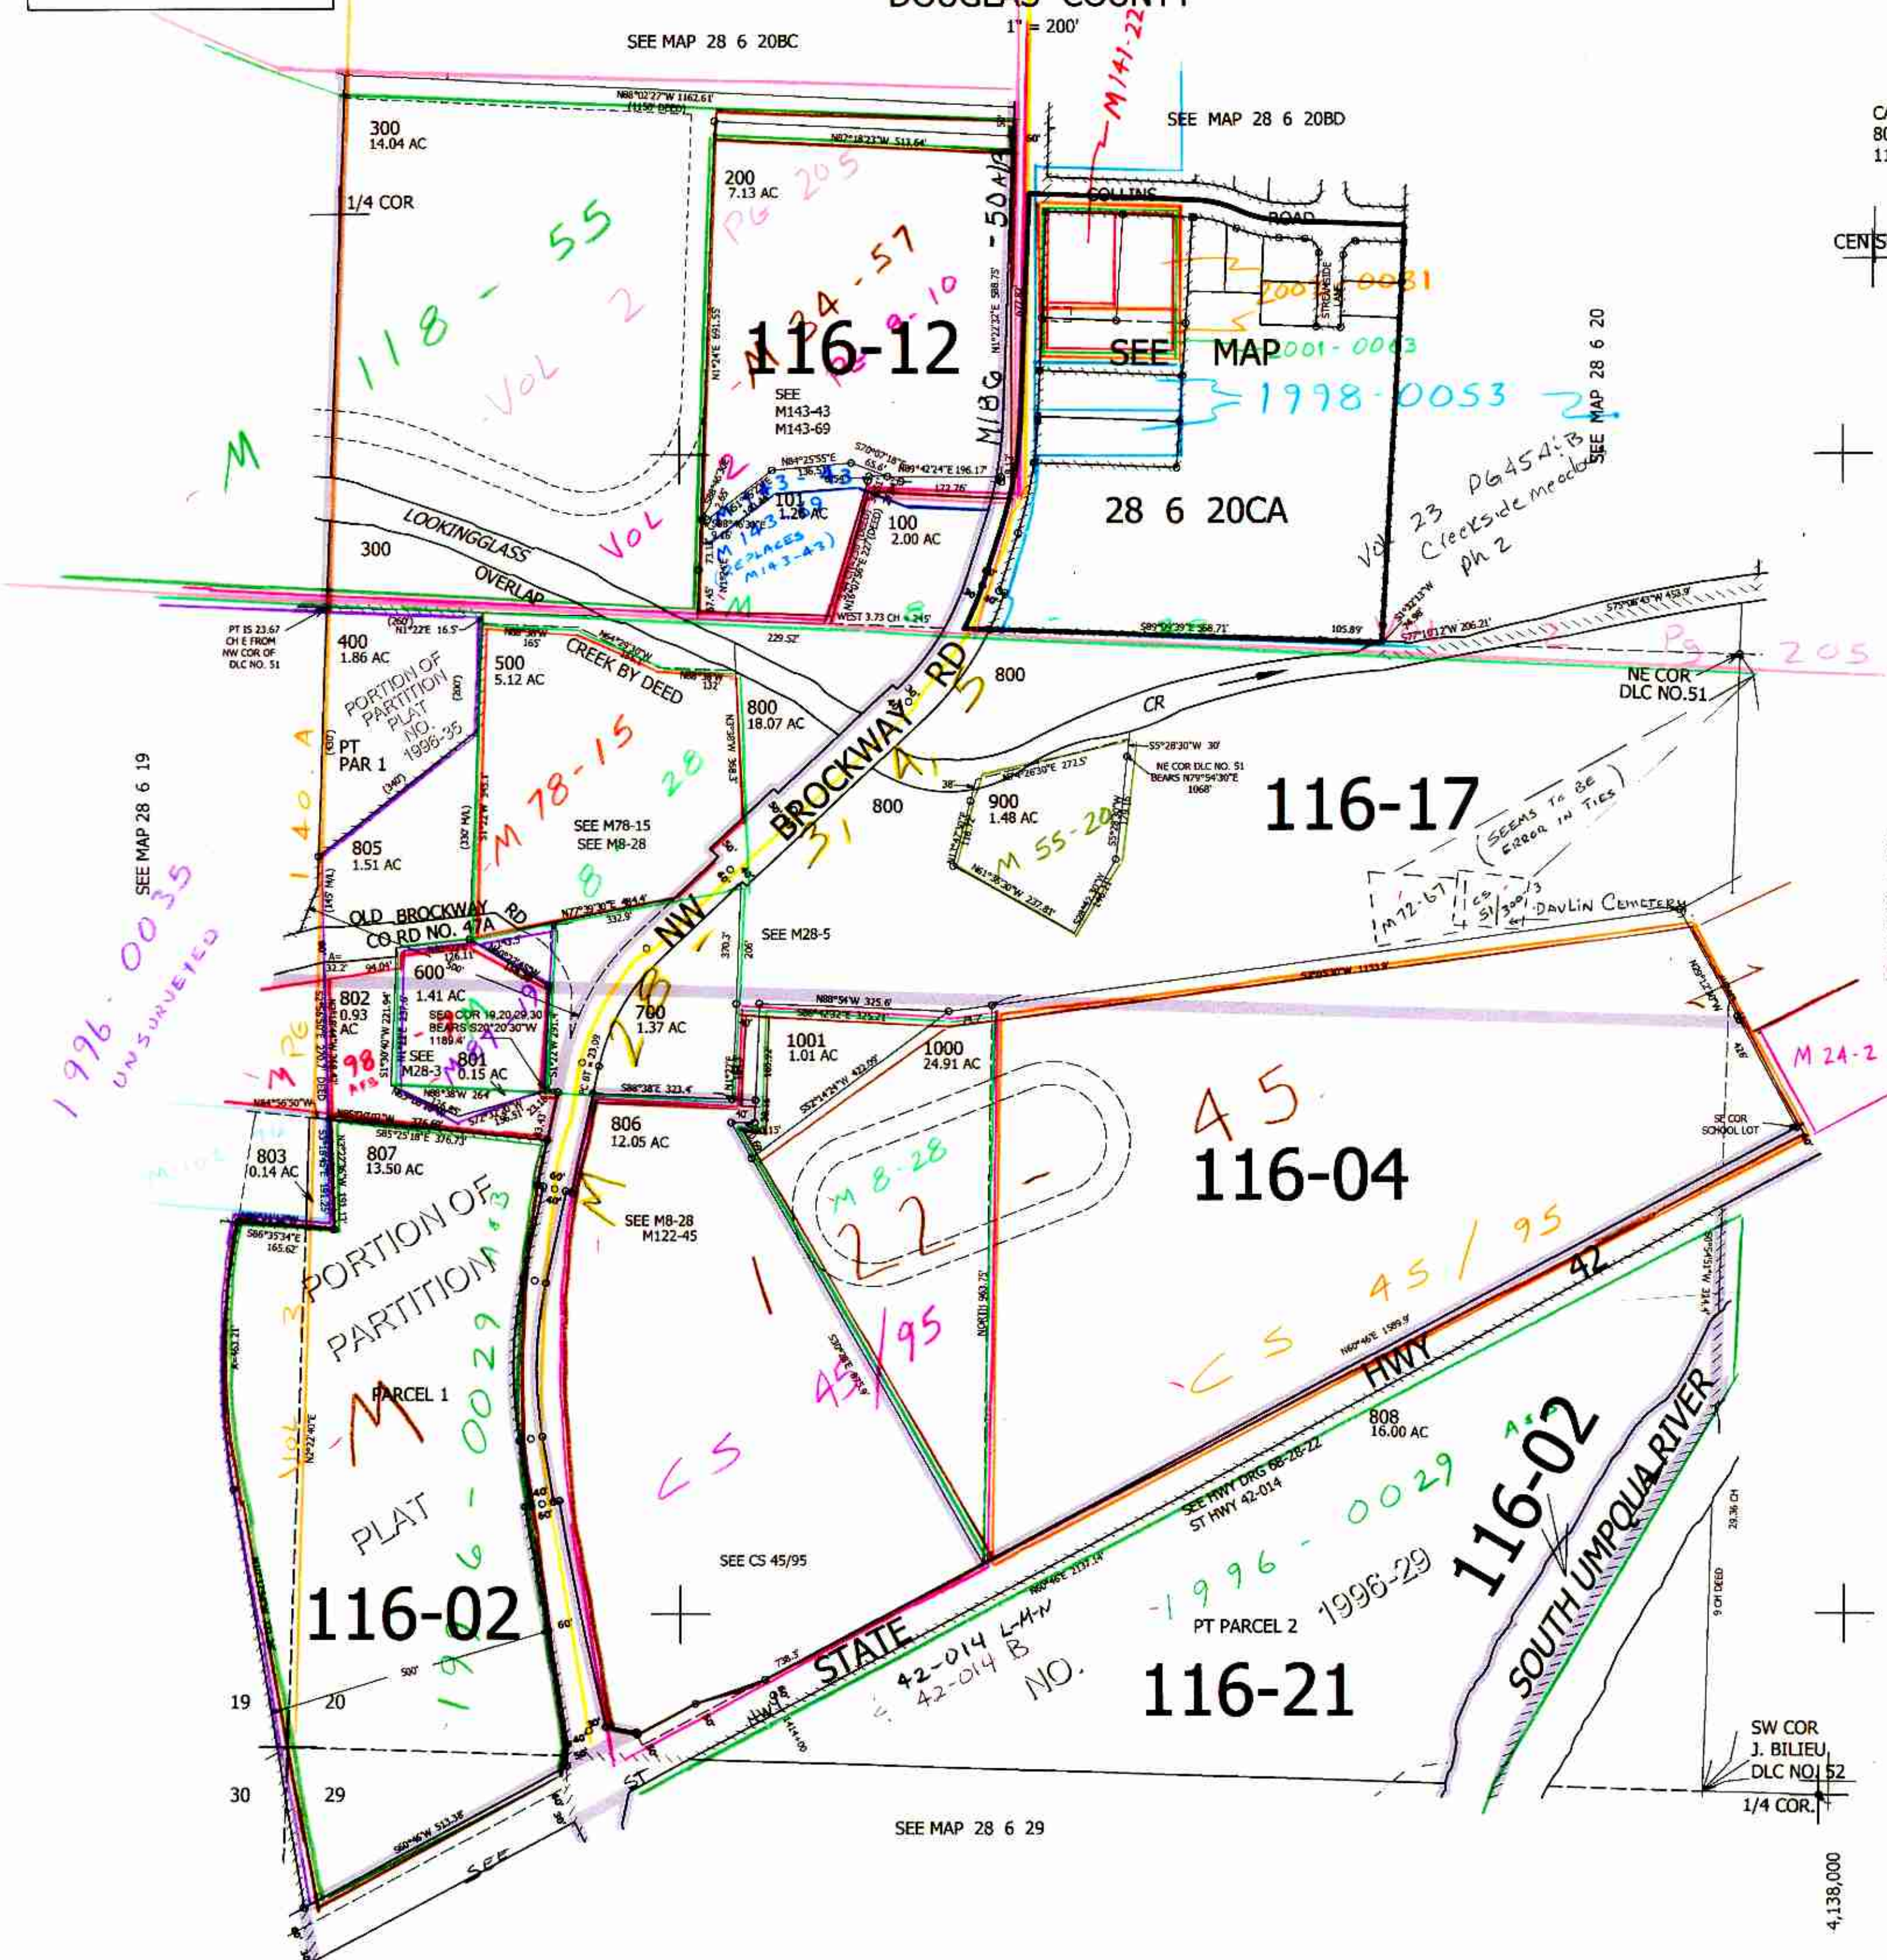

1996-0035 UNSURVEIED

118-55 Vol 2

116-12

SEE MAP 001-0063 1998-0053

Vol 23 PG 454: B Creekside meadow Ph 2

SEE MAP 28 6 20

NE COR DLC NO. 51

116-17

SEEMS TO BE Error in Ties

1996-0035 UNSURVEIED

M 78-15

BROCKWAY RD

45 116-04

116-02

M 8-28

45/95

116-02

116-21

SEE CS 45/95

1996-0029

116-02

STATE ST

PT PARCEL 2

116-02

SEE MAP 28 6 29

SW COR J. BILIEU, DLC NO. 52

1/4 COR.

541,000