

SECTION 21 T.28S. R.6W. W.M.
DOUGLAS COUNTY

28 0 21
& INDEX
WINSTON


THIS MAP WAS PREPARED FOR
ASSESSMENT PURPOSE ONLY.

1"=400'

M 104-57
M 101-5
M 86-36-20
M 86-22
M 62-69
M 34-9

M 96-76
M 95-62
M 50-3

CHECKED
LAYOUT
CONTROL

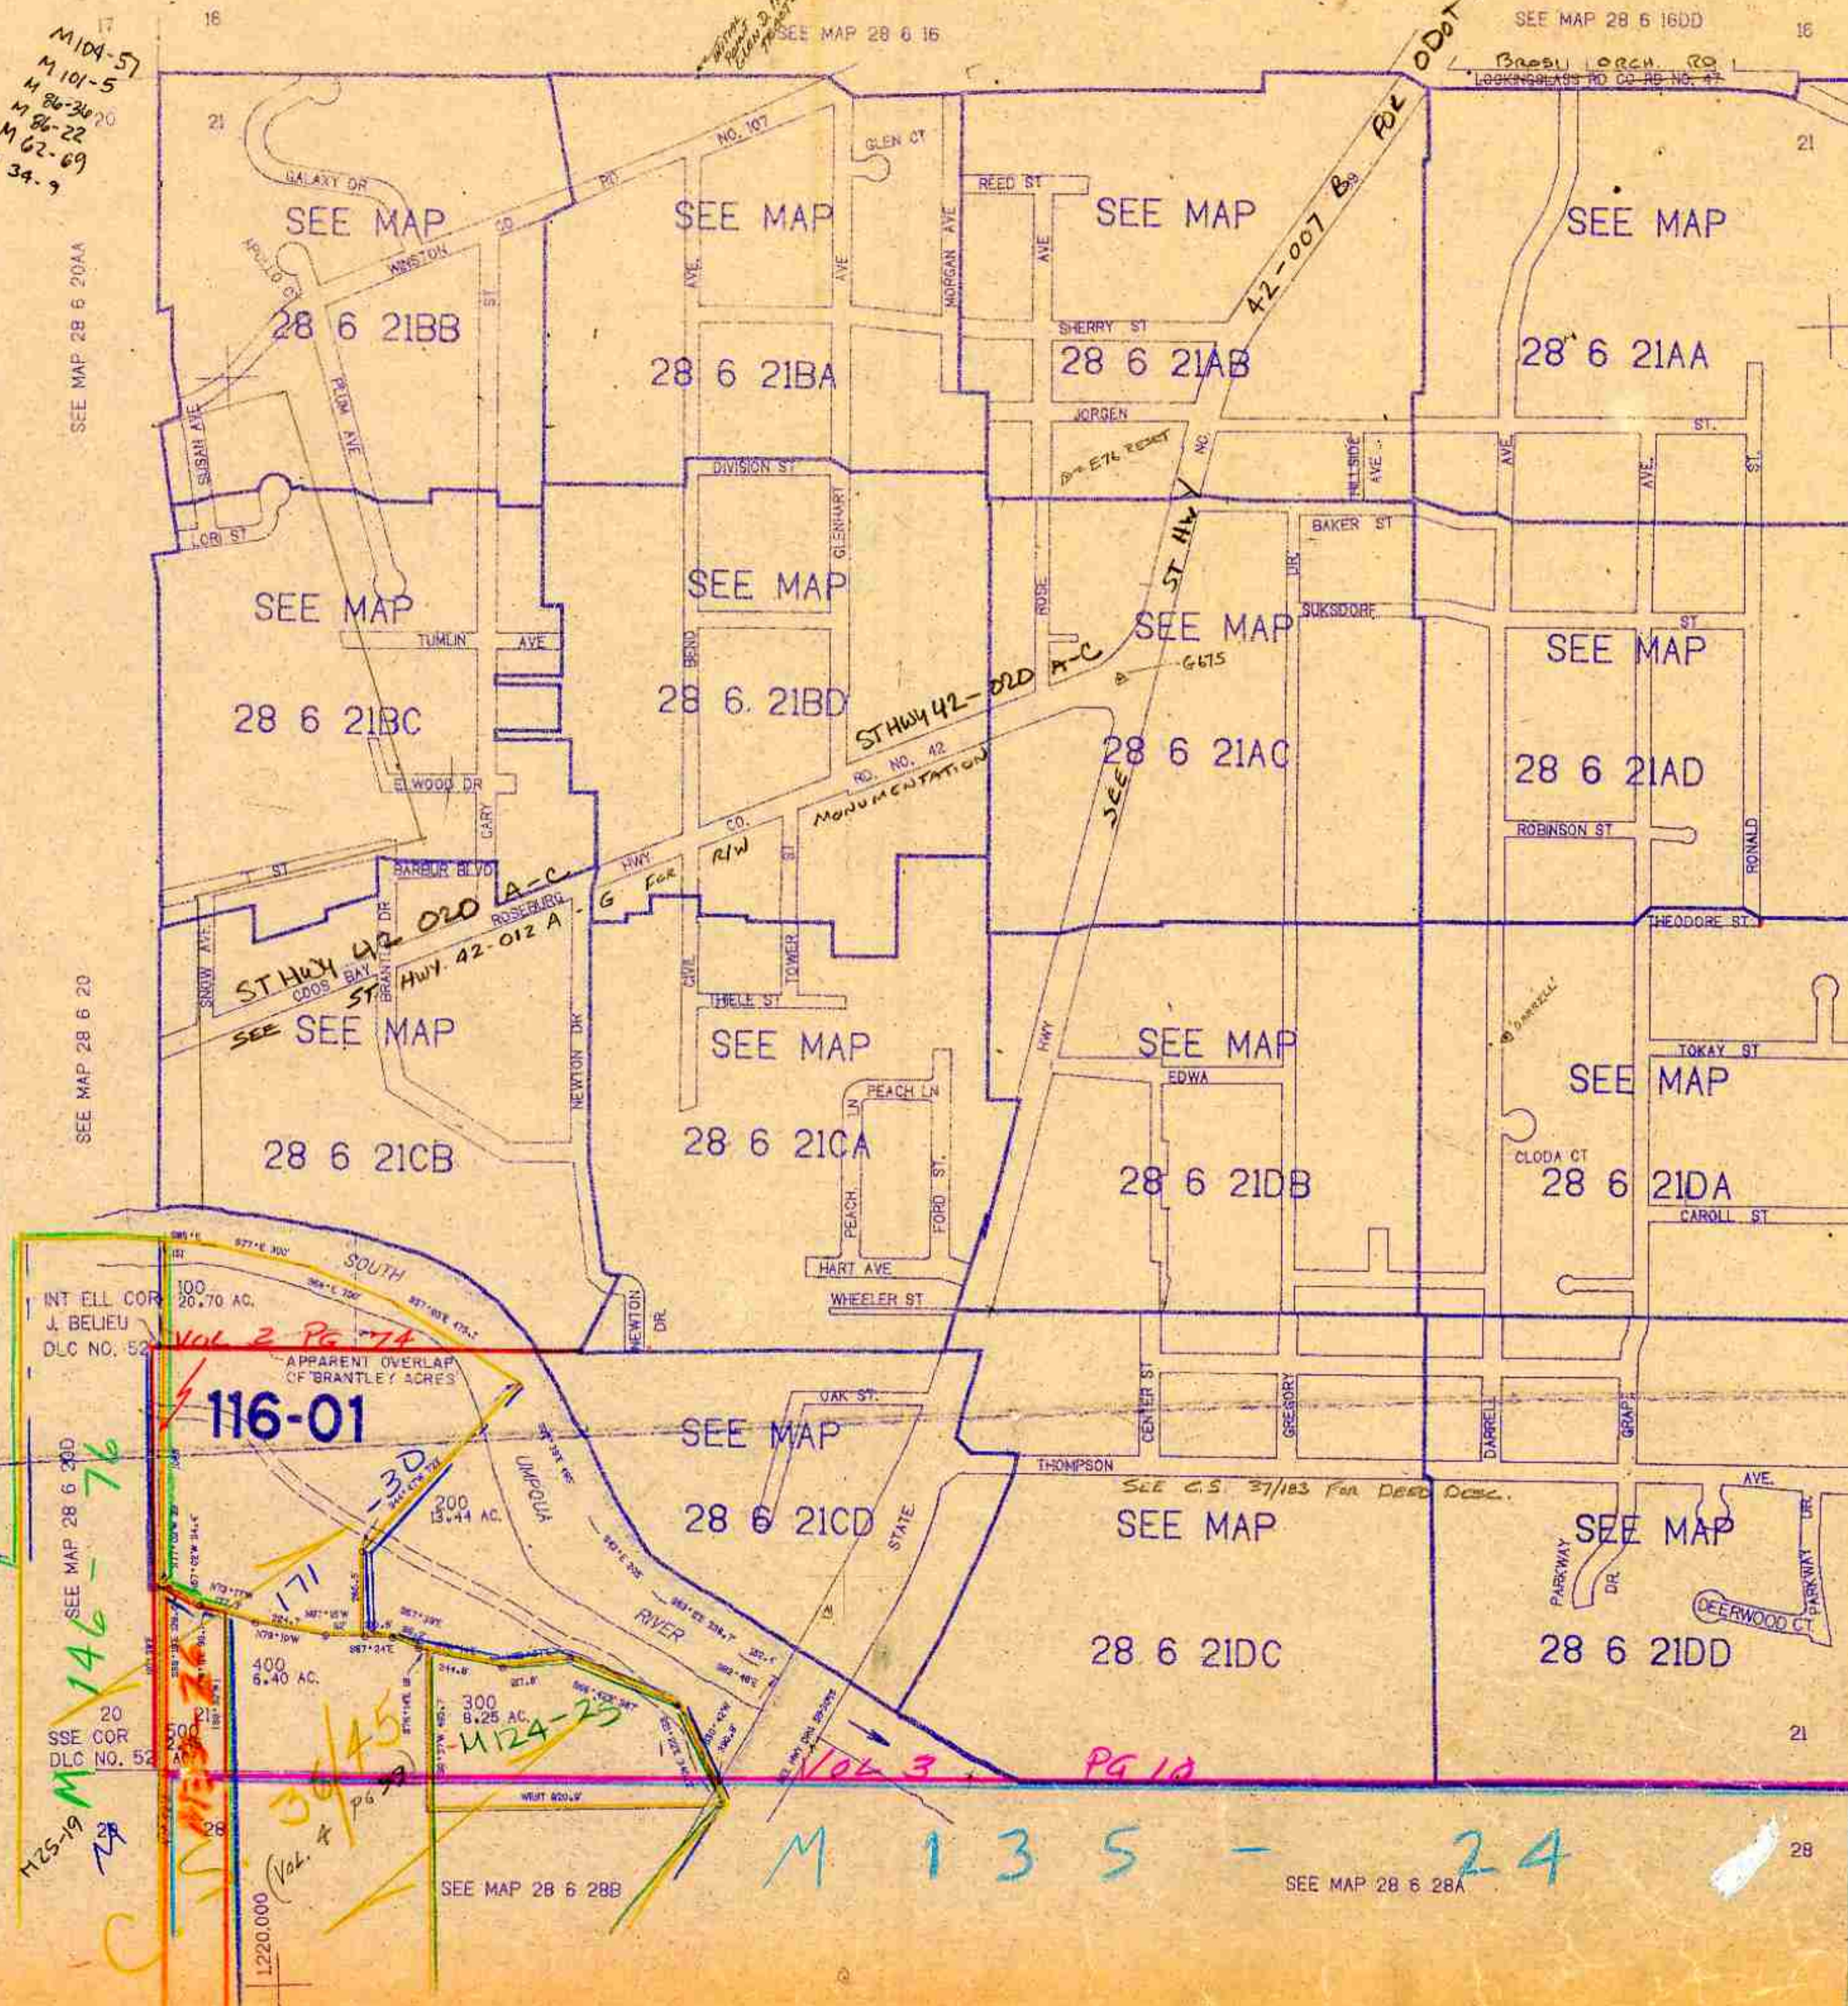

INT ELL COR
J. BELIEU
DLC NO. 52
Vol 2 Pg 74
116-01
APPARENT OVERLAP
OF BRANTLEY ACRES
200
13.44 AC.
400
6.40 AC.
300
8.25 AC.
M 124-25
M 146-76
M 135-24
M 125-19
M 36-45
M 135-24
M 36-28

M 89-24
M 36-28
28 6 21
& INDEX
WINSTON

545 000

SEE MAP 28 6 22B

SEE MAP 28 6 22CB

SEE MAP 28 6 22CC

SEE MAP 28 6 28A

SEE MAP 28 6 28B

SEE MAP 28 6 20AA

SEE MAP 28 6 20

SEE MAP 28 6 16

SEE MAP 28 6 16DD

M 135 - 24

M 82-24