

NE1/4 SEC. 22 T.28S. R.6W. W.M.  
DOUGLAS COUNTY

28 6 22A  
WINSTON


THIS MAP WAS PREPARED FOR  
ASSESSMENT PURPOSE ONLY.

1"=200'

SEE MAP 28 6 15

15 14  
22 23

Cancelled #'s  
80042

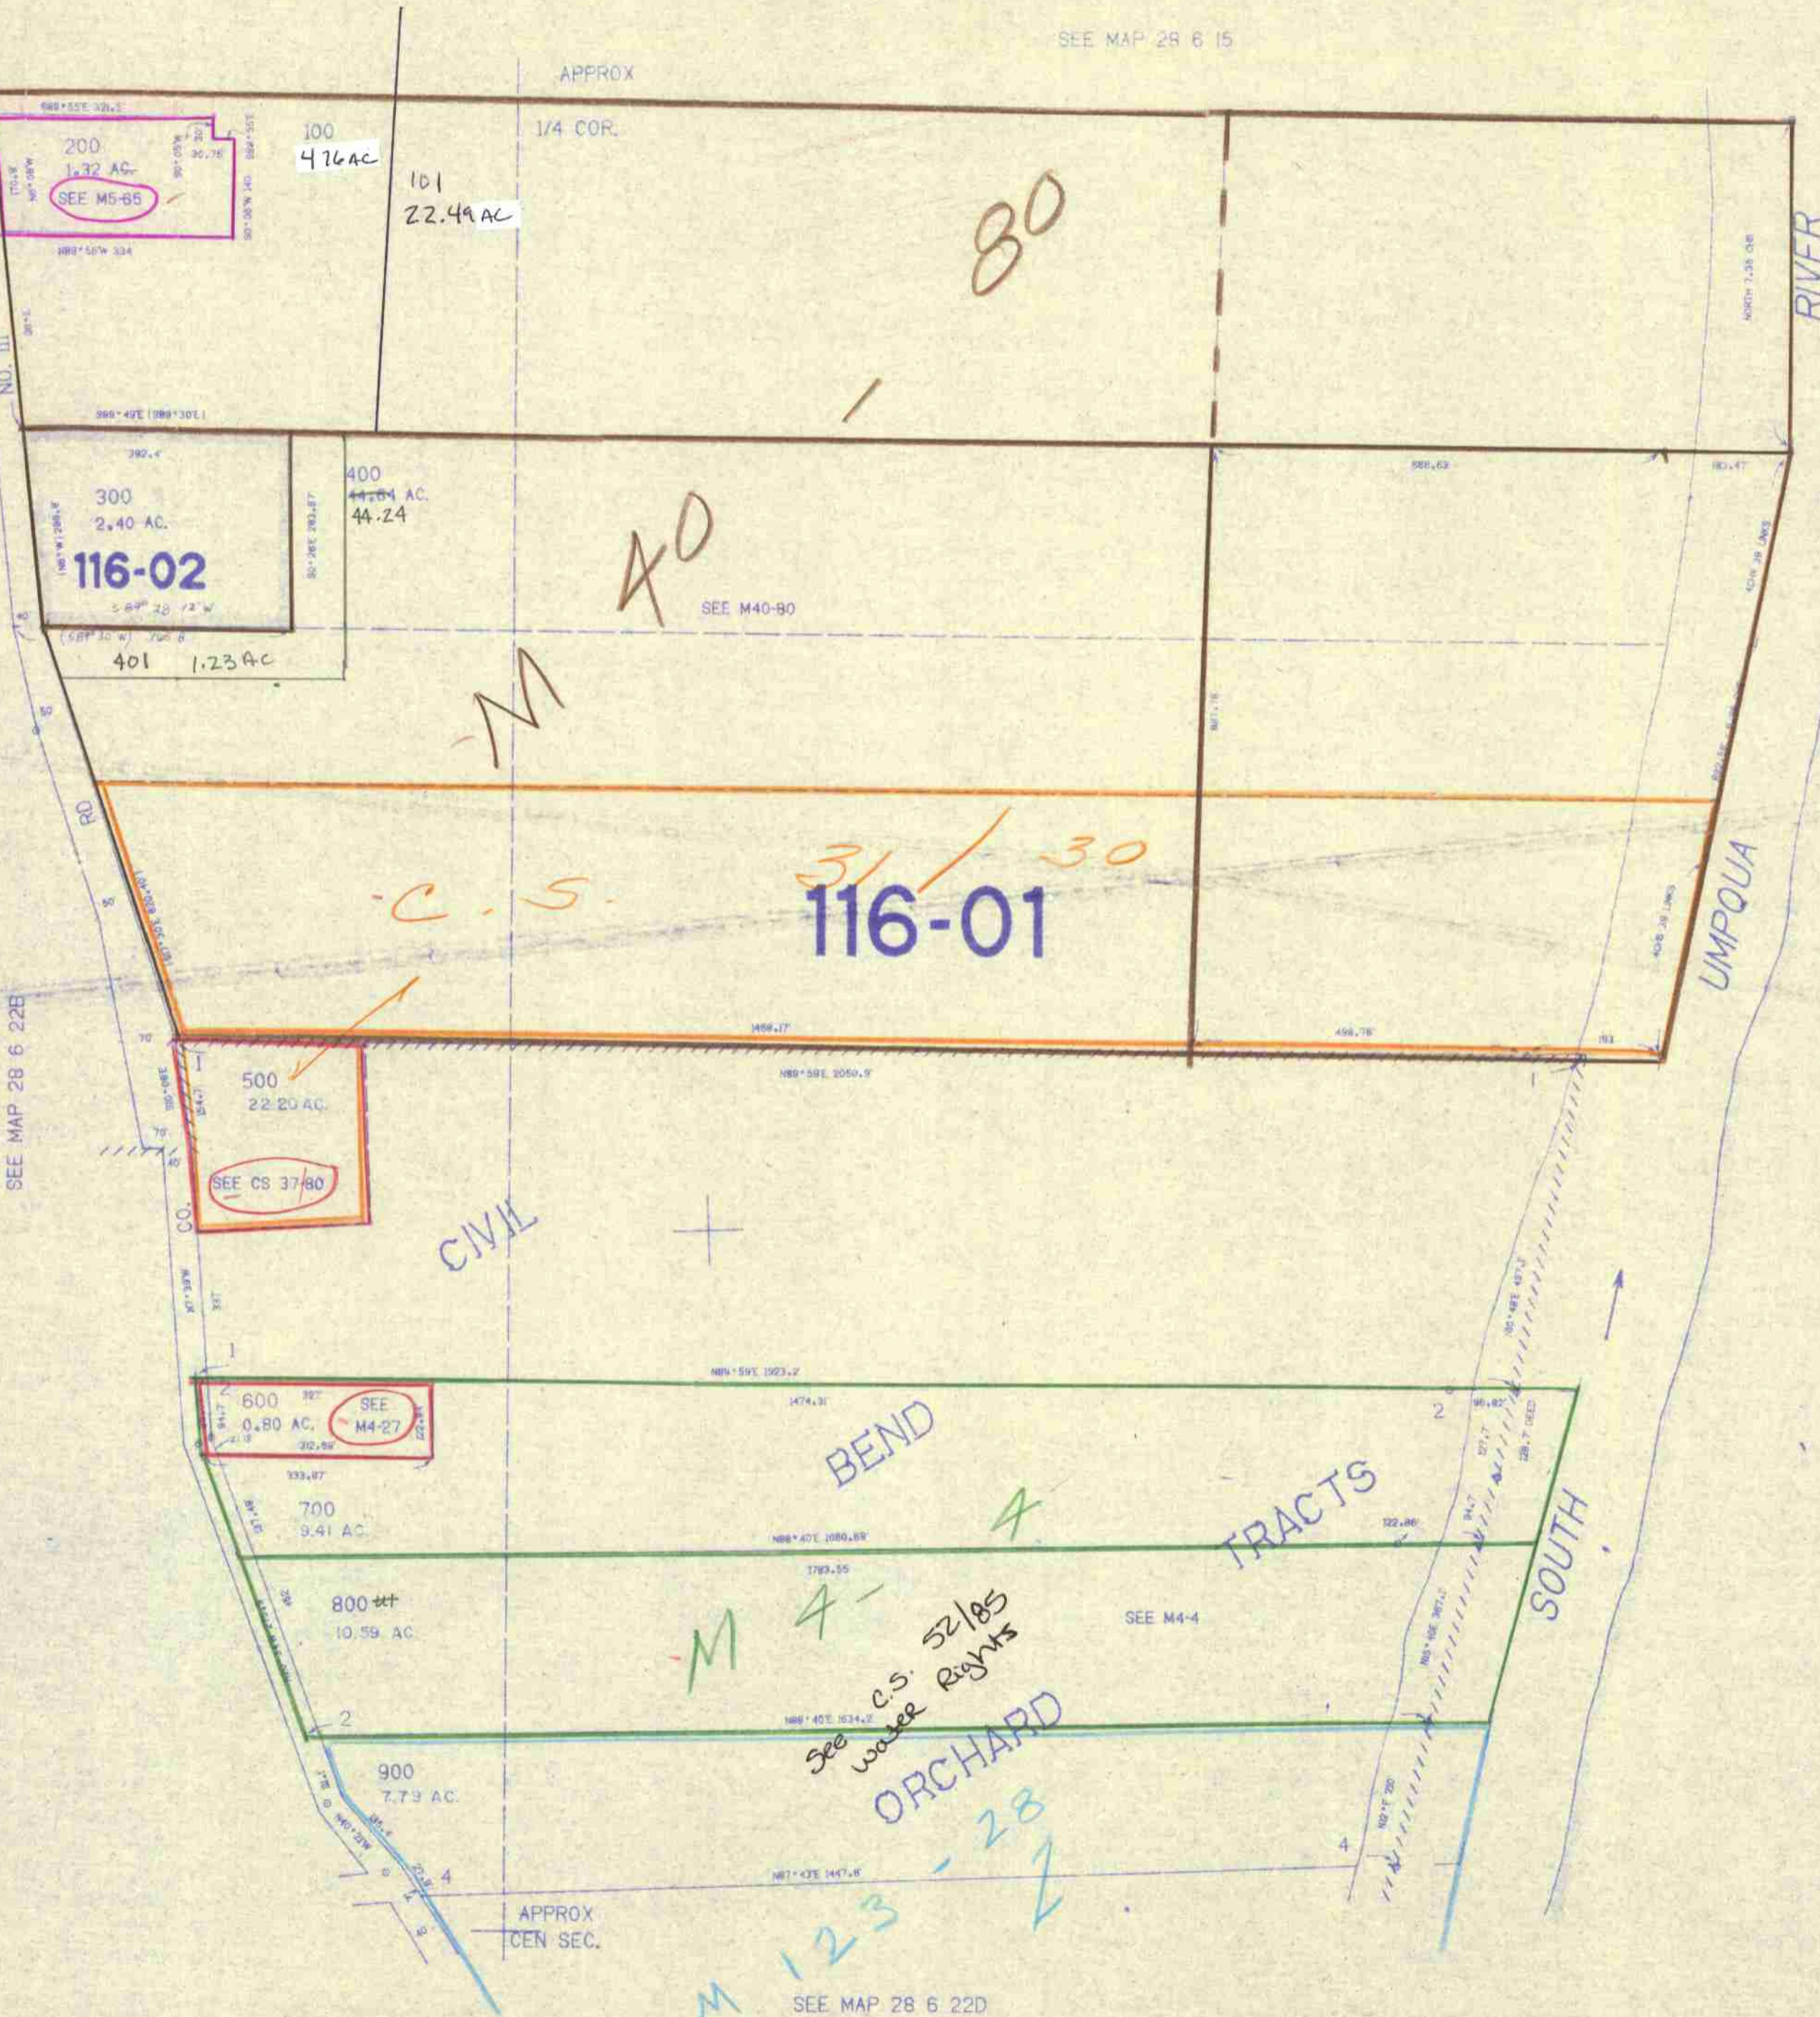

SEE MAP 28 6 22

544.000

M 123-28  
Z

SEE MAP 28 6 22D

APPROX  
1/4 COR.

28 6 22A  
WINSTON

540.000

CONTROL LAYOUT TRACED CHECKED