

THIS MAP WAS PREPARED FOR ASSESSMENT PURPOSE ONLY.

SEC.29 T.28S. R.6W. W.M. DOUGLAS COUNTY


1" = 400'

REVISED ON 11-09-21

28 6 29 & INDEX WINSTON

- PARCEL 501
- S27°53'10"E 69.33'
  - S11°11'14"E 93.7'
  - S8°46'22"E 106.98'
  - N76°35'54"W 121.51'
  - S62°49'17"W 46.52'
  - N66°23'52"W 101.77'
  - S86°36'50"W 70.28'
  - S47°50'06"W 44.72'
  - N89°52'58"W 73.83'
  - S56°22'42"W 84.96'
  - N8°48'38"W 41.23'
  - N60°14'50"E 506.95'

- PARCEL 503
- LC=S8°23'09"E 146.39'
  - N6°51'54"W 23.22'
  - N8°46'22"W 137.27'
  - THRU 10. SAME AS PARCEL 501
  - N8°48'38"W 273.38'
  - EAST 503.91'

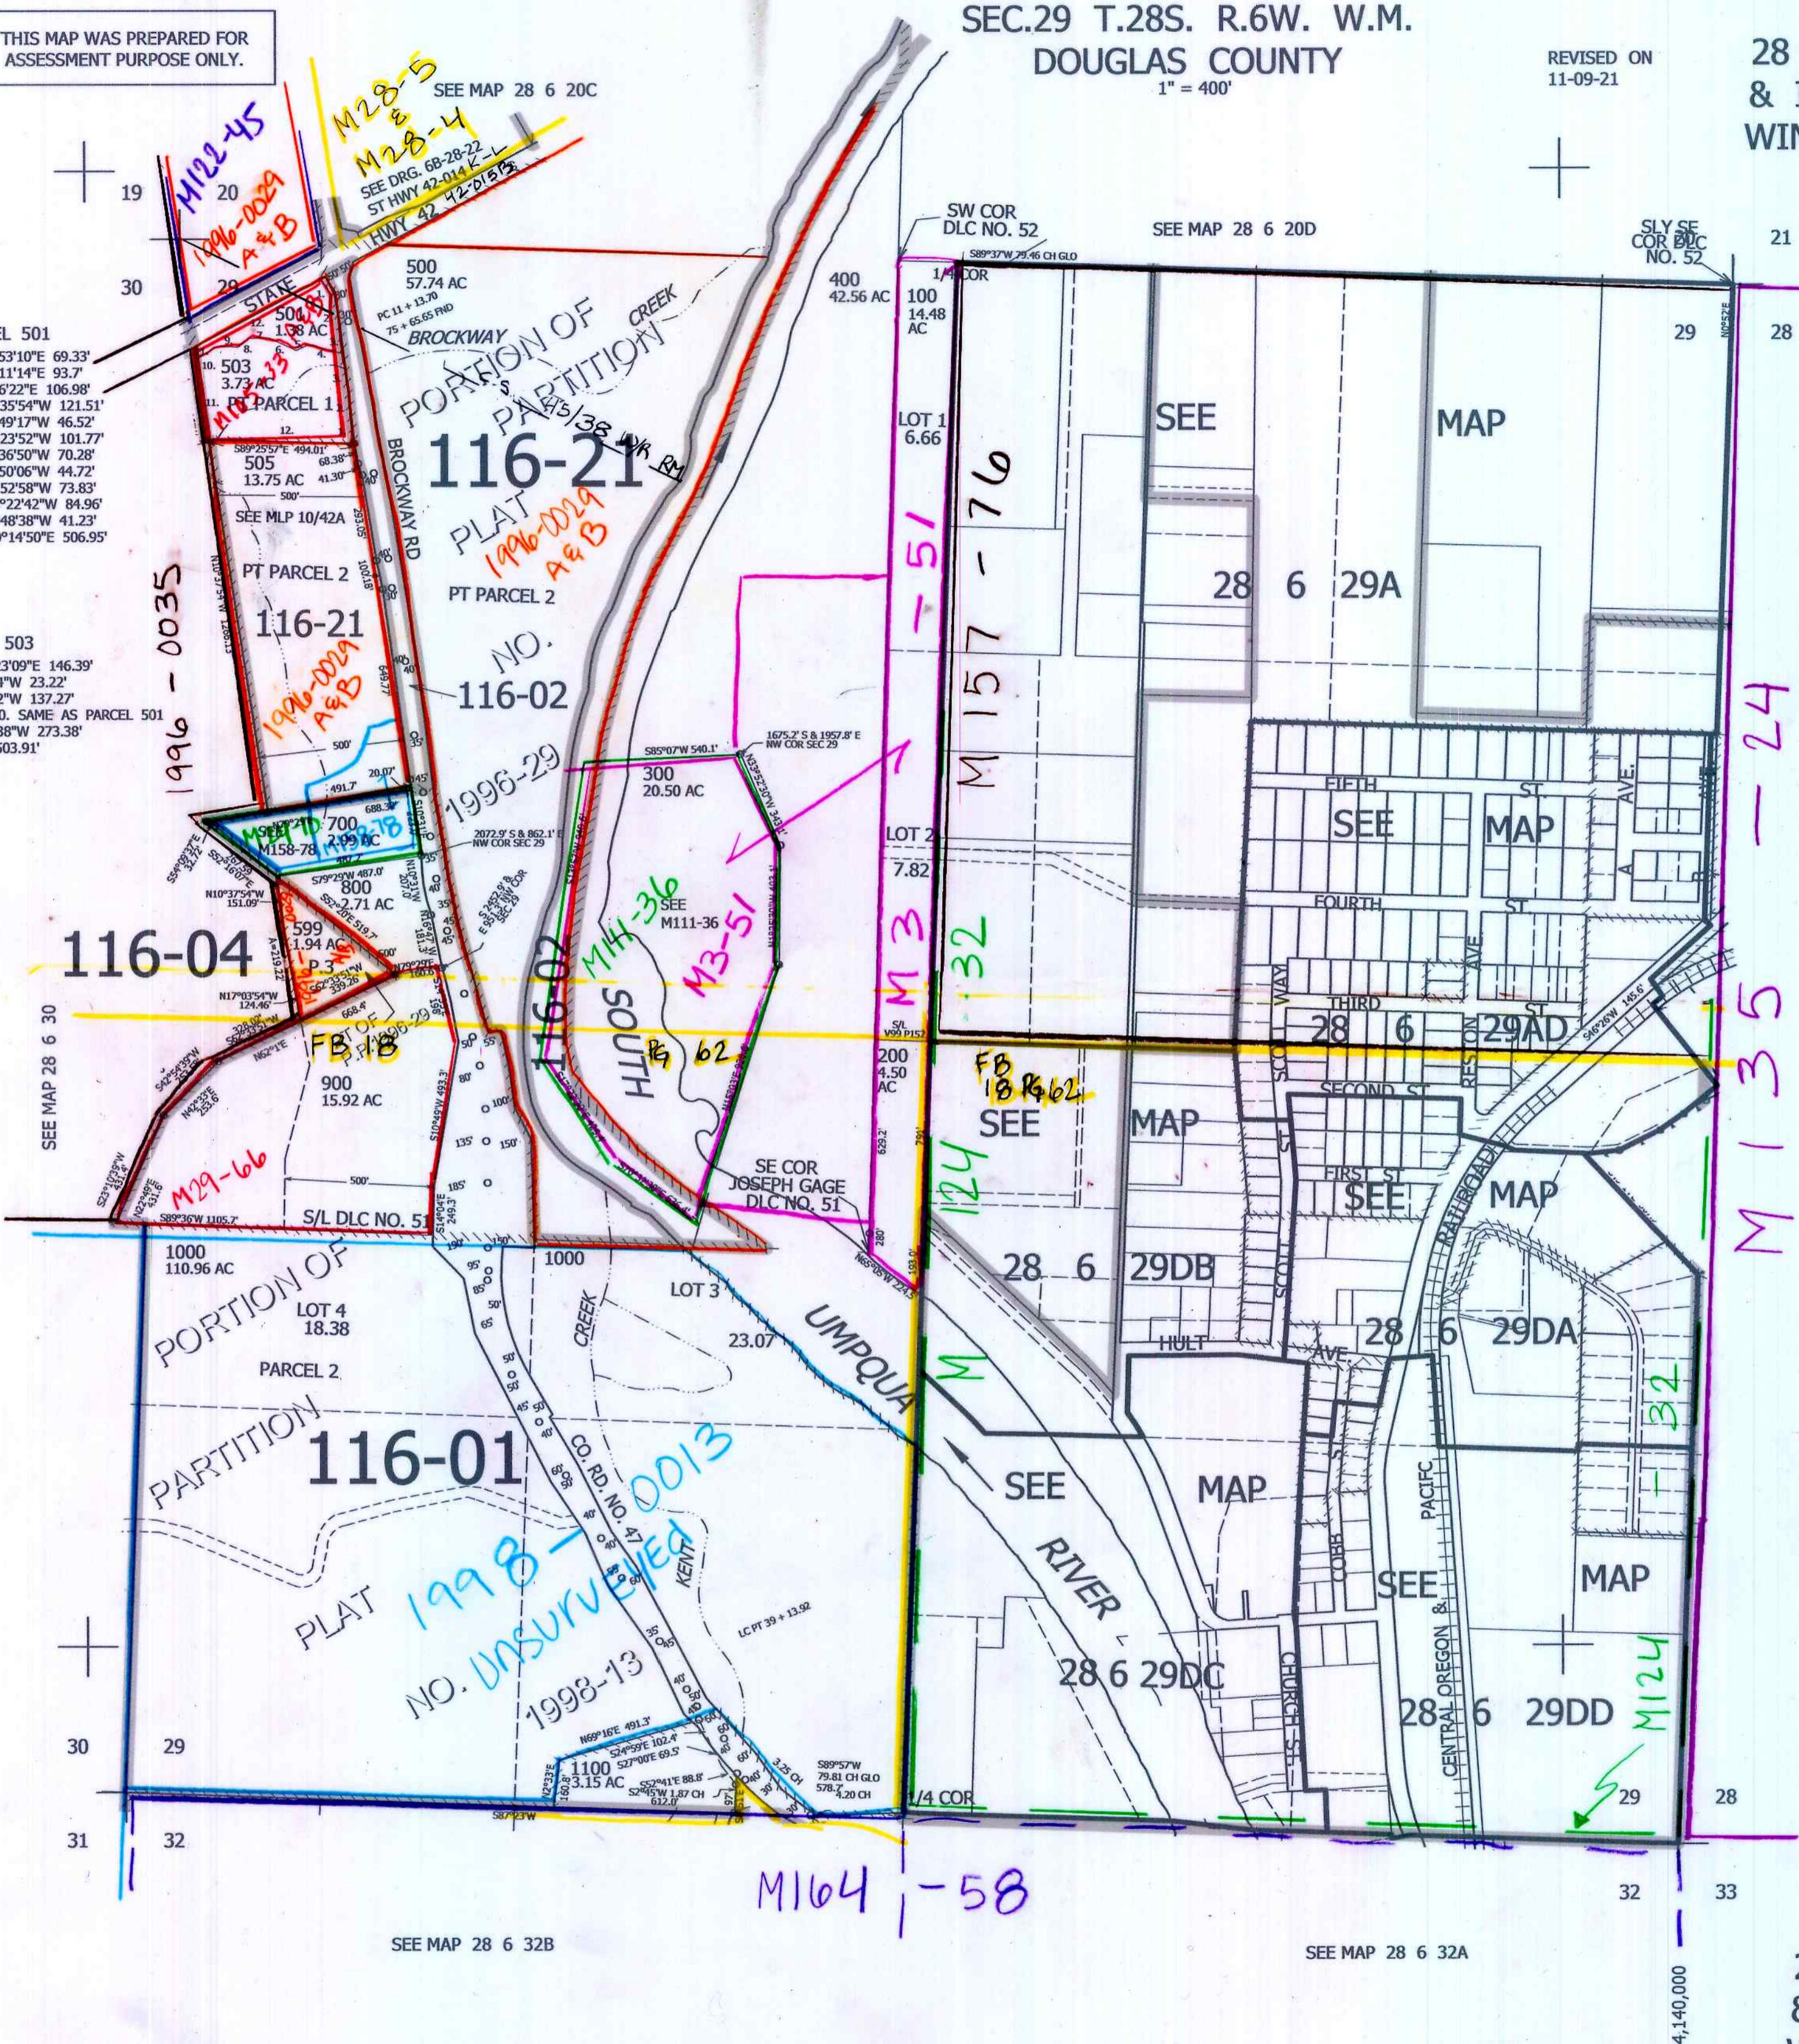

CANCELLED NO'S 502 600 504

SEE MAP 28 6 28B

SEE MAP 28 6 28

536,000

28 6 29 & INDEX WINSTON

11/2021 DJ SC

SEE MAP 28 6 32B

SEE MAP 28 6 32A

4,140,000