


This map was prepared for
assessment purpose only

SECTION 31 T.28S. R.6W. W.M.
DOUGLAS COUNTY

28 6 31

1" = 400'

SEE MAP 28 6 30

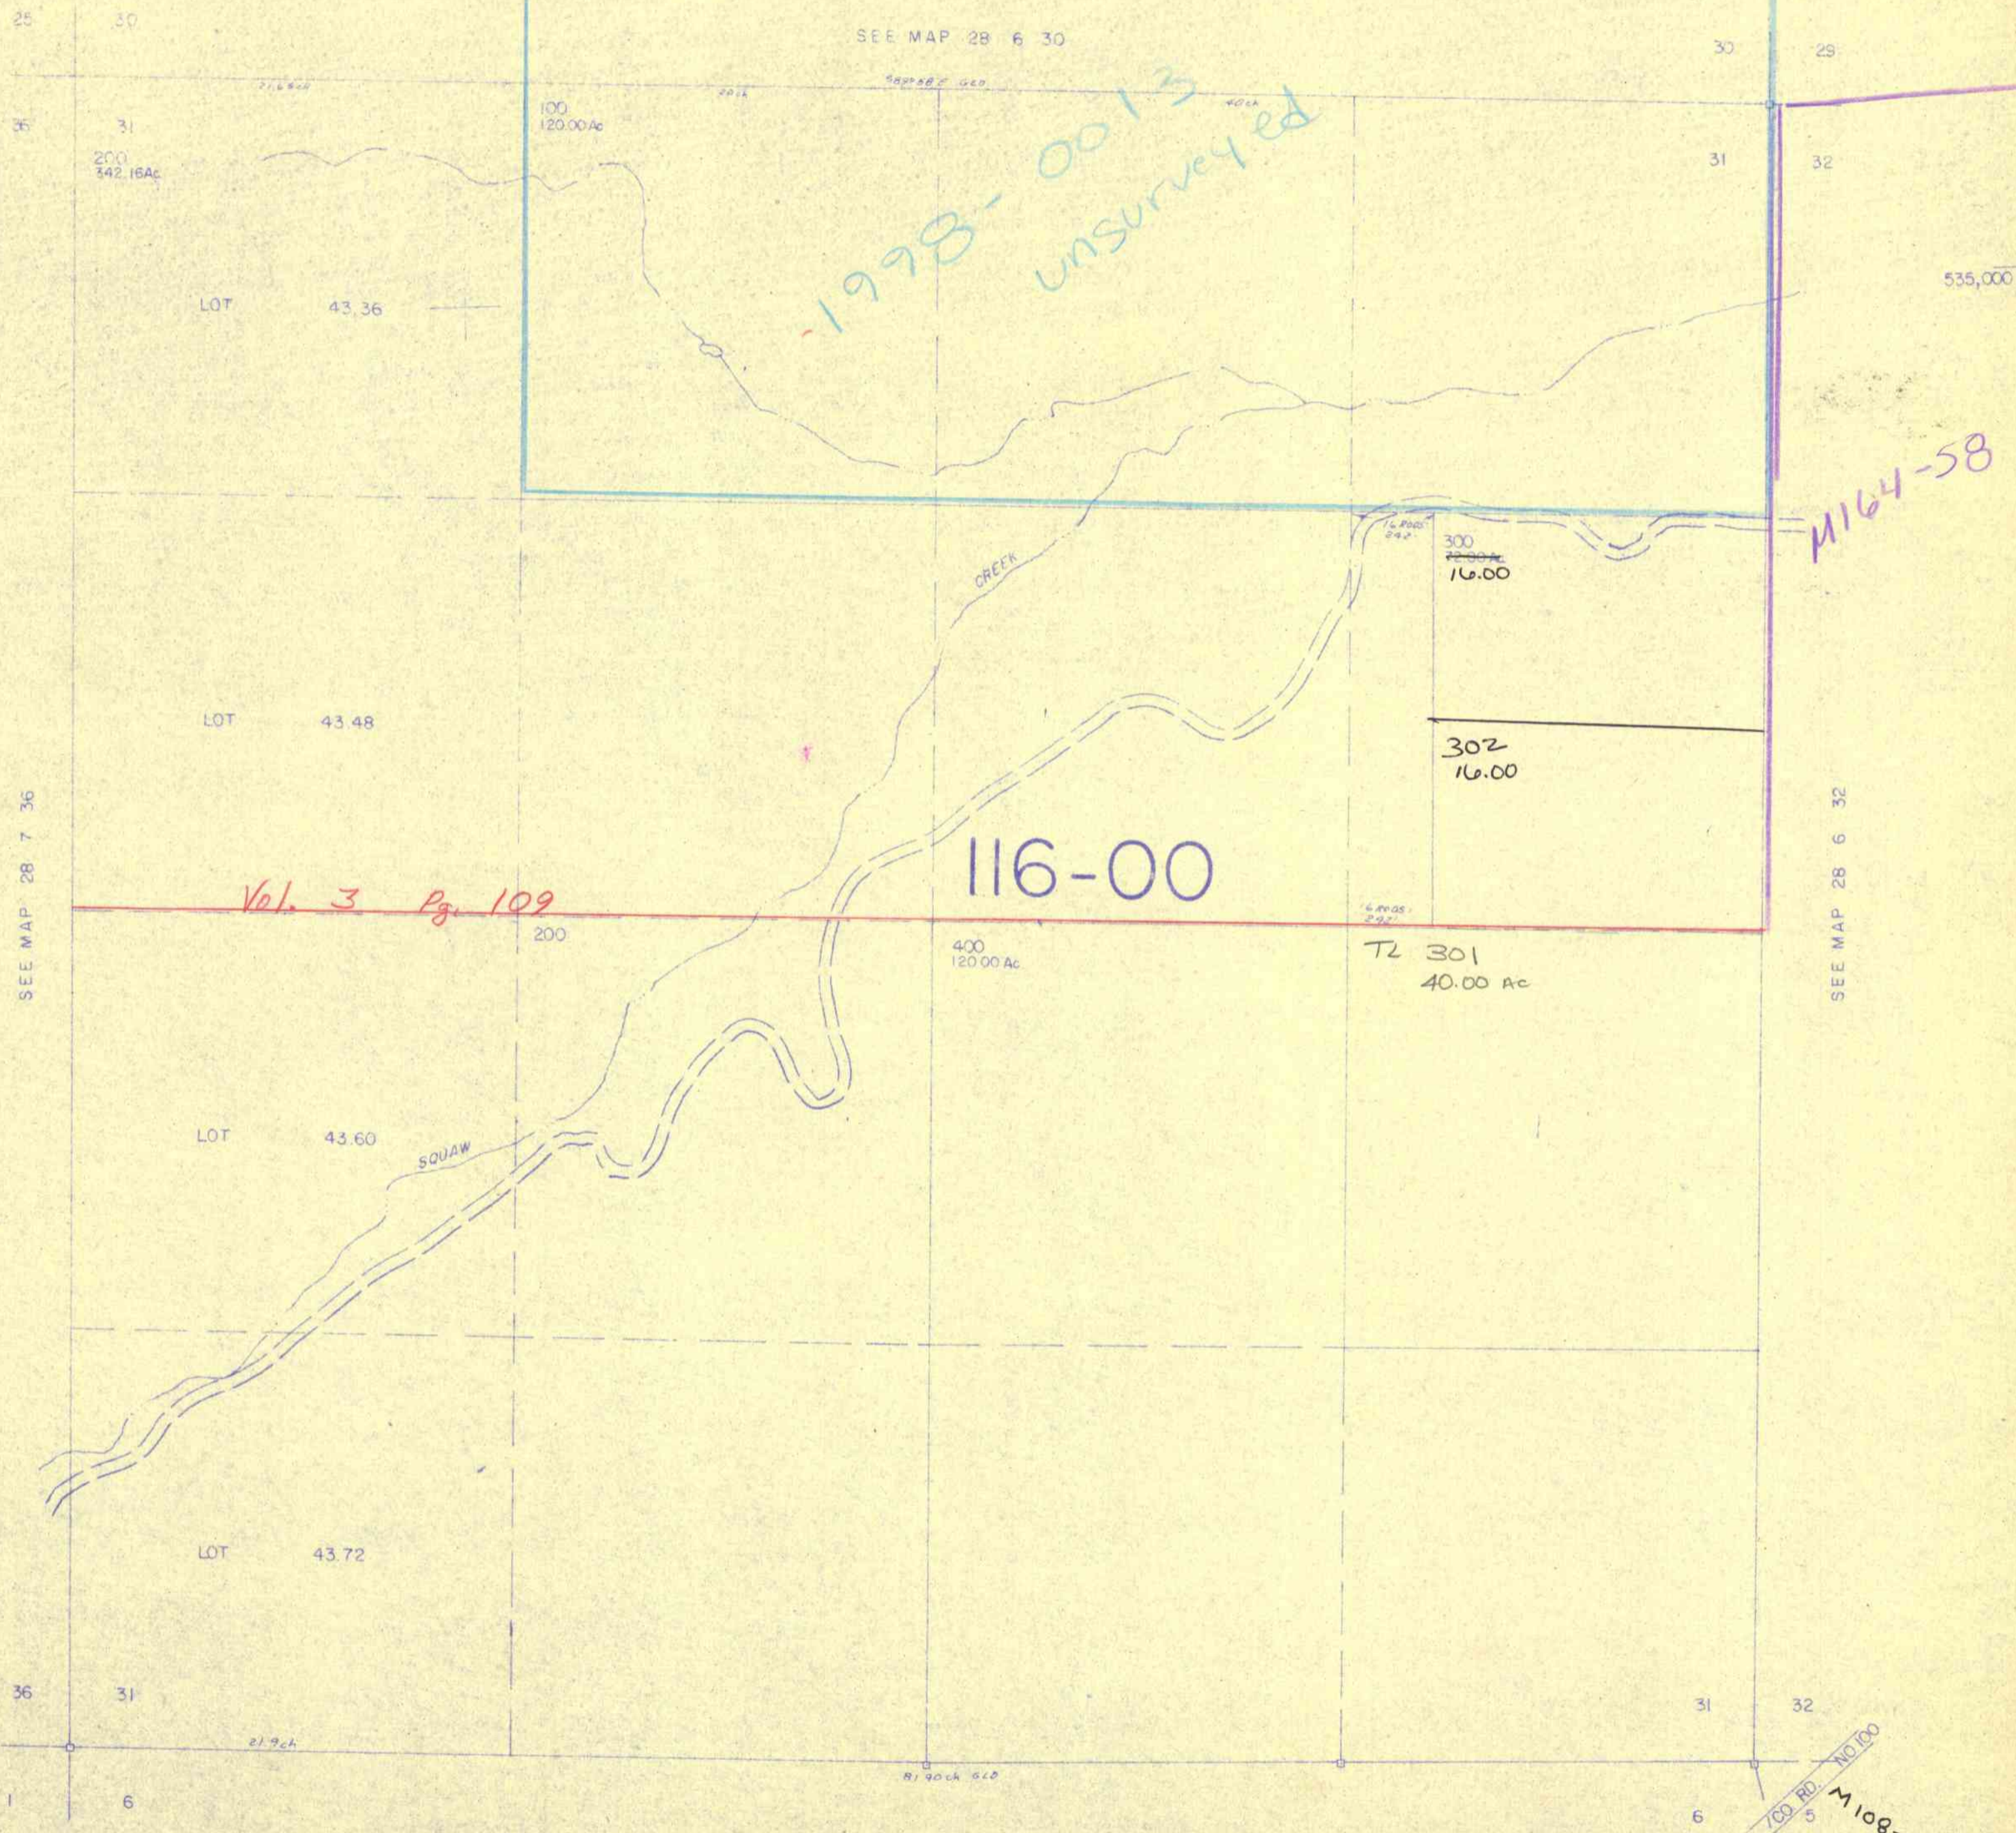

535,000

M164-58

116-00

Vol. 3 Pg. 109

SEE MAP 28 6 32

SEE MAP 29 6 6

1:210,000

700 RD. NO. 100
M108-25

28 6 31

3/82 BS

CONTROL LAYOUT TRACED CHECKED