


NW1/4 SEC. 32 T.28S. R.6W. W.M.
DOUGLAS COUNTY

28 6 32B

THIS MAP WAS PREPARED FOR
ASSESSMENT PURPOSE ONLY.

1"=200'

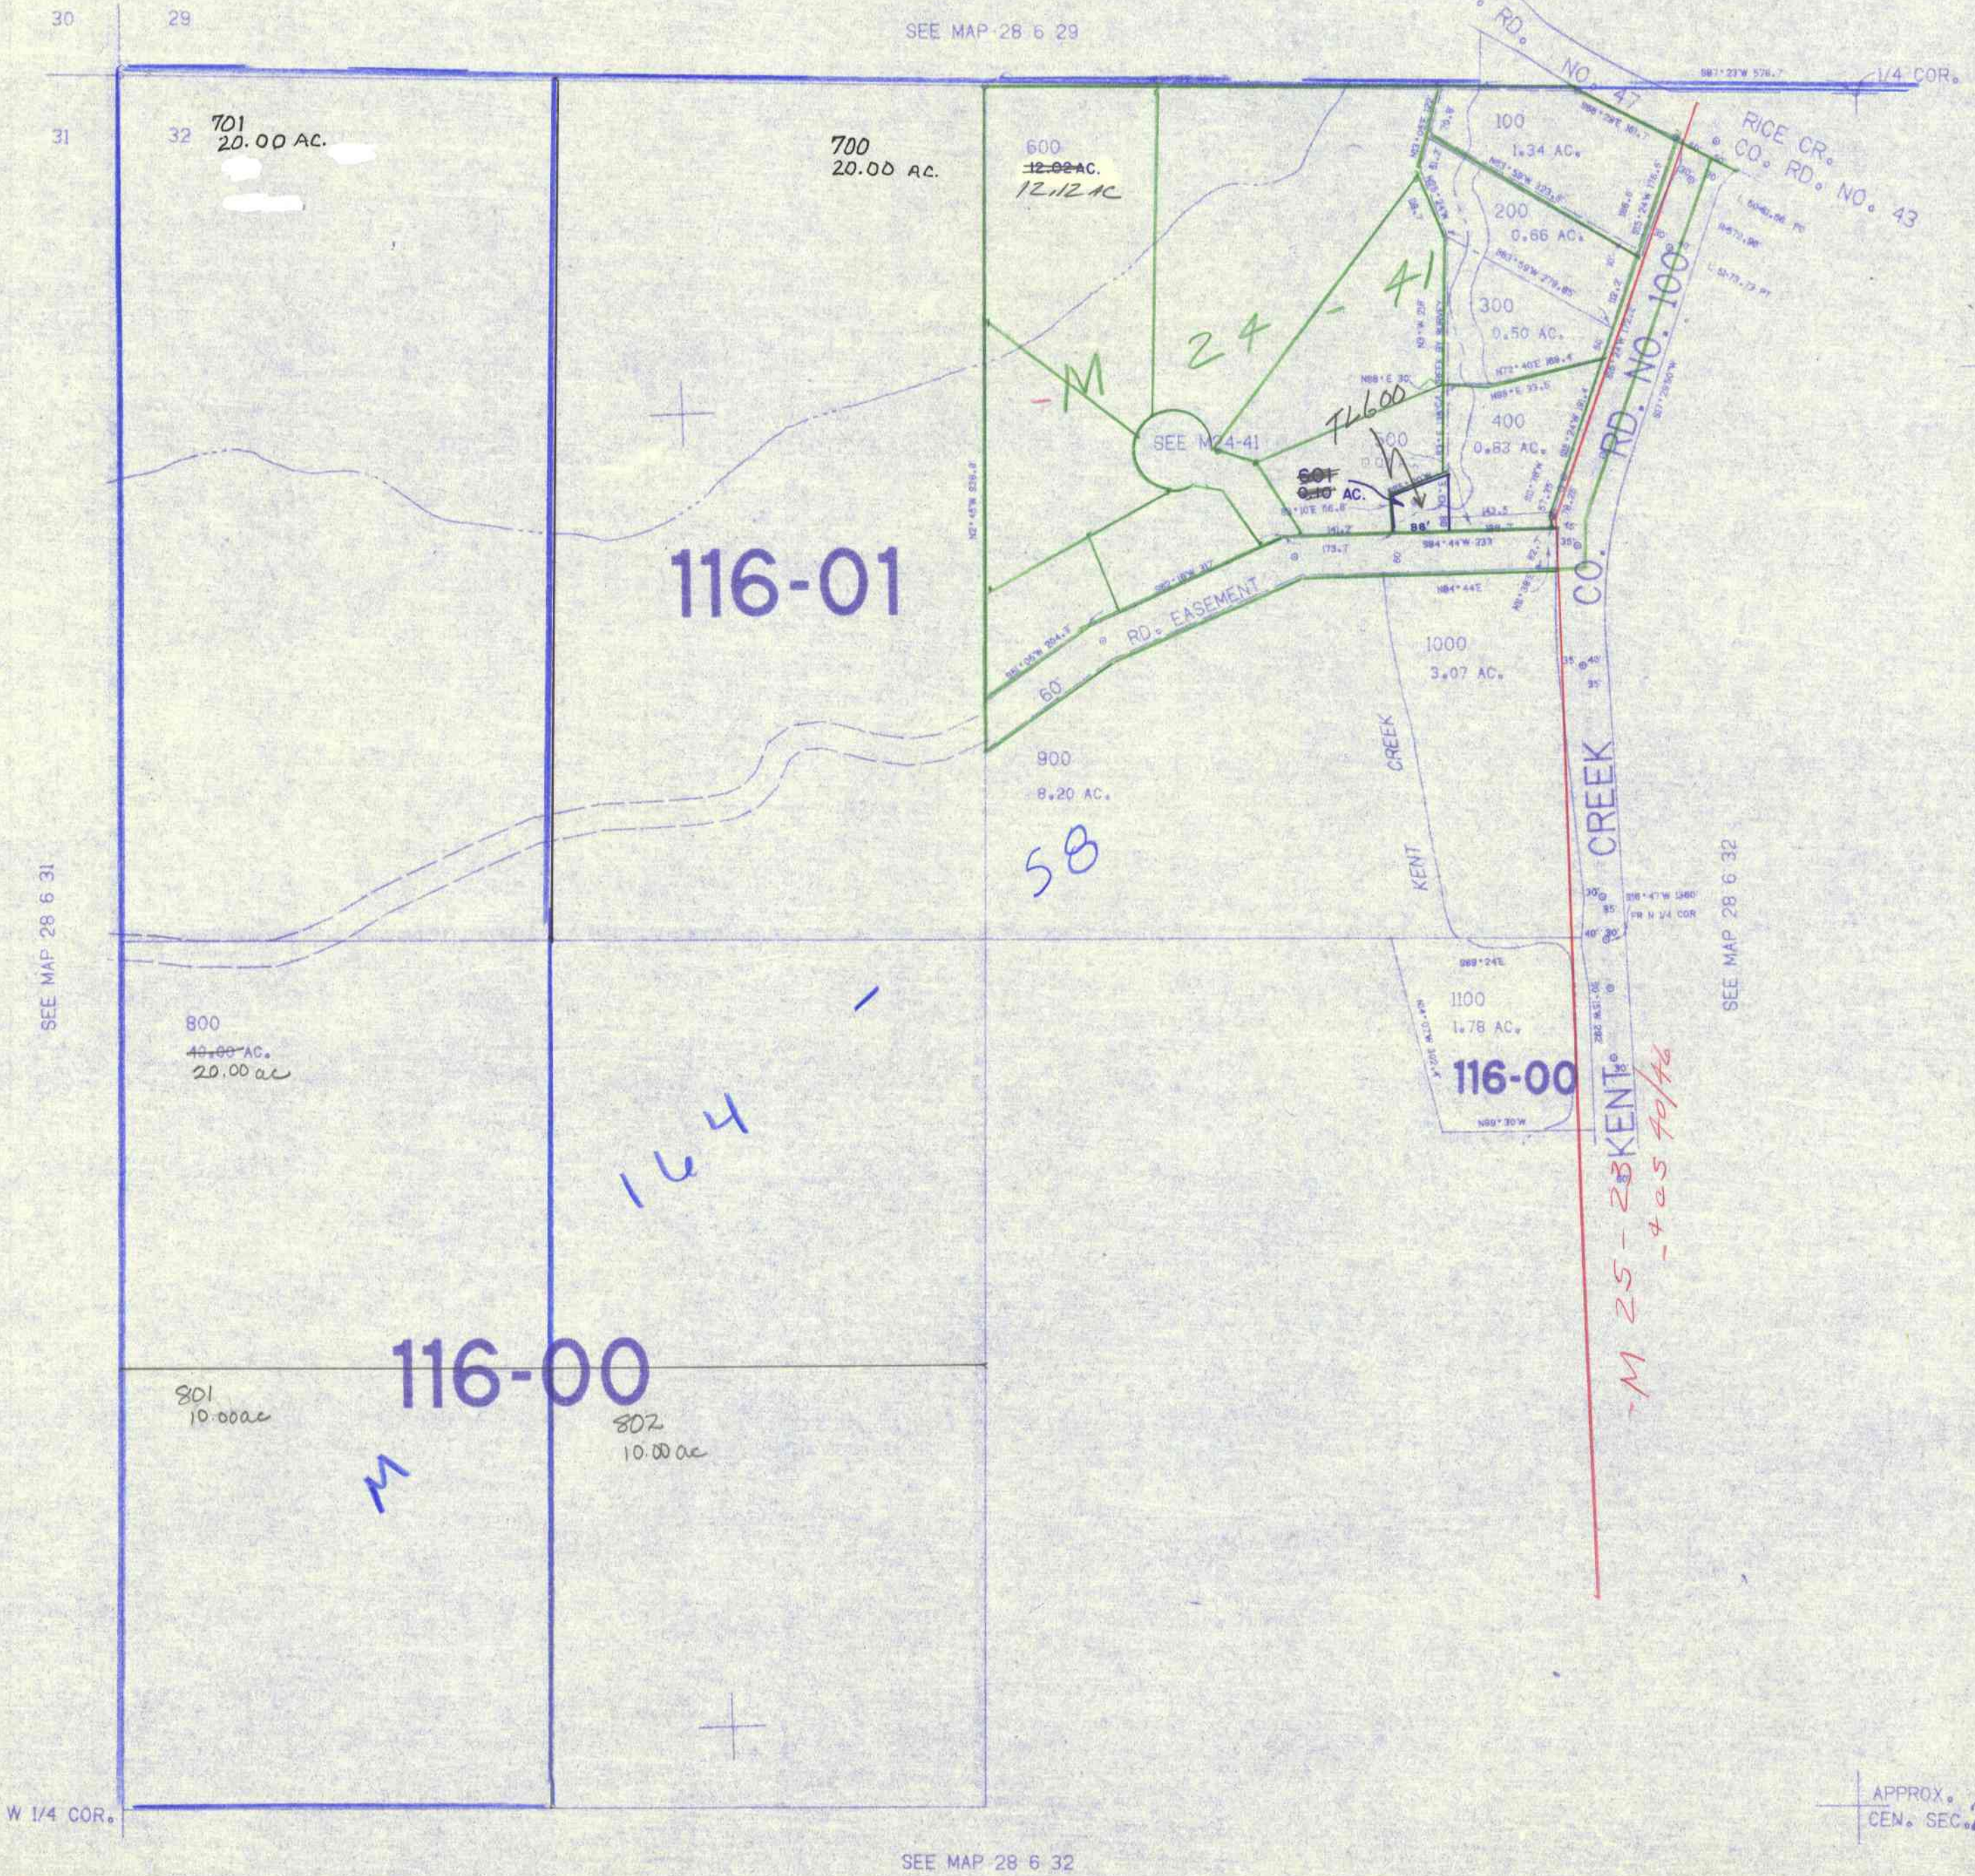

Cancelled
#s
TL 601

533,000

APPROX. CEN. SEC. 28 6 32B

SEE MAP 28 6 32

215,000

3/89

CONTROL LAYOUT TRACED CHECKED