

THIS MAP WAS PREPARED FOR
ASSESSMENT PURPOSE ONLY.


SEE MAP 28 6 26D

1" = 200'

SEE MAP 28 6 35

SEE MAP 28 6 36

SEE MAP 28 6 35D

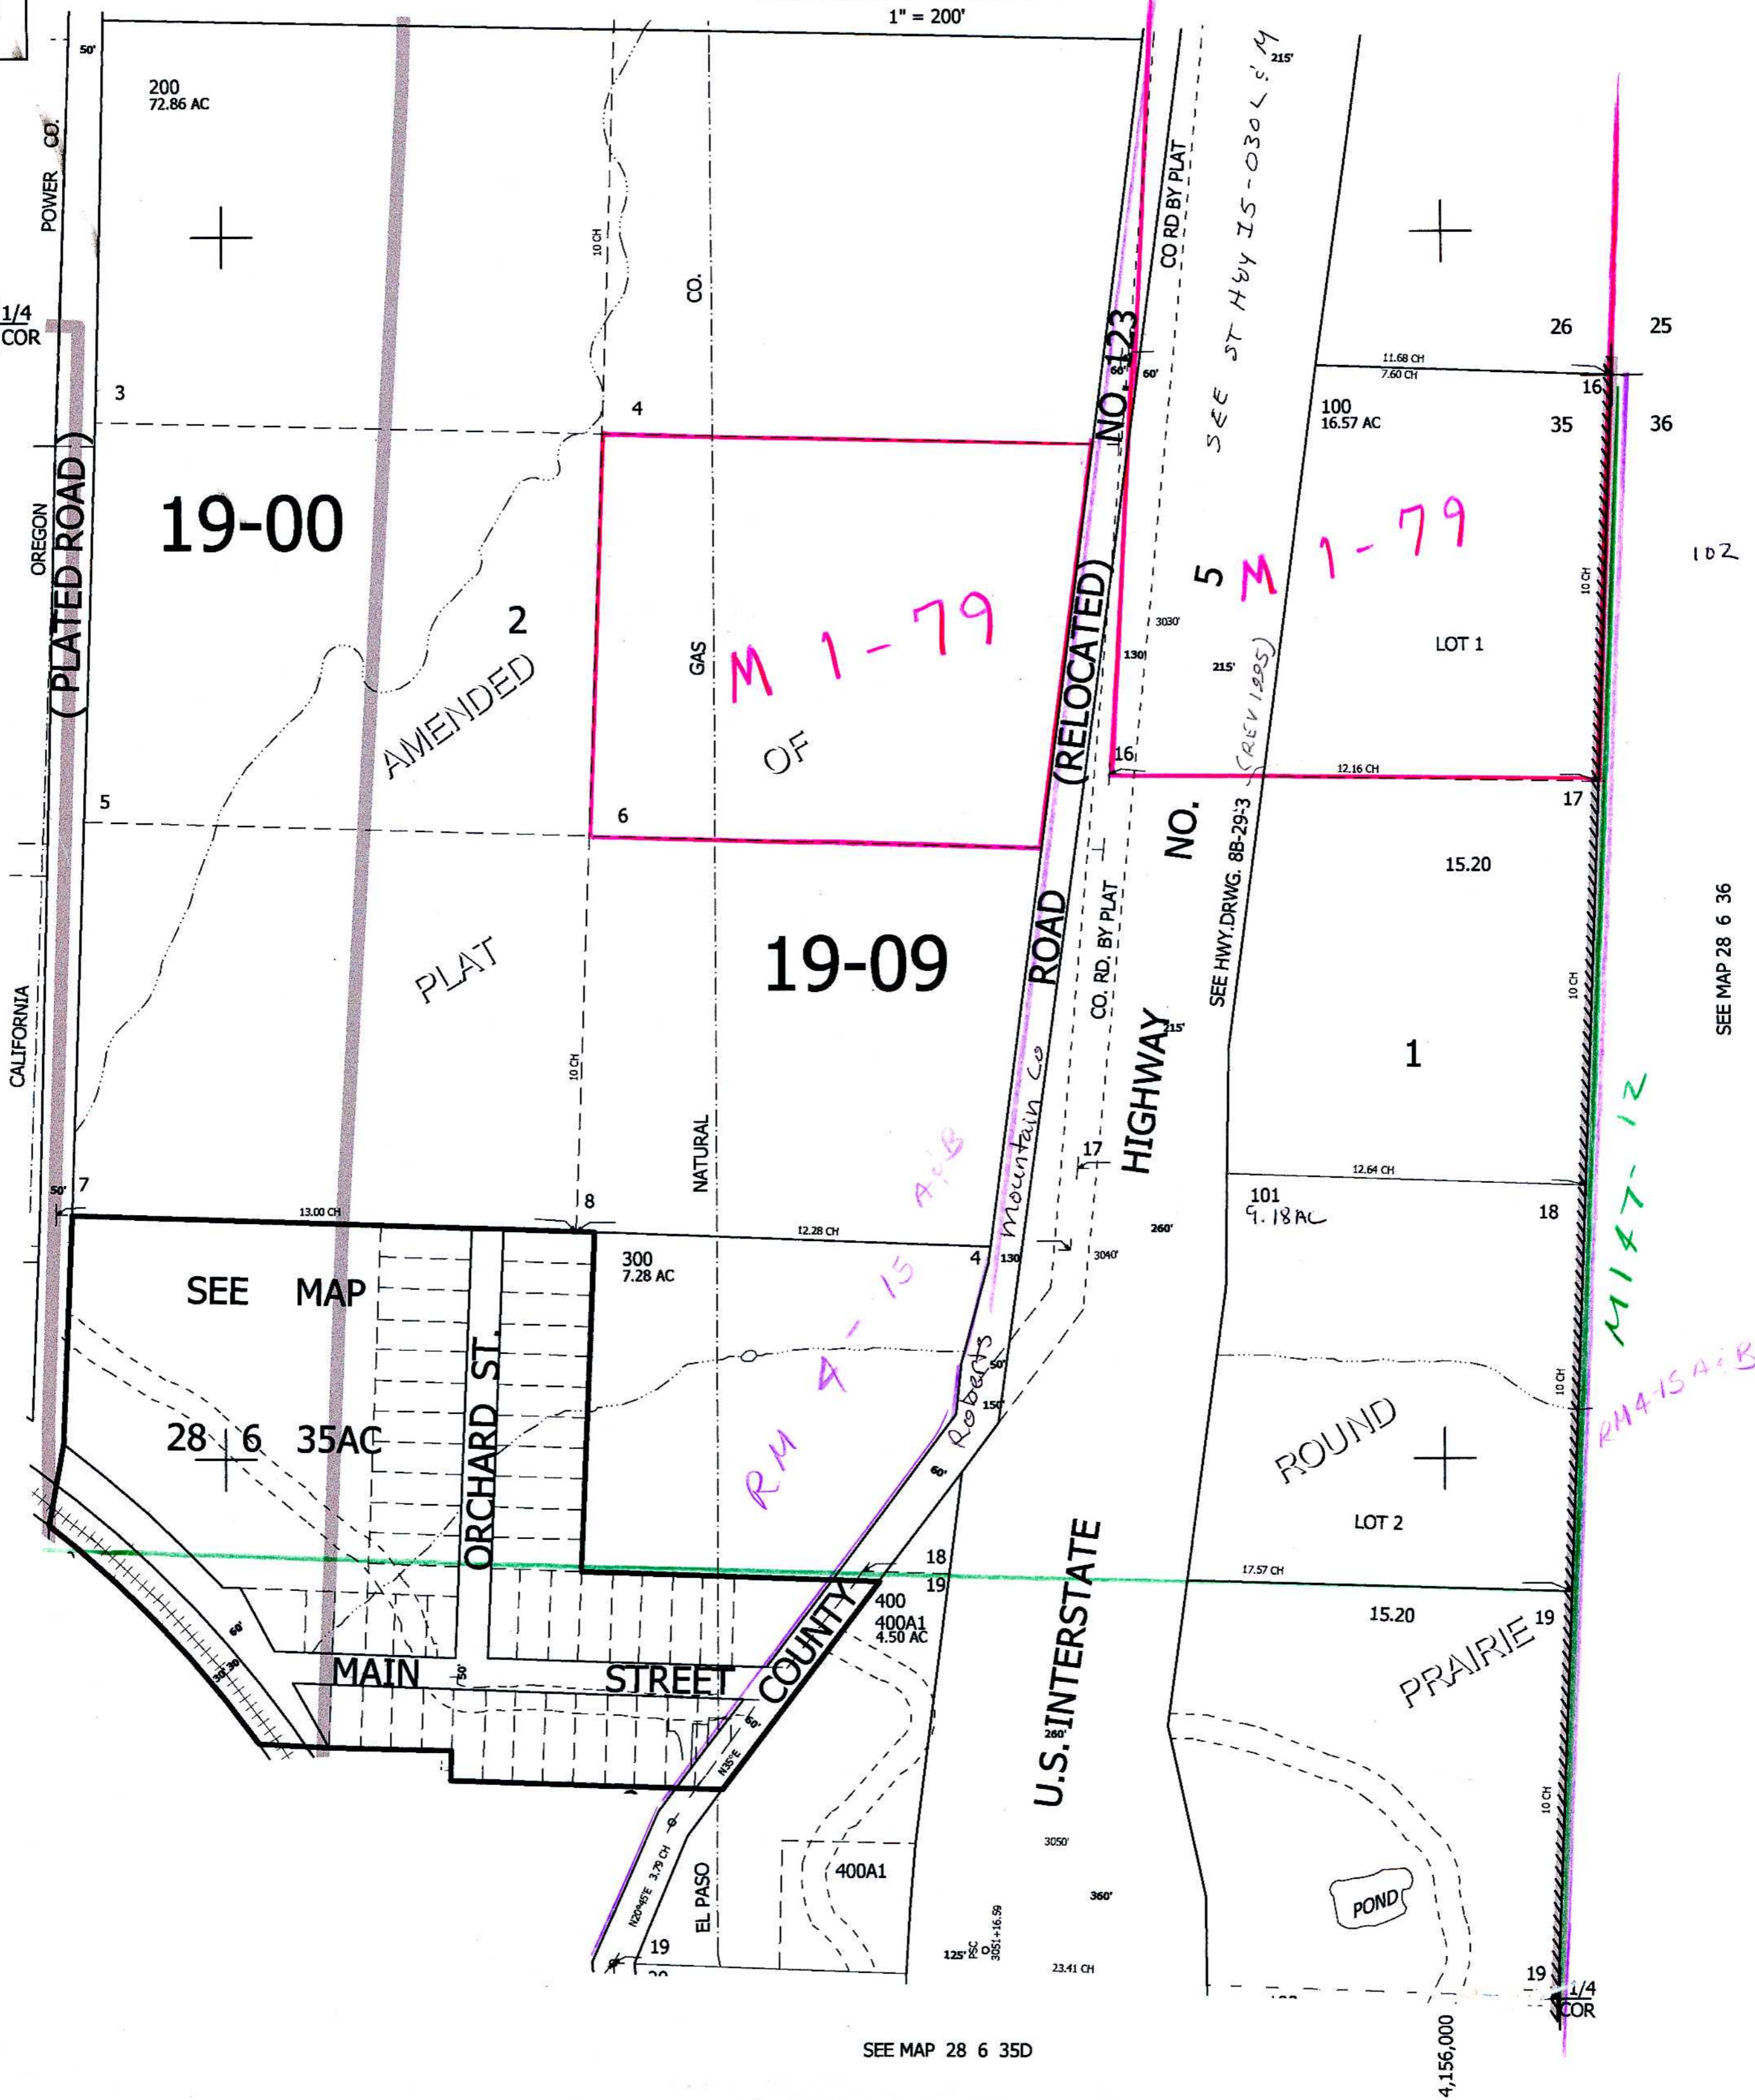

CANCELLED NO'S

533,000